


SOURCE:
 {MINNESOTA DEPARTMENT OF TRANSPORTATION}

STATE or COUNTY MAP
 (NOT TO SCALE)

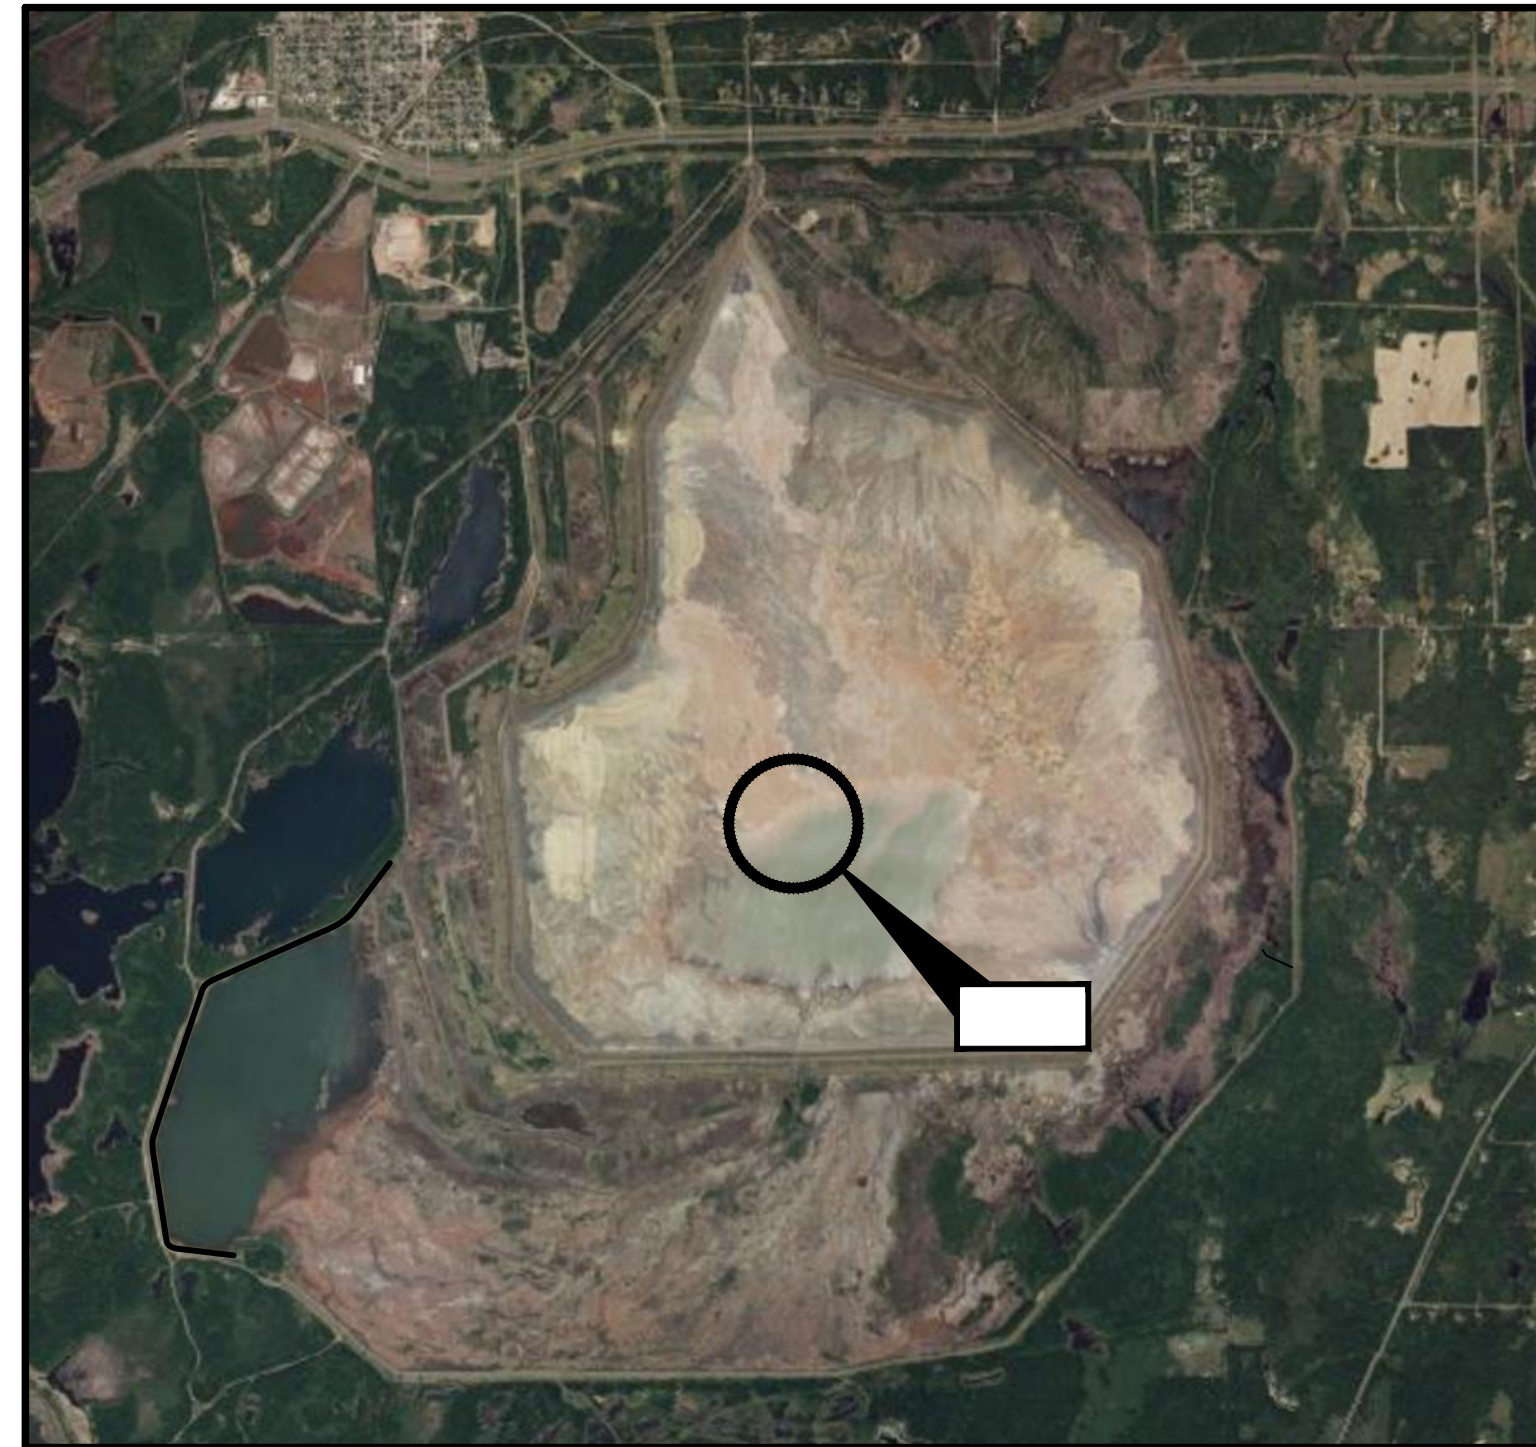

SOURCE:
 {AUTODESK CIVIL 3D}

66-75 WEST INTERIOR DIVERSION DIKE SECTION VIEWS

PREPARED FOR:
 UNITED STATES STEEL CORPORATION
 1 OLD MINE ROAD
 KEEWATIN, MN 55753
 (218) 778-8700








ELEVATIONS ARE REFERENCED TO NORTH
 AMERICAN VERTICAL DATUM 1988

AERIAL IMAGE FROM PRIOR TO CONSTRUCTION AND IS
 NOT REPRESENTATIVE OF FINAL PROFILES OR
 CONDITIONS


THIS DOCUMENT, AND THE IDEAS AND DESIGNS INCORPORATED
 HEREIN, IS AN INSTRUMENT OF PROFESSIONAL SERVICE, IS THE
 PROPERTY OF GEI CONSULTANTS AND IS NOT TO BE USED, IN WHOLE
 OR IN PART, FOR ANY OTHER PROJECT WITHOUT THE WRITTEN
 AUTHORIZATION OF GEI CONSULTANTS.

4	1/14/2024	RECORD DRAWINGS	JPB		

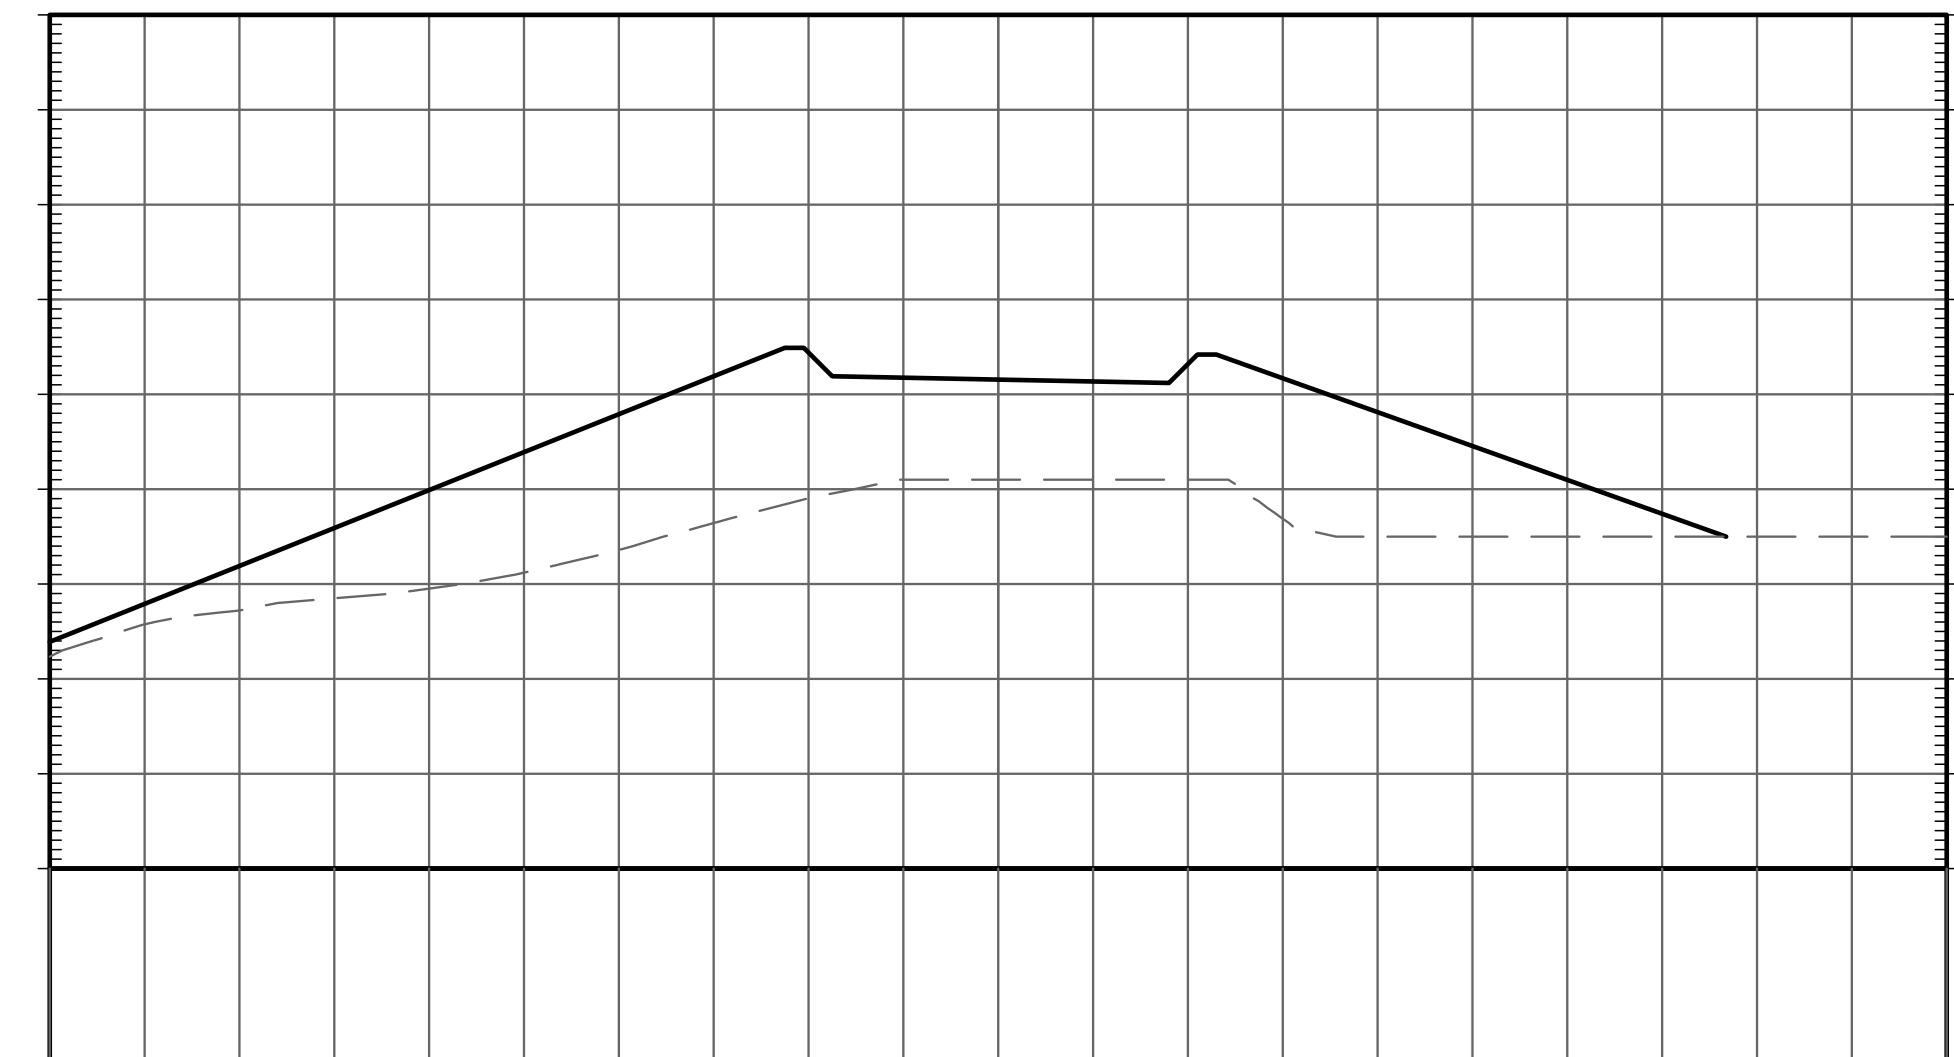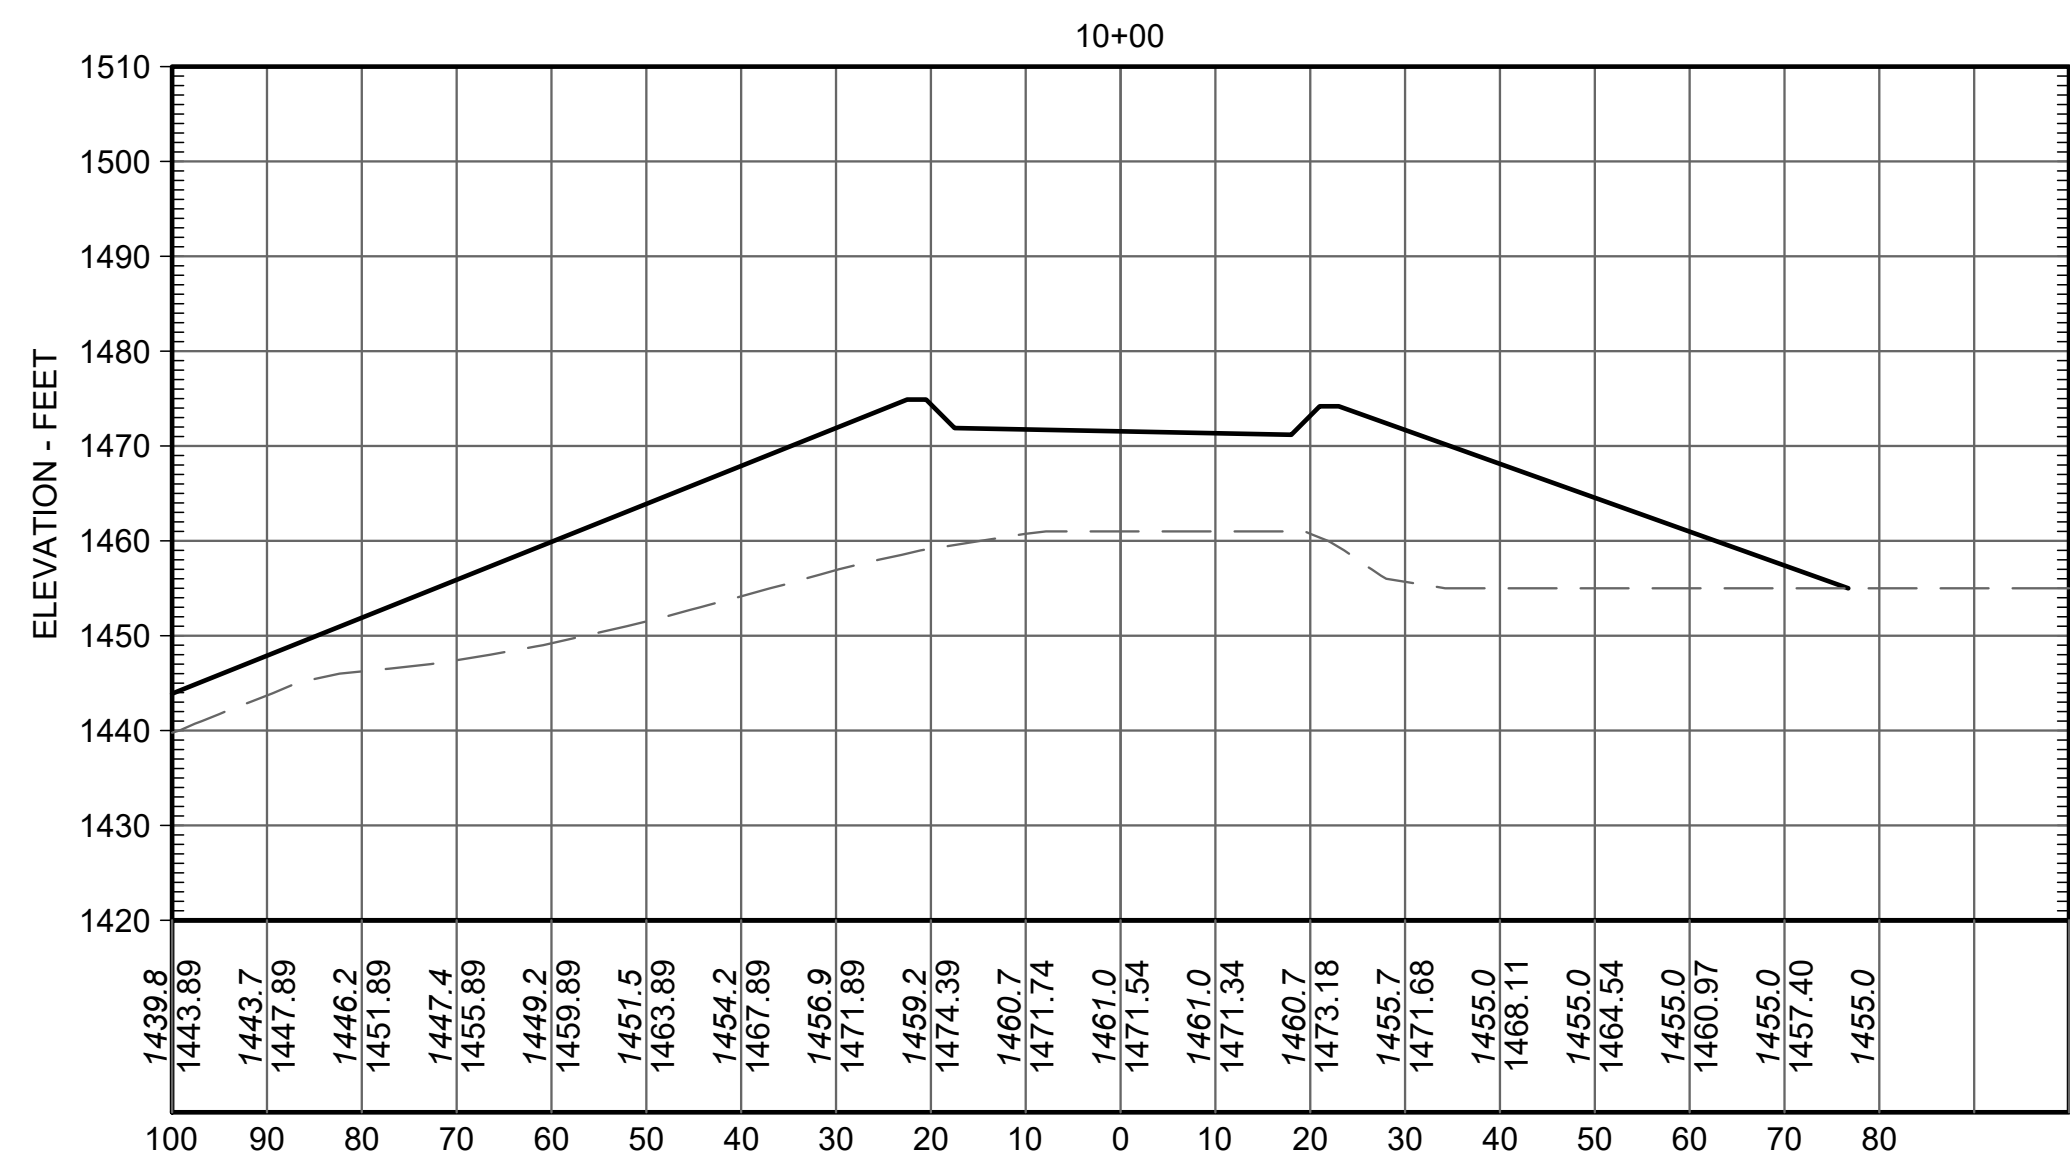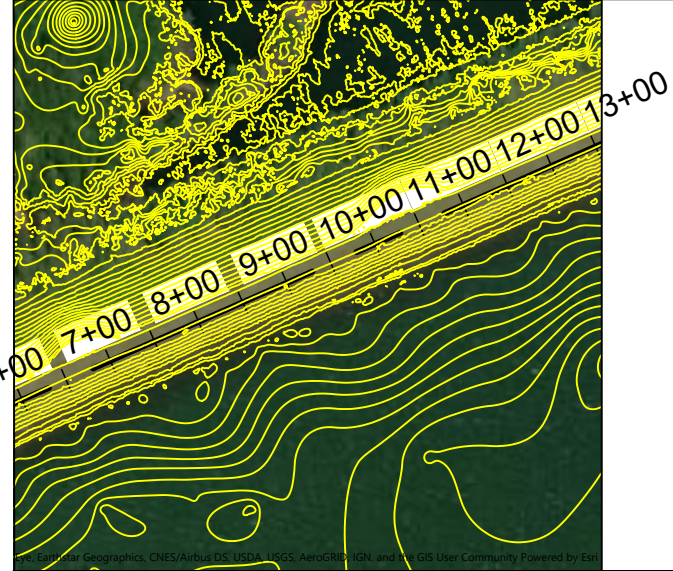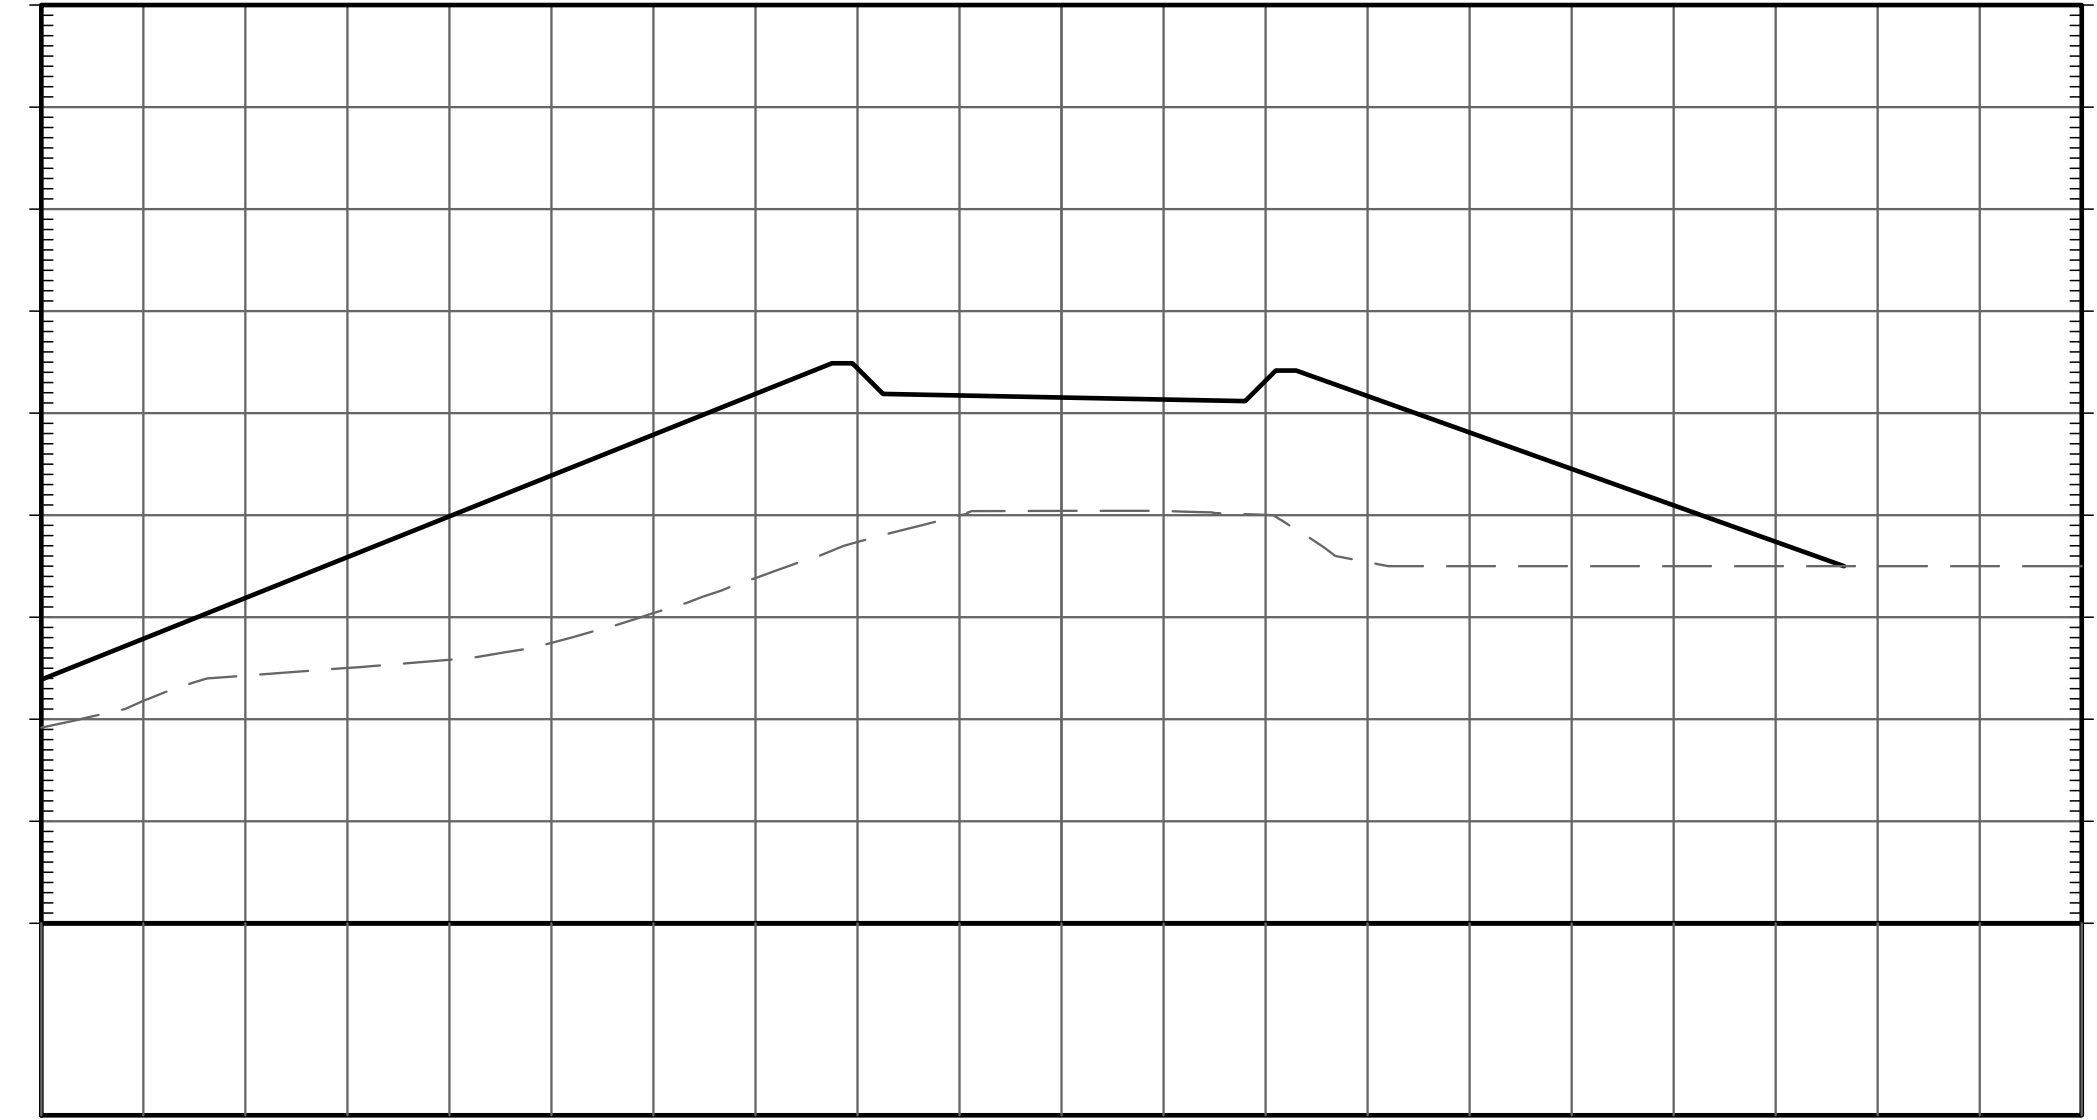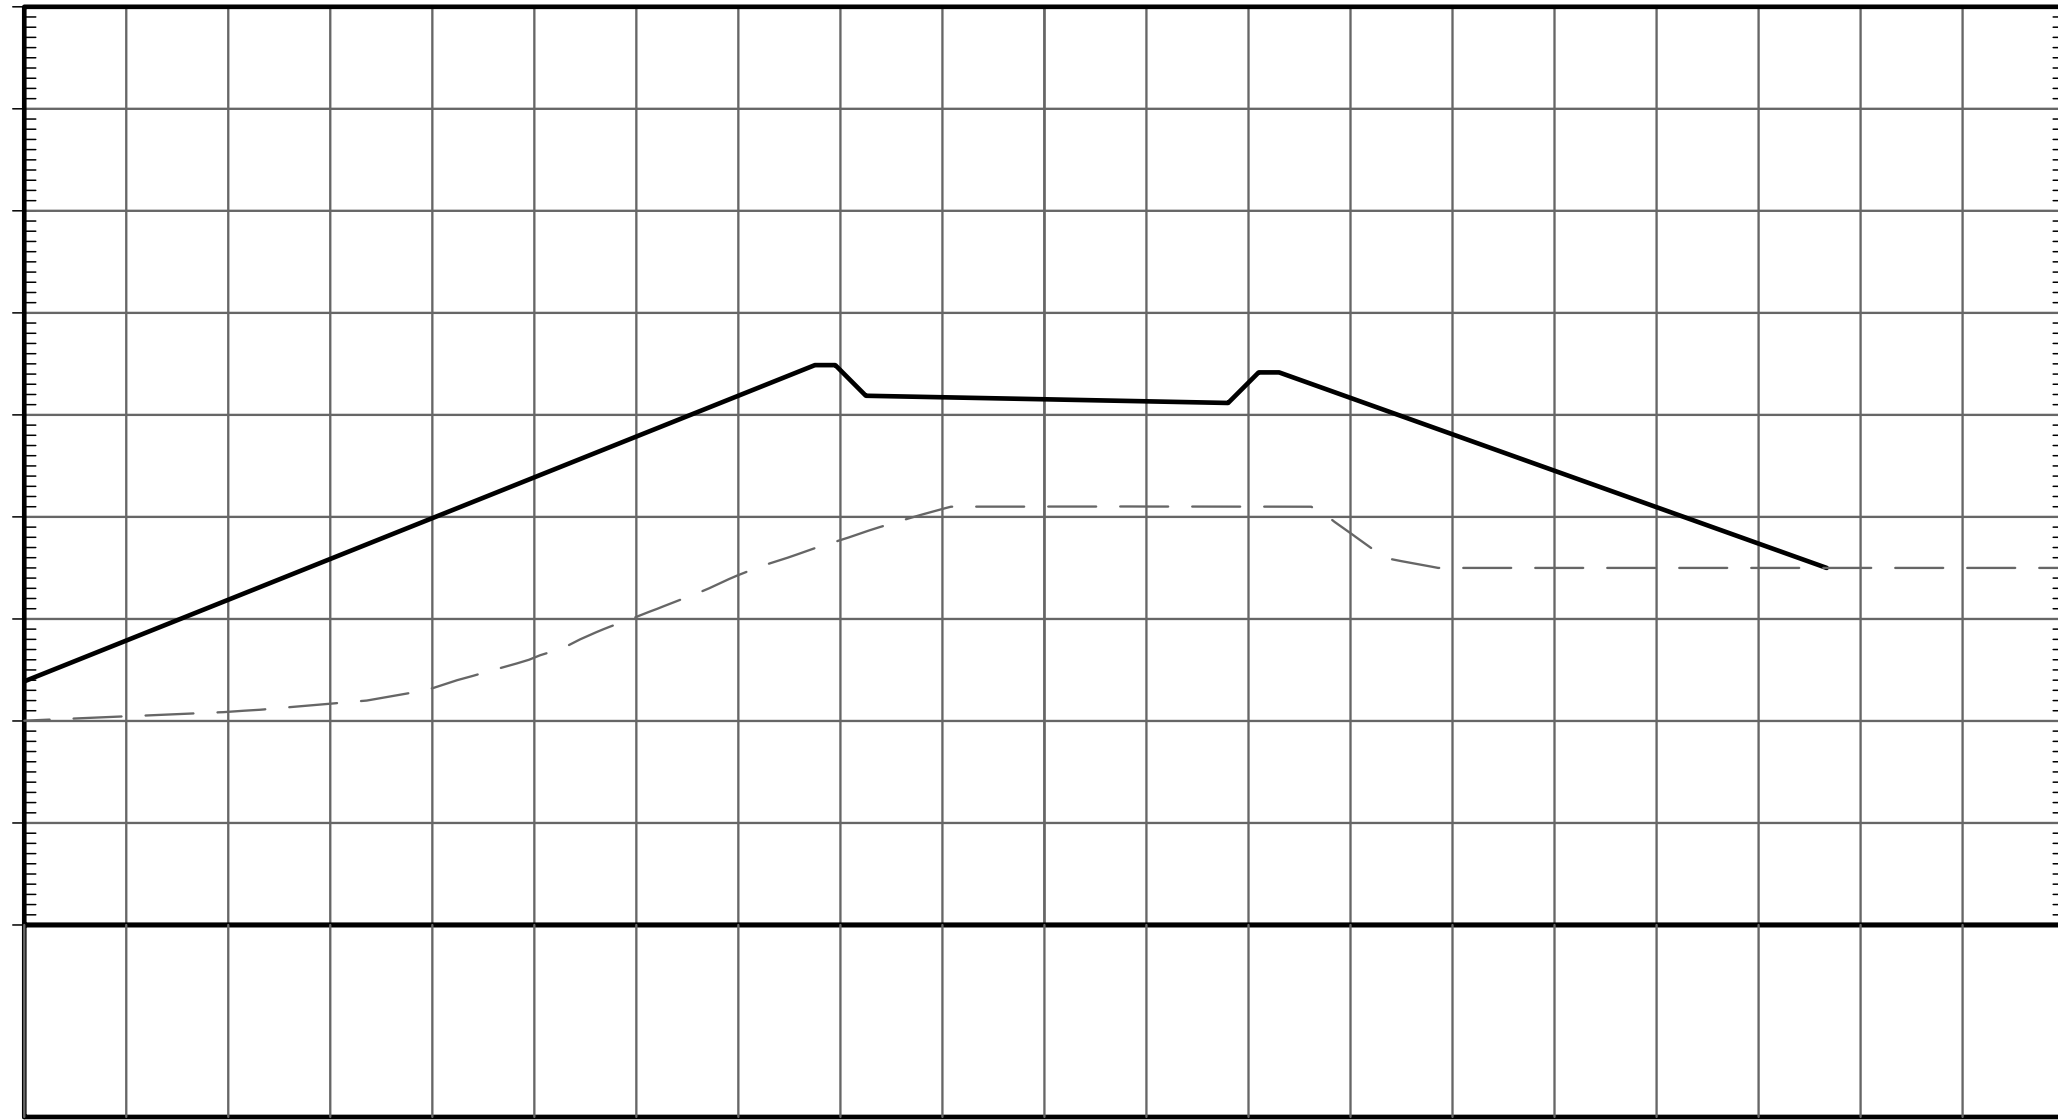






ELEVATIONS ARE REFERENCED TO NORTH AMERICAN VERTICAL DATUM 1988

AERIAL IMAGE FROM PRIOR TO CONSTRUCTION AND IS NOT REPRESENTATIVE OF FINAL PROFILES OR CONDITIONS

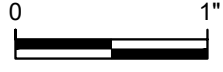Attention:

 If this scale bar does not measure 1" then drawing is not original scale.

Designed: BJJ
 Drawn: BJJ
 Checked: JPB
 Approved: JPB
 P.E. No: 40594
 GEI Project 2300038

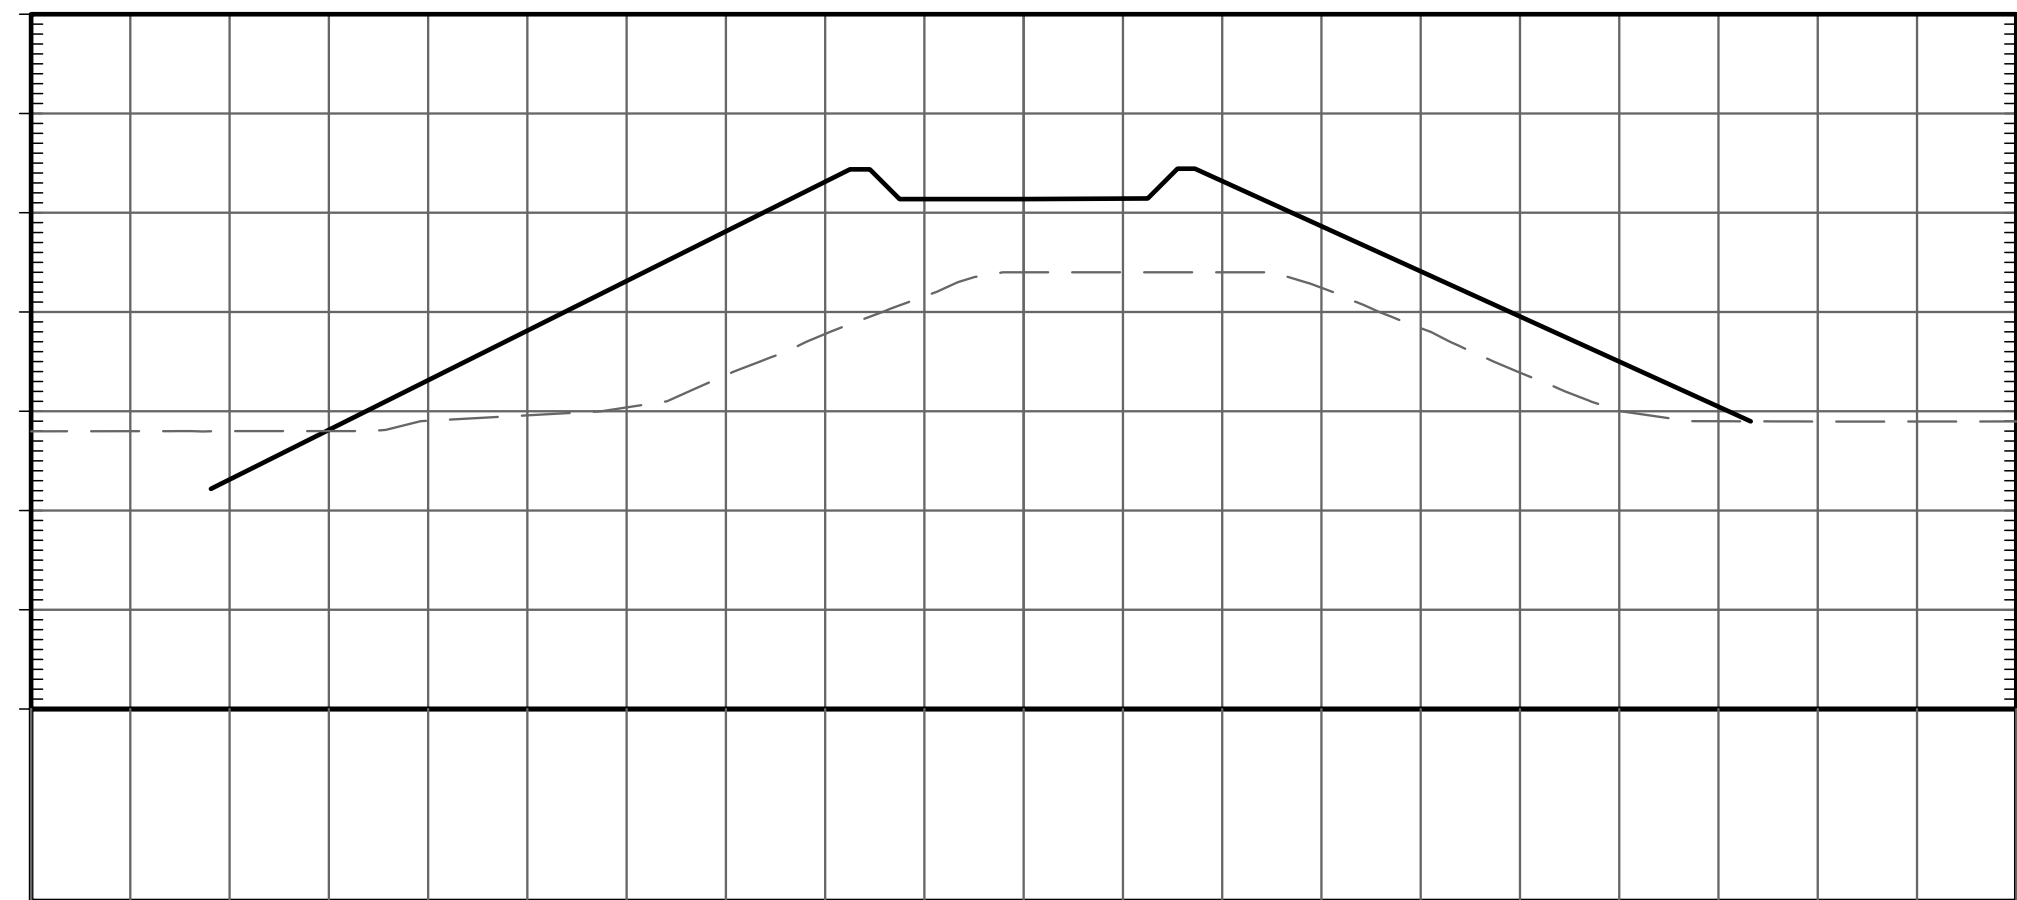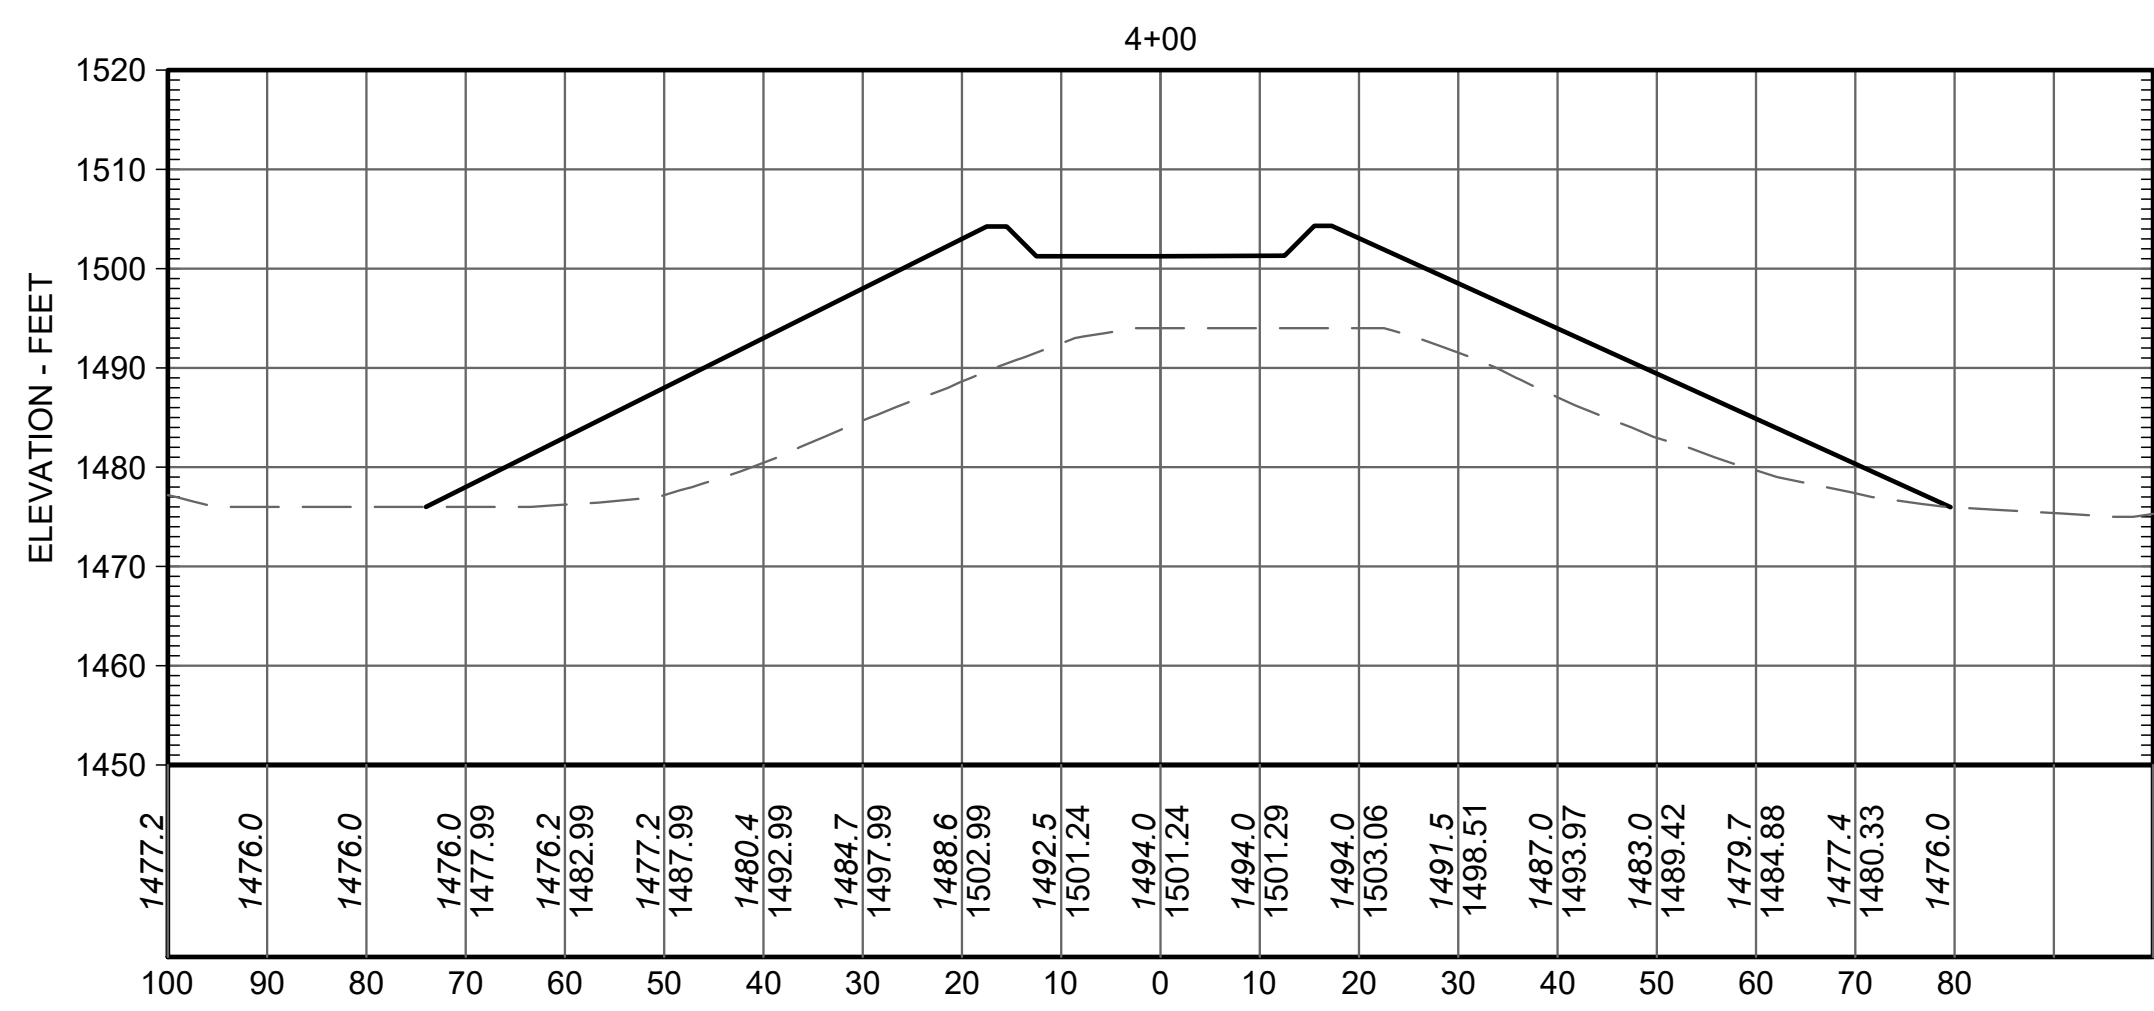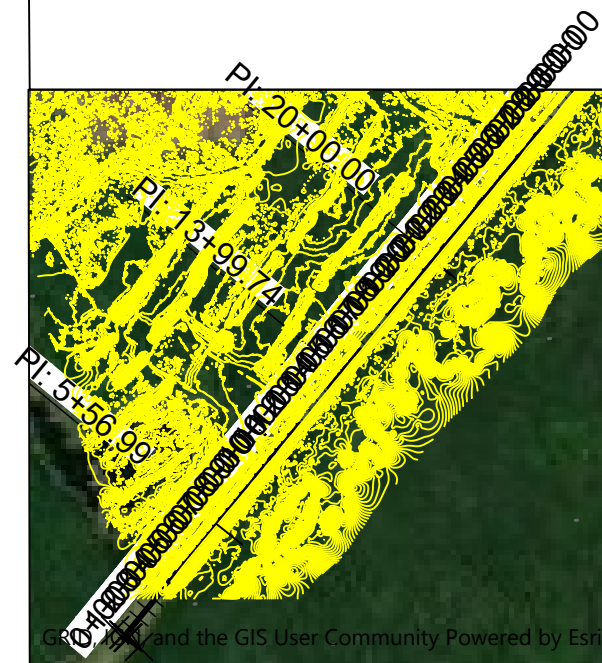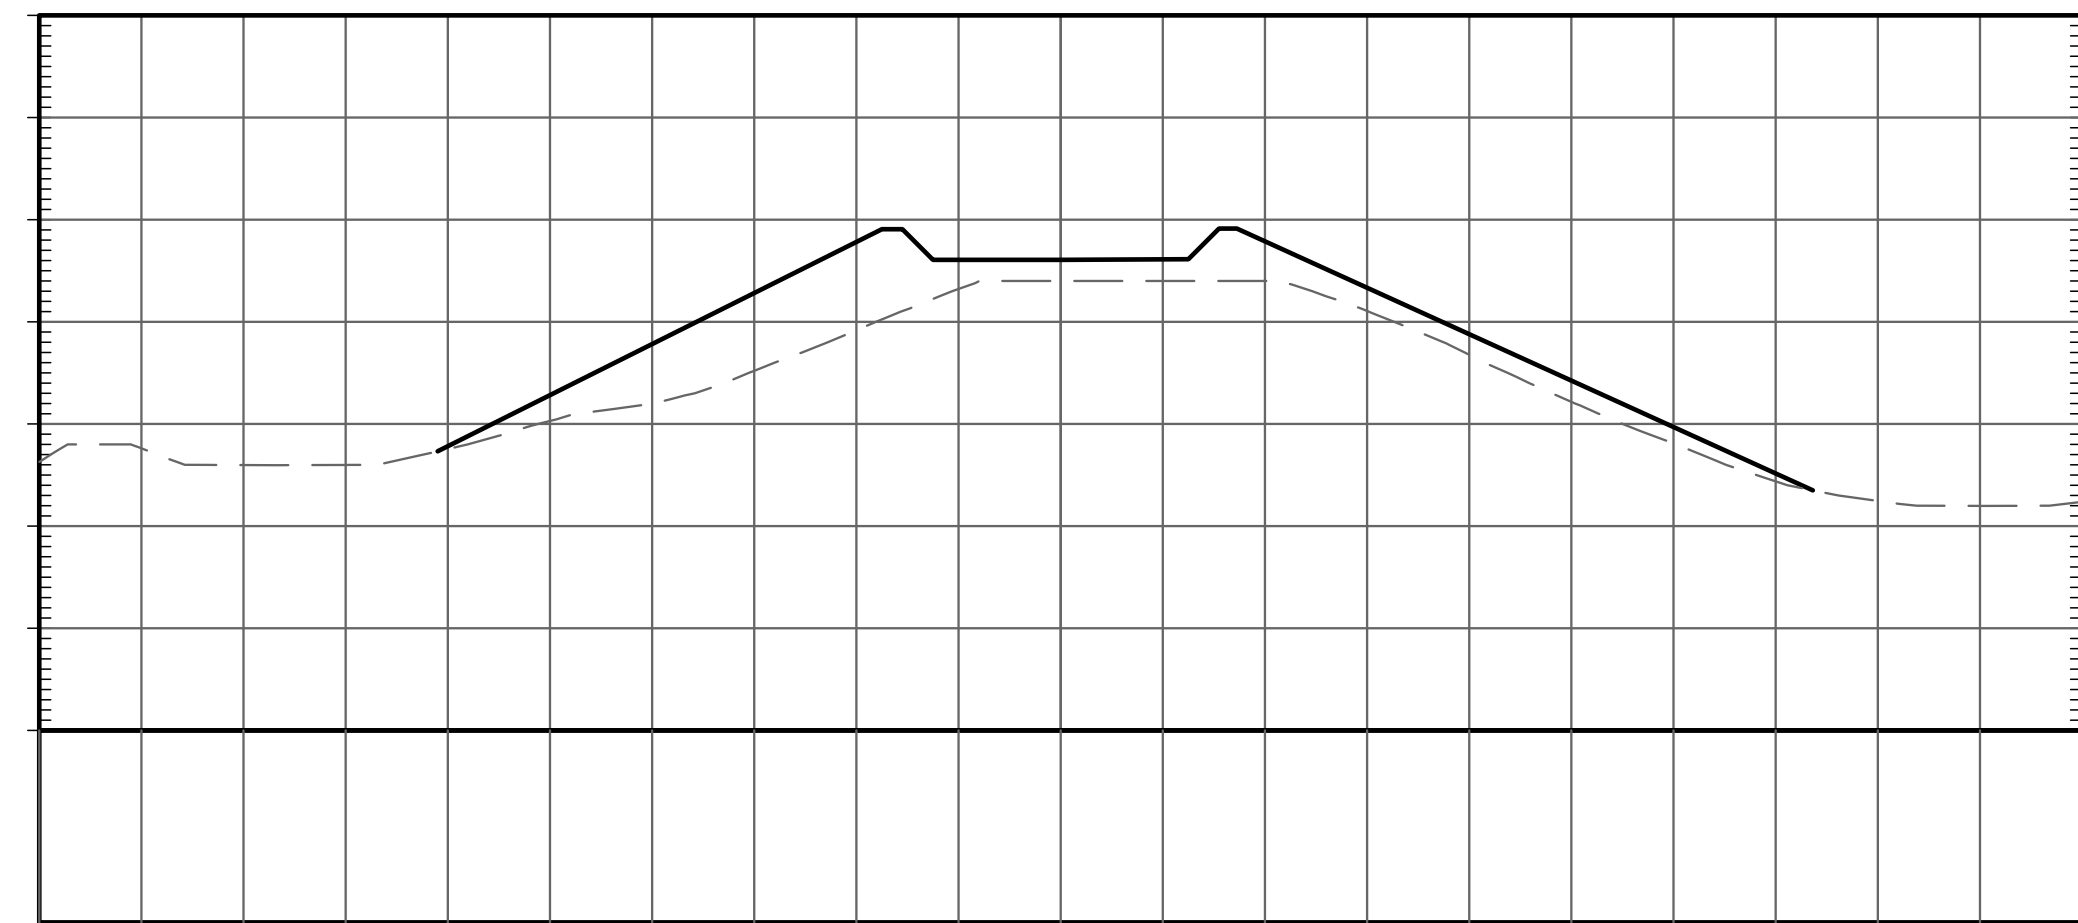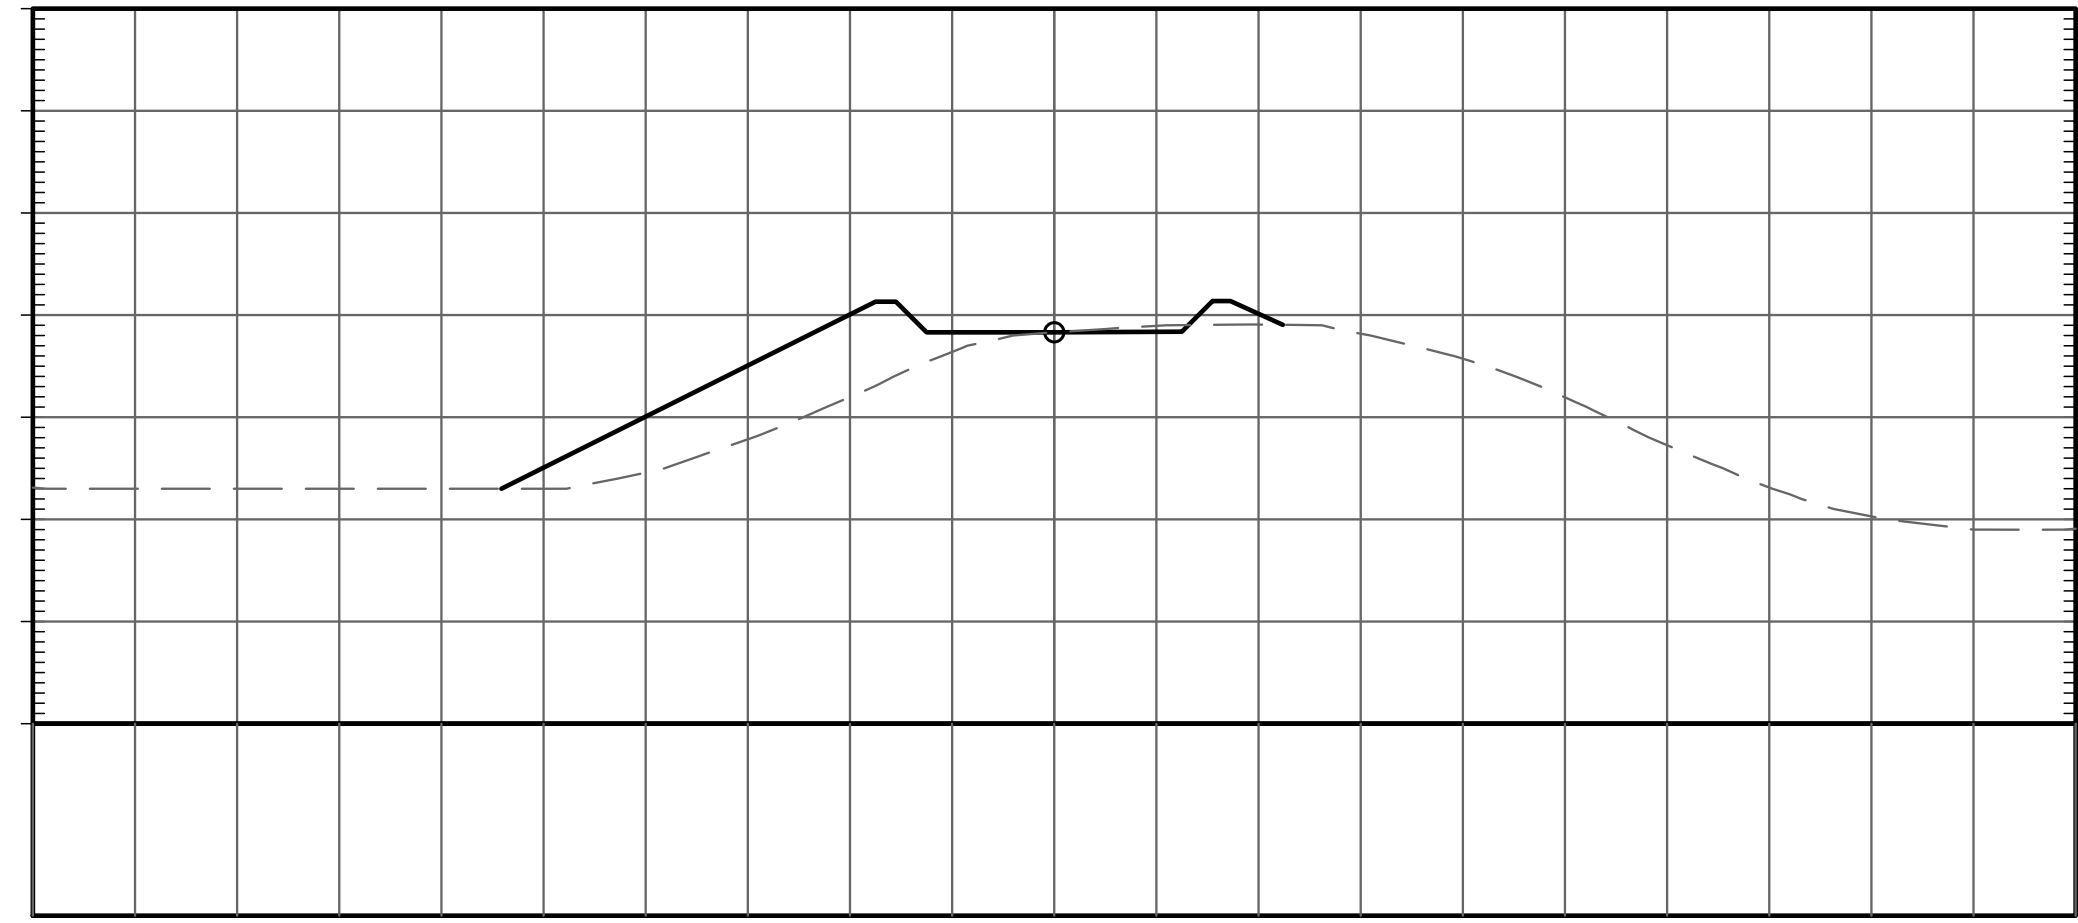








ELEVATIONS ARE REFERENCED TO NORTH AMERICAN VERTICAL DATUM 1988

AERIAL IMAGE FROM PRIOR TO CONSTRUCTION AND IS NOT REPRESENTATIVE OF FINAL PROFILES OR CONDITIONS


<p>Attention:</p> <p>If this scale bar does not measure 1" then drawing is not original scale.</p>	Designed: BJJ
	Drawn: BJJ
	Checked: JPB
	Approved: JPB
	P.E. No: 40594
GEI Project 2300038	



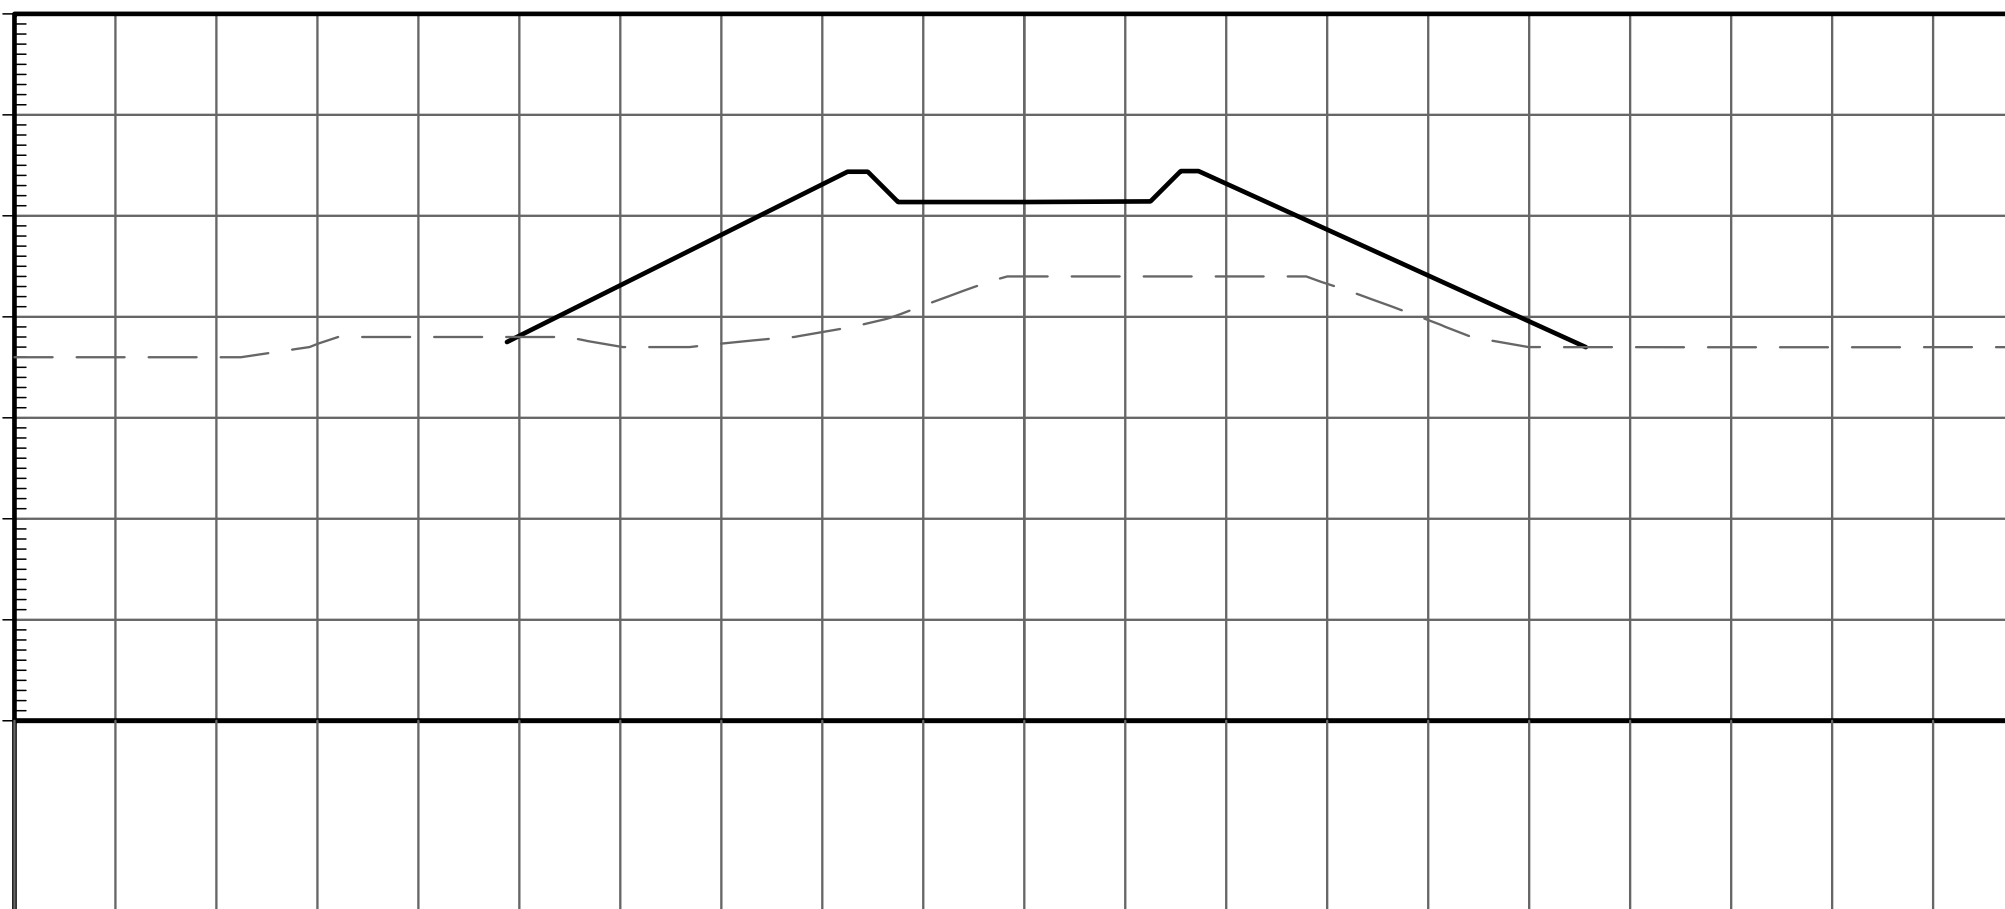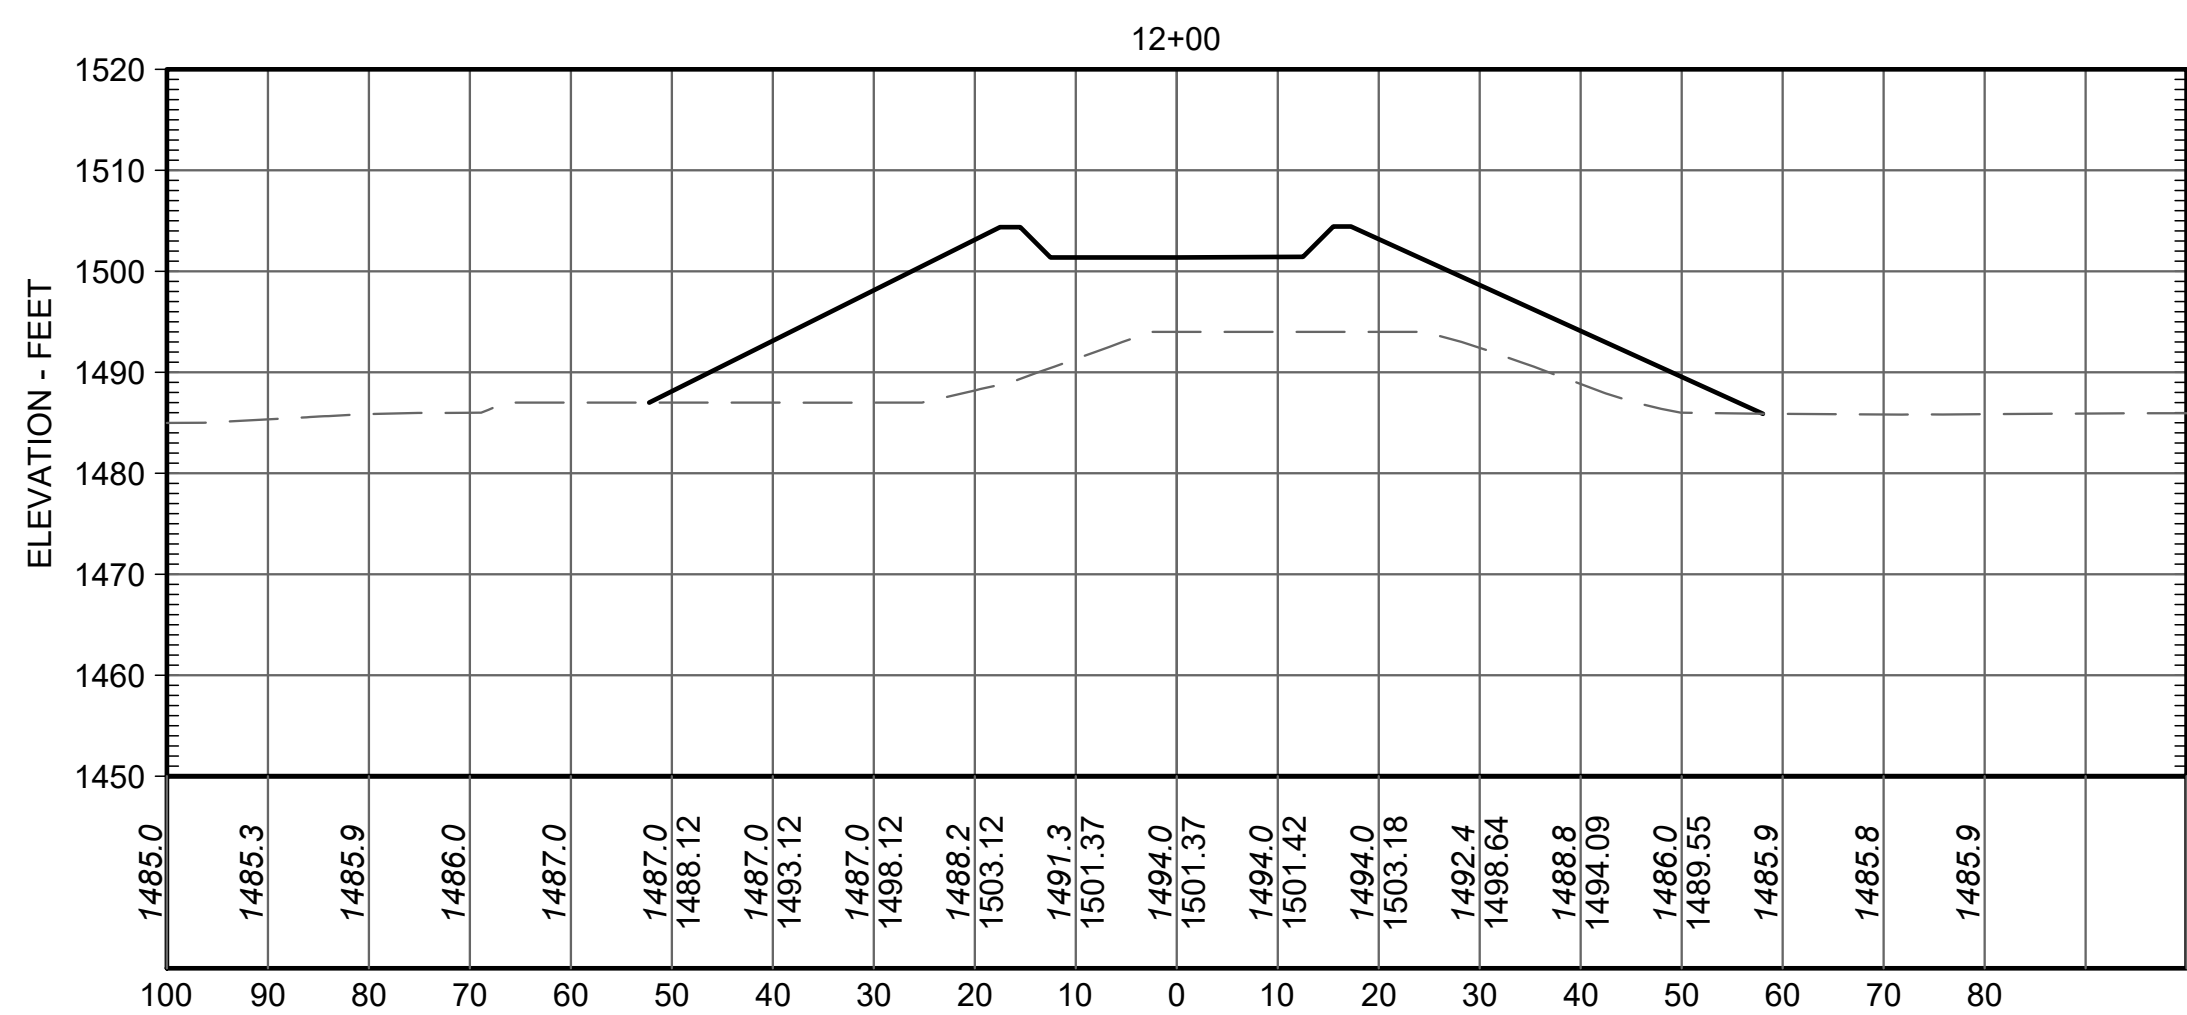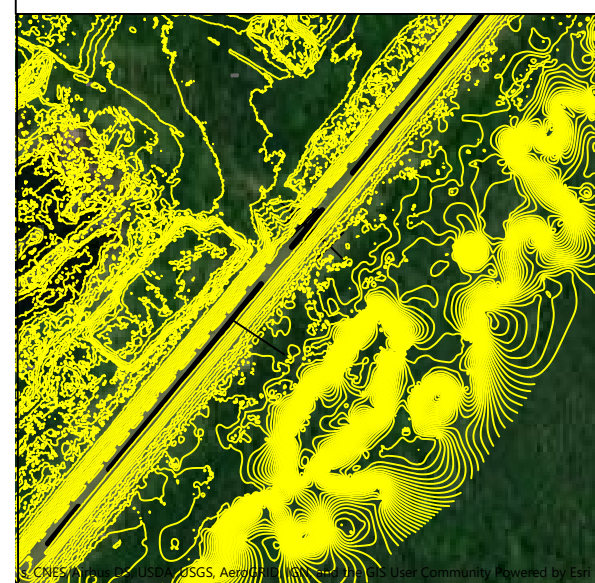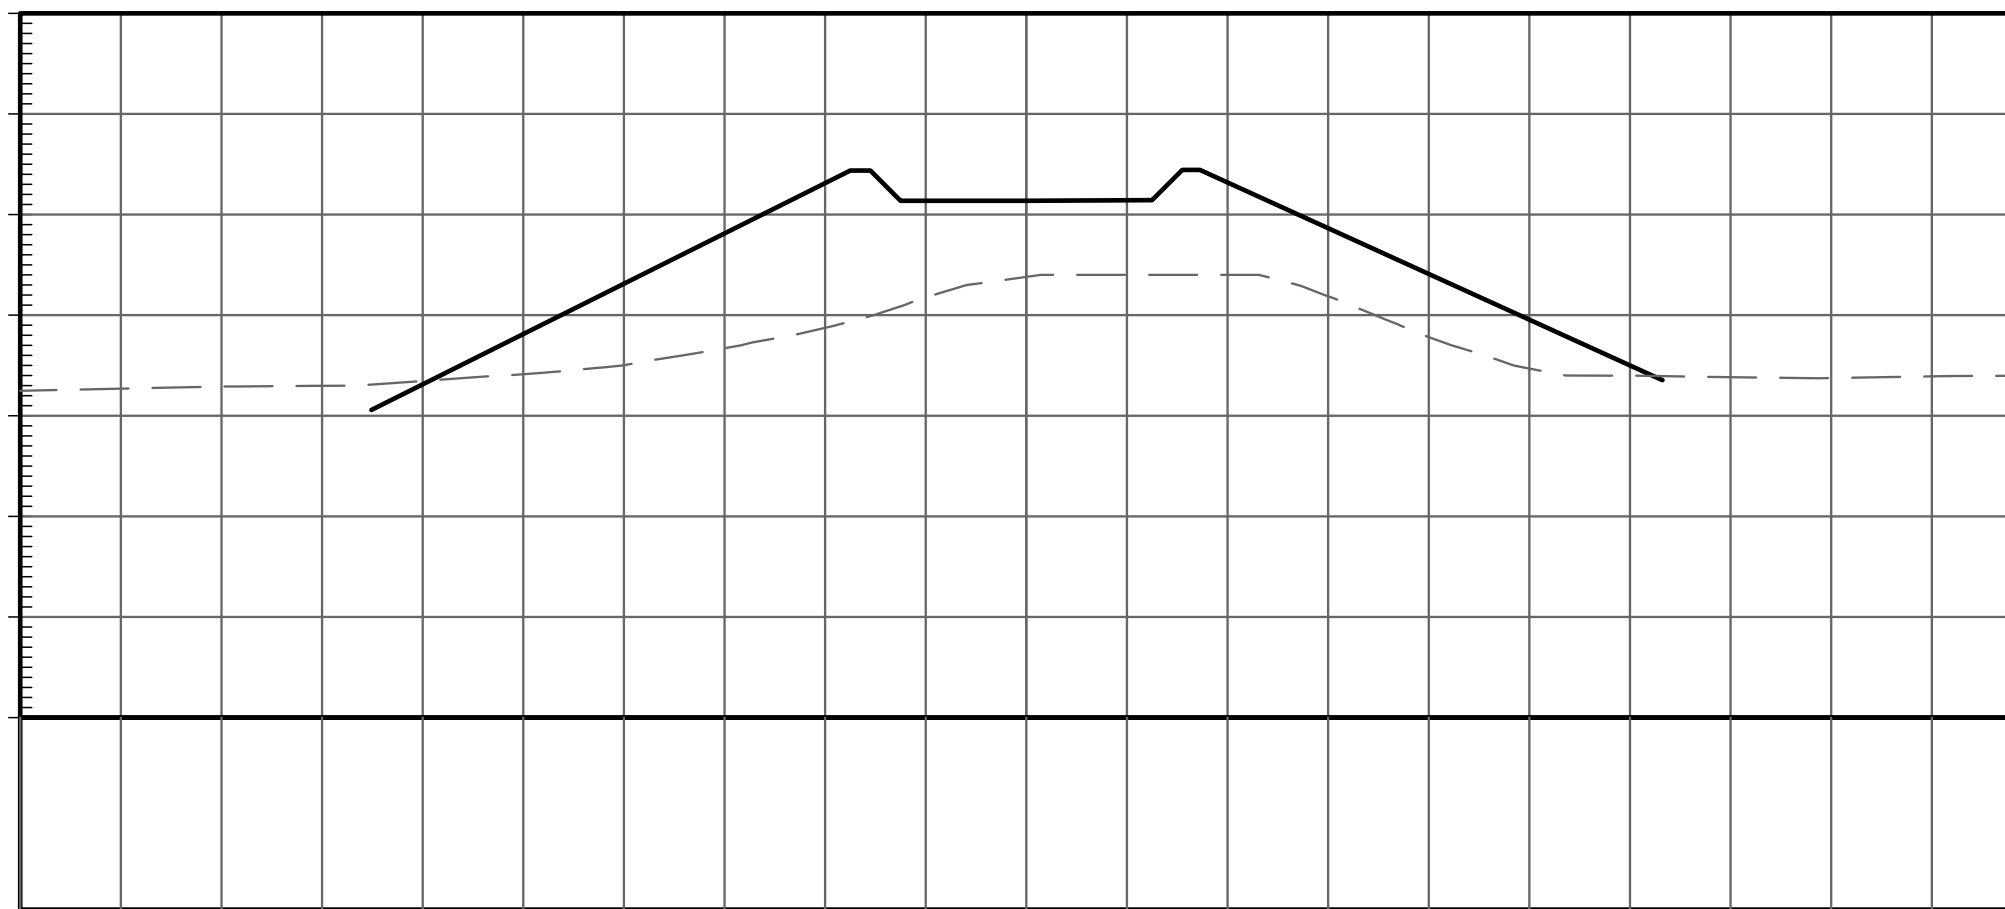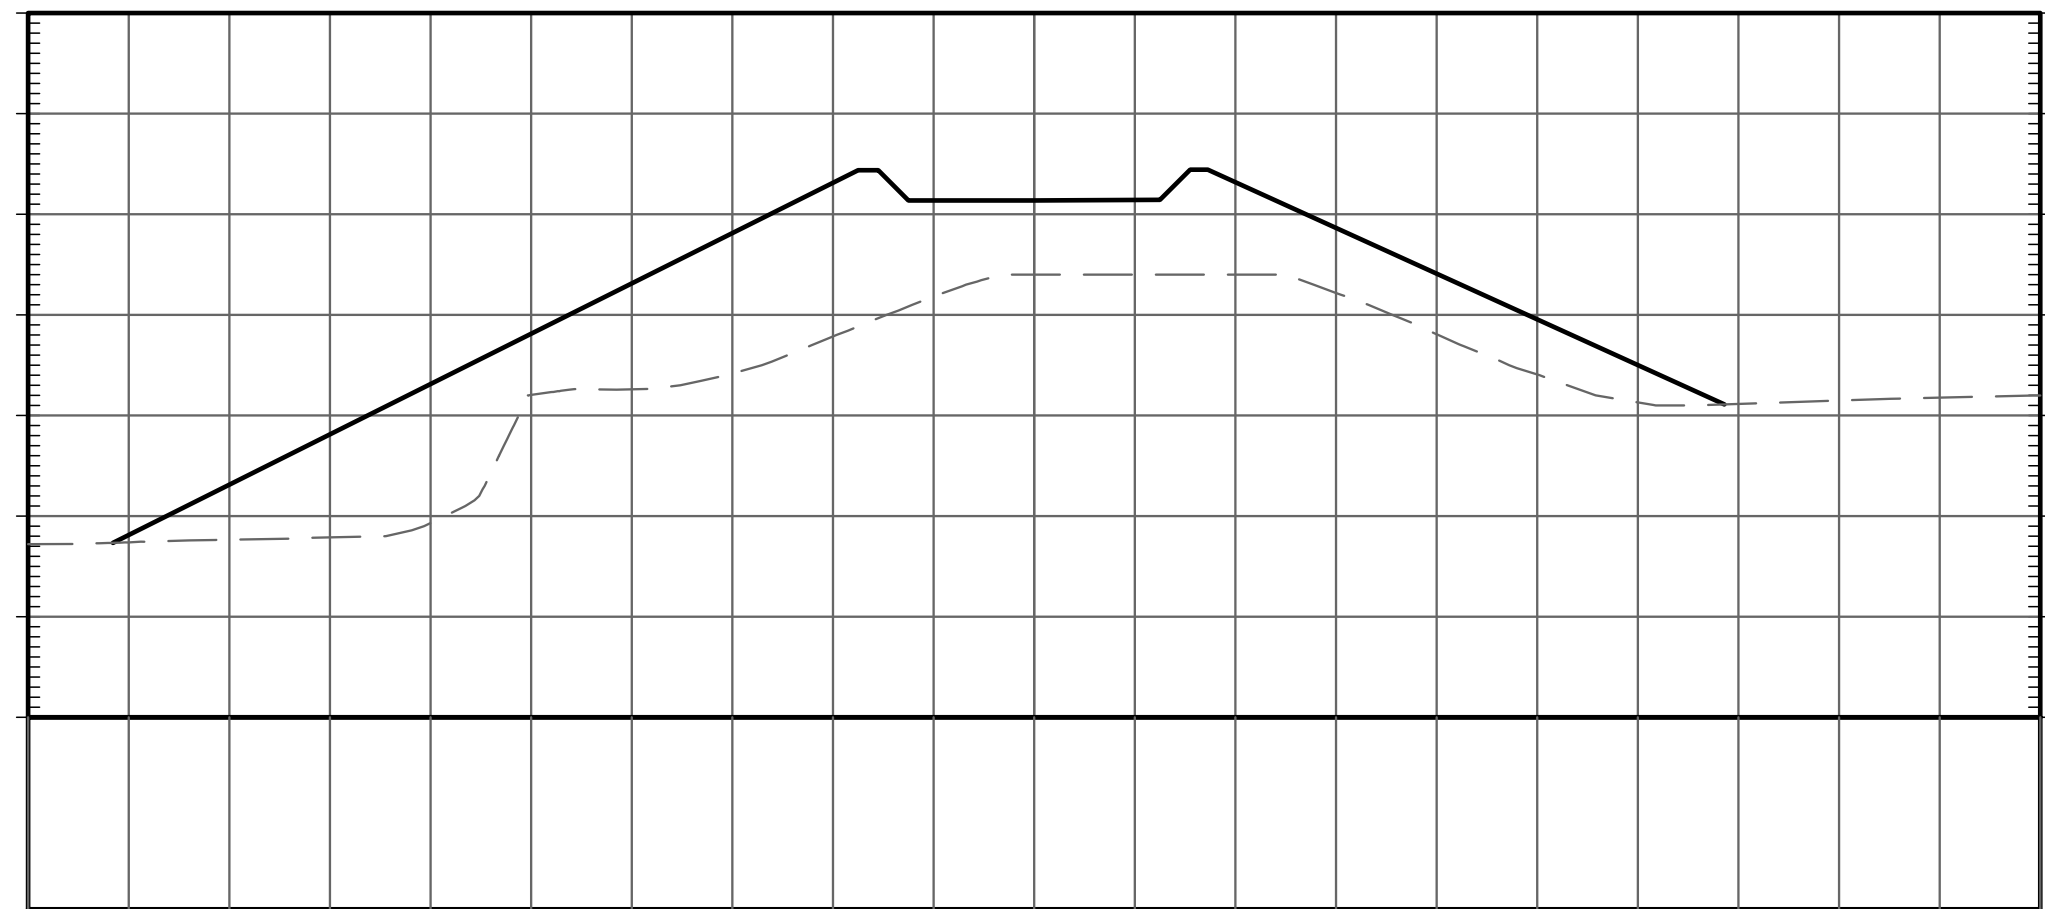

ELEVATIONS ARE REFERENCED TO NORTH AMERICAN VERTICAL DATUM 1988

AERIAL IMAGE FROM PRIOR TO CONSTRUCTION AND IS NOT REPRESENTATIVE OF FINAL PROFILES OR CONDITIONS





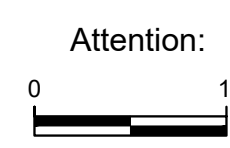


If this scale bar does not measure 1" then drawing is not original scale.

<i>Designed:</i>	BJF
<i>Drawn:</i>	BJF
<i>Checked:</i>	JPB
<i>Approved:</i>	JPB
<i>P.E. No.:</i>	40594
<i>GEI Project:</i>	2300038




FEARING, BRIAN B:\Working\UNITED STATES STEEL CORPORATION\240917 Phase I (2024) DNE Construction\00_CADD\Design\Civil\Kreutz, 2023.dwg - 1/13/2025

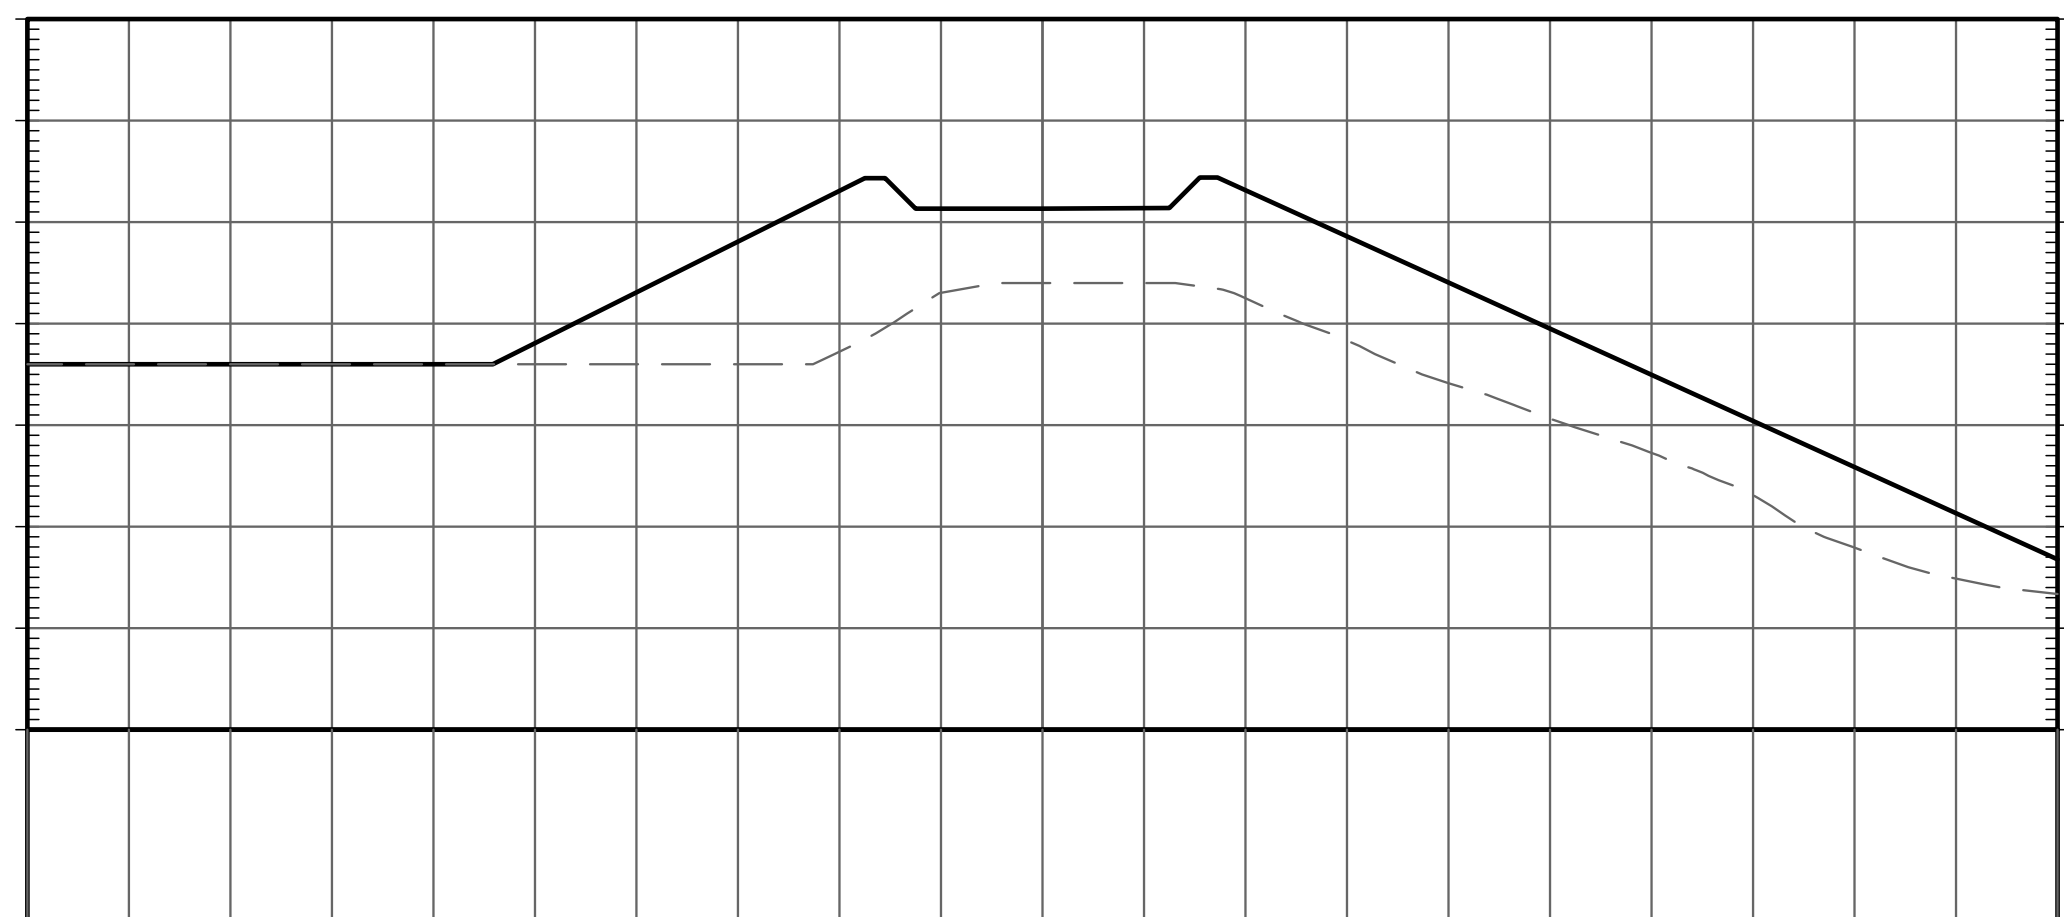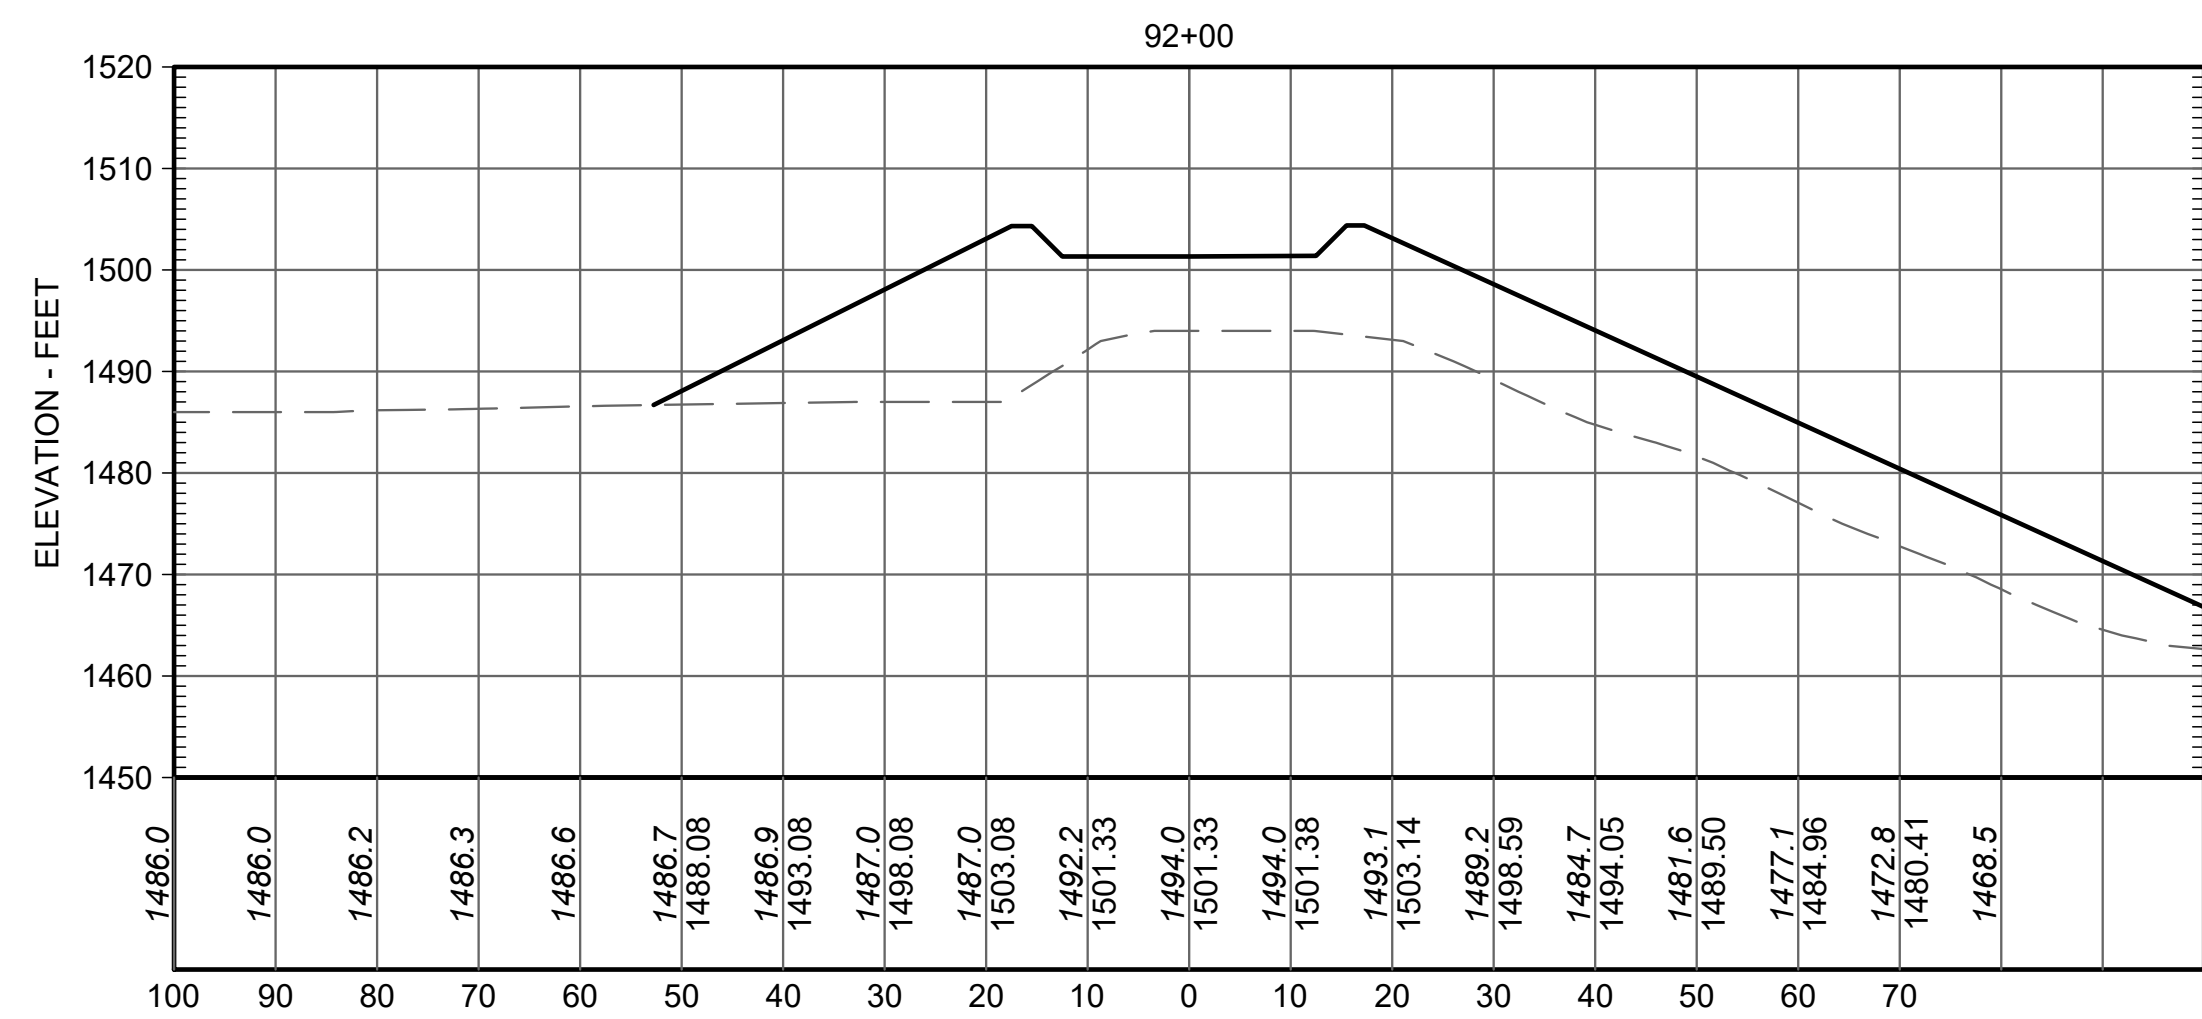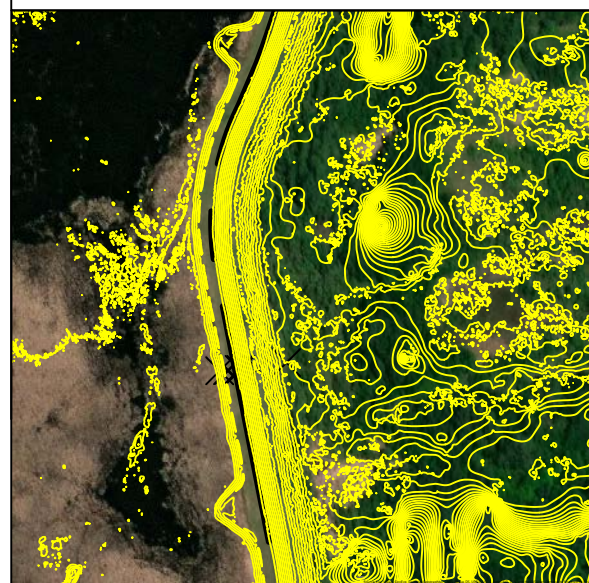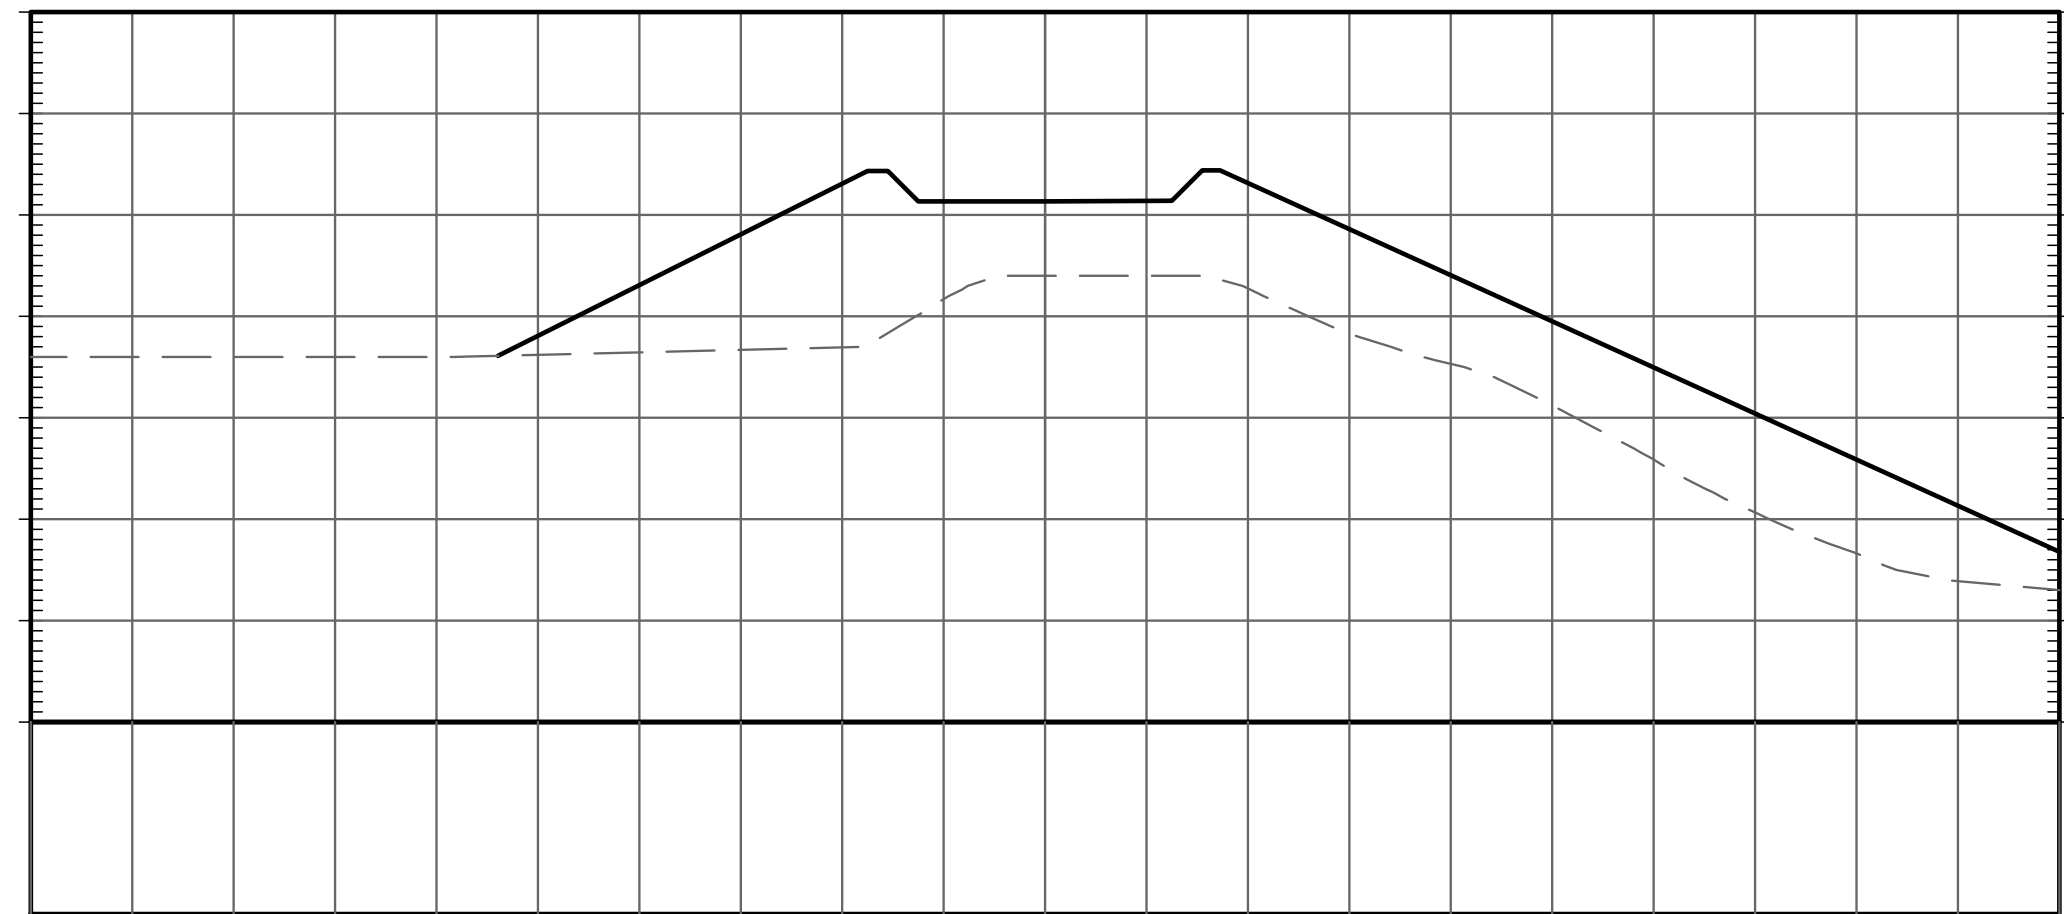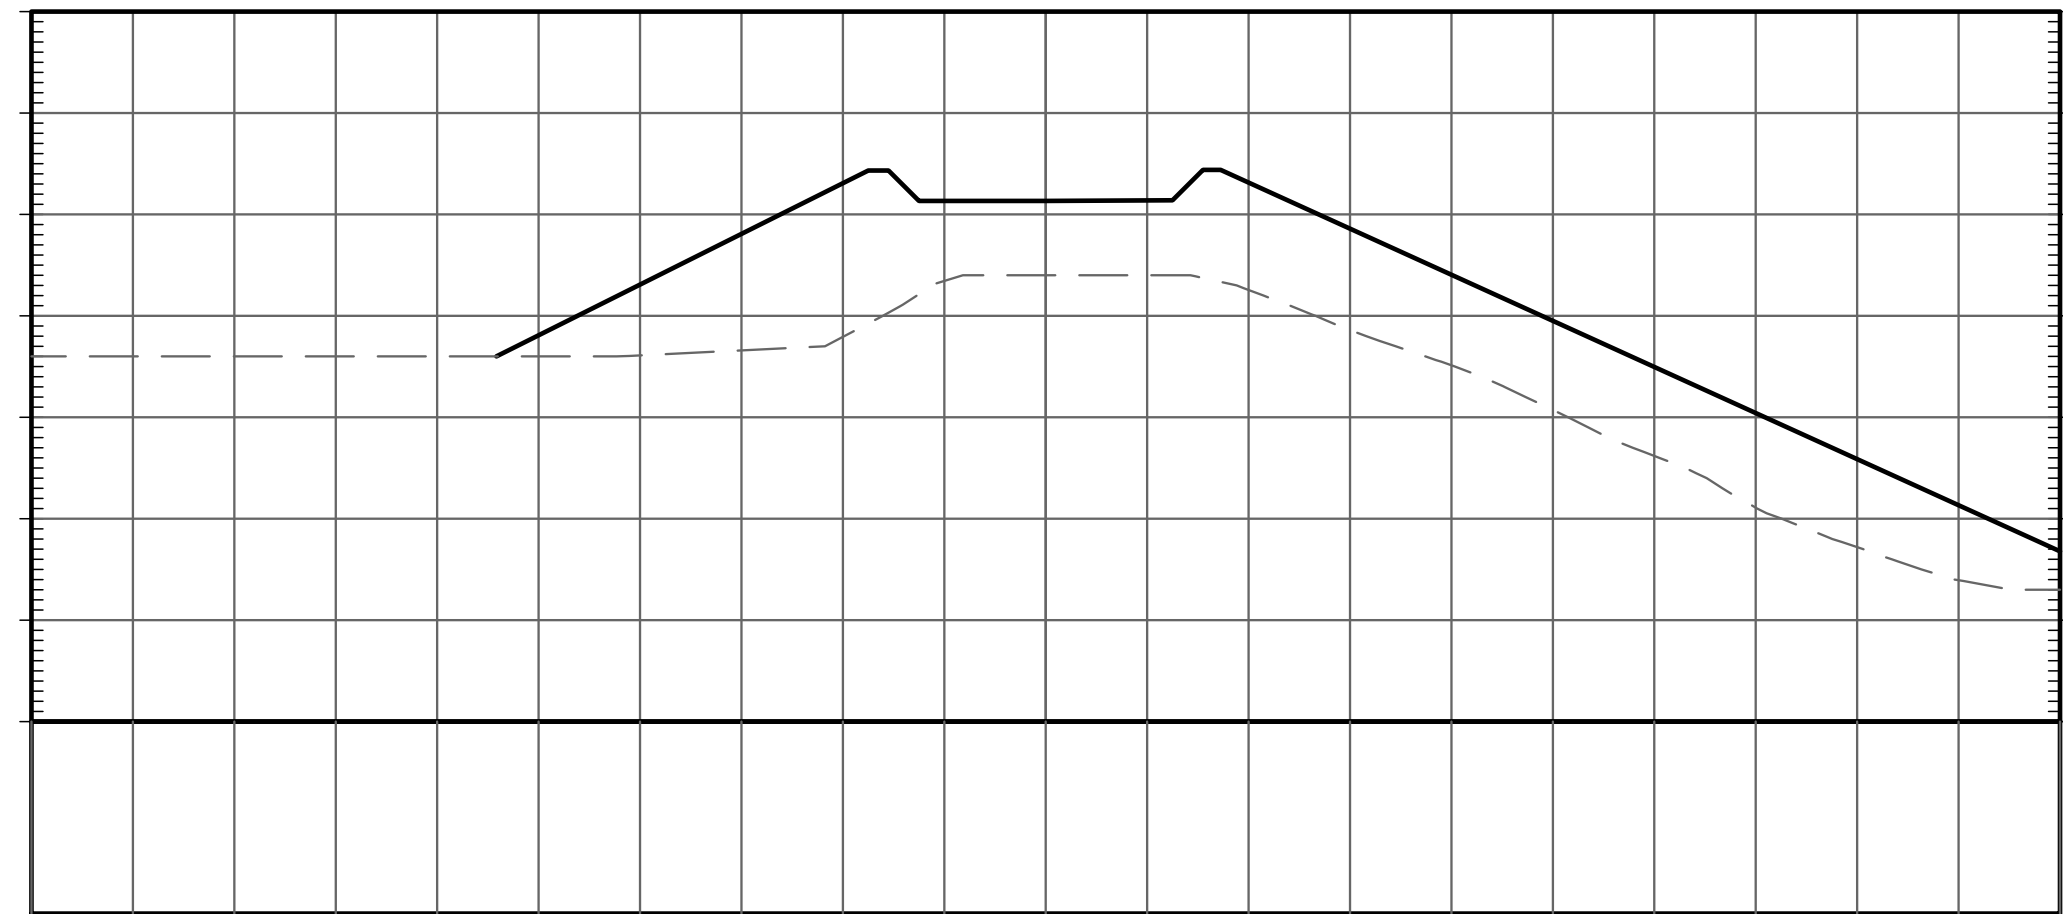

ELEVATIONS ARE REFERENCED TO NORTH AMERICAN VERTICAL DATUM 1988






AERIAL IMAGE FROM PRIOR TO CONSTRUCTION AND IS NOT REPRESENTATIVE OF FINAL PROFILES OR CONDITIONS

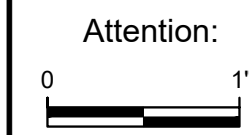

Attention:
If this scale bar does not measure 1" then drawing is not original scale.

Designed: BJF
 Drawn: BJF
 Checked: JPB
 Approved: JPB
 P.E. No: 40594
 GEI Project 2300038



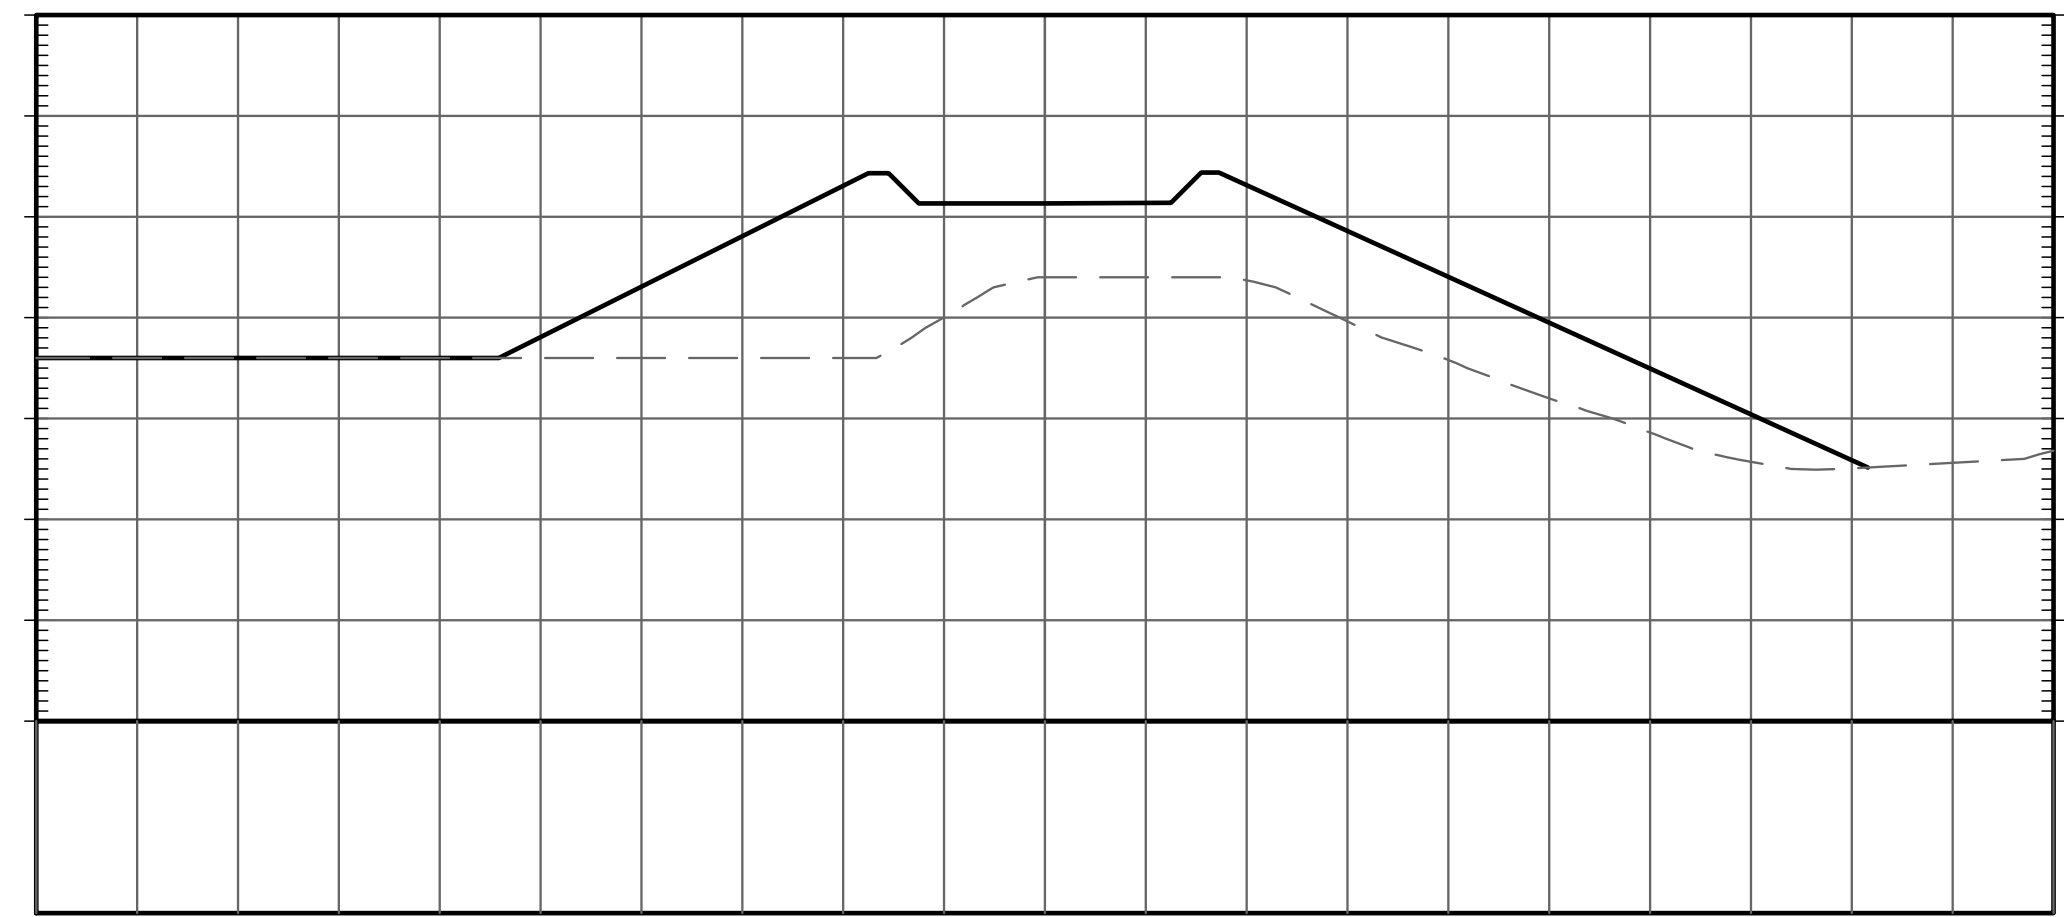
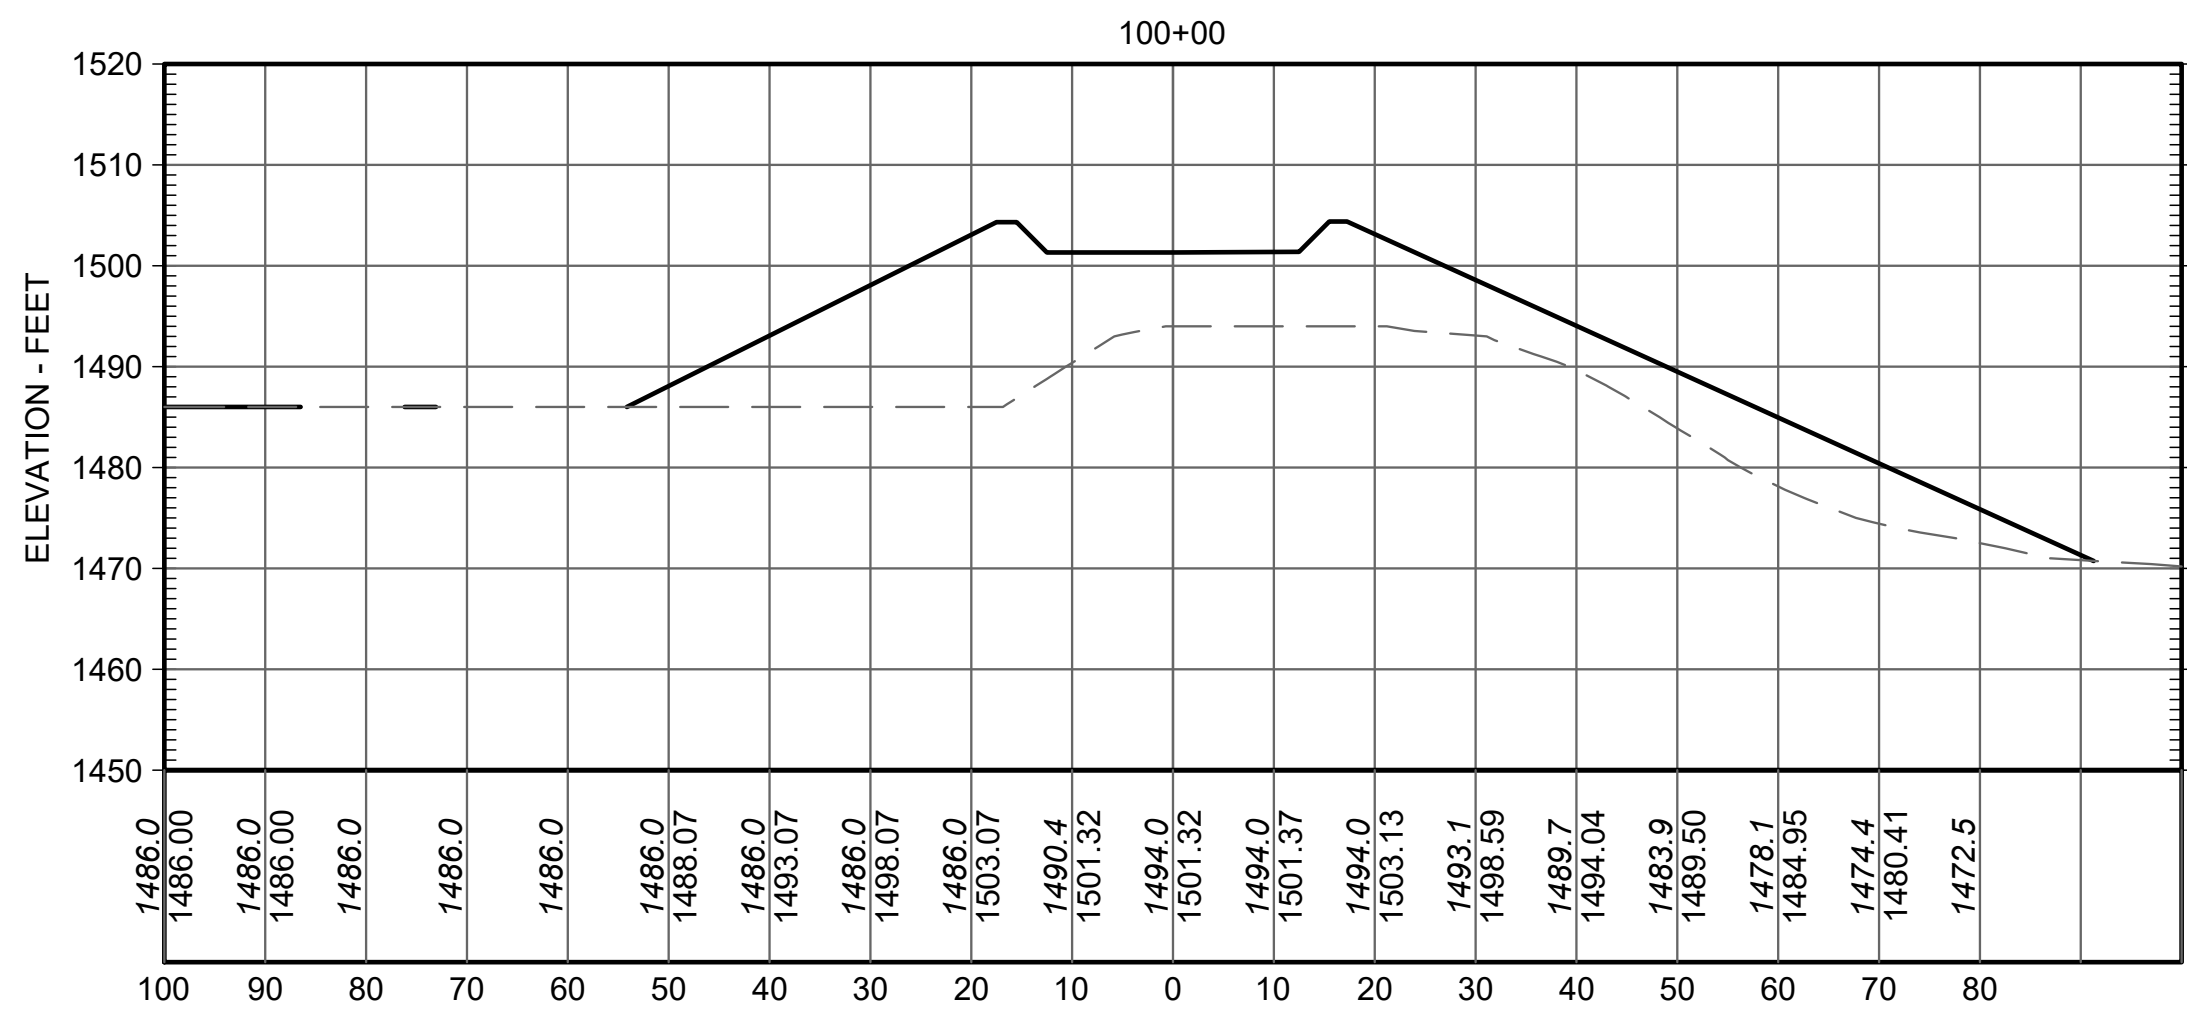
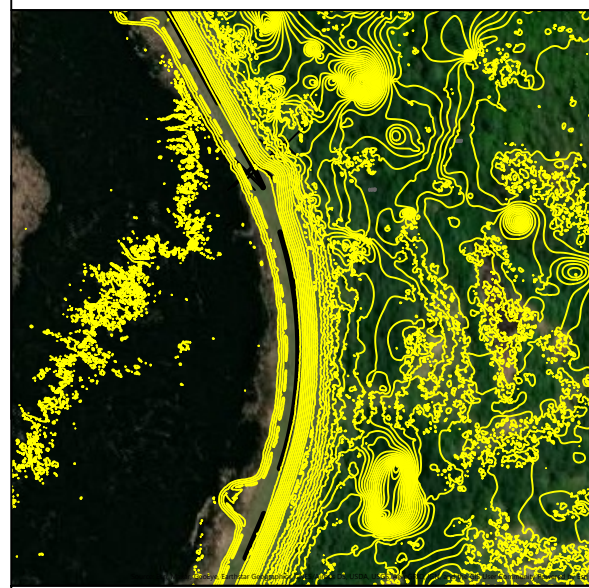
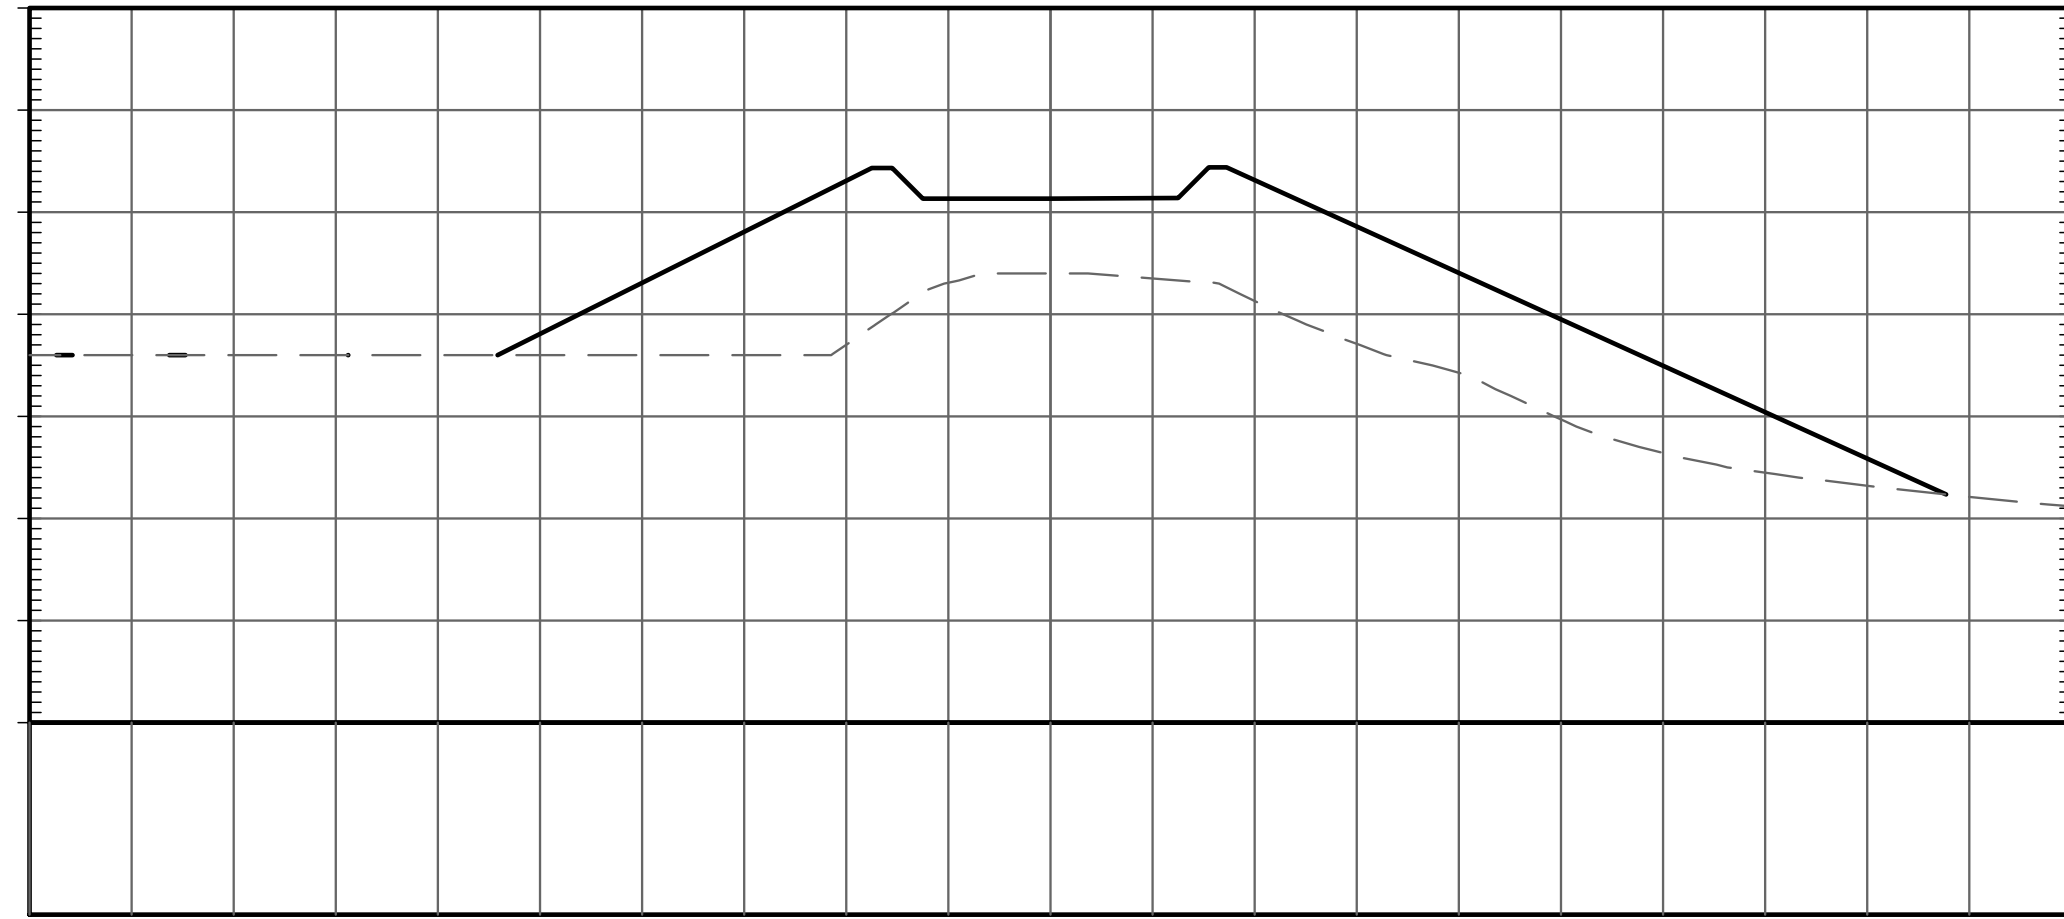
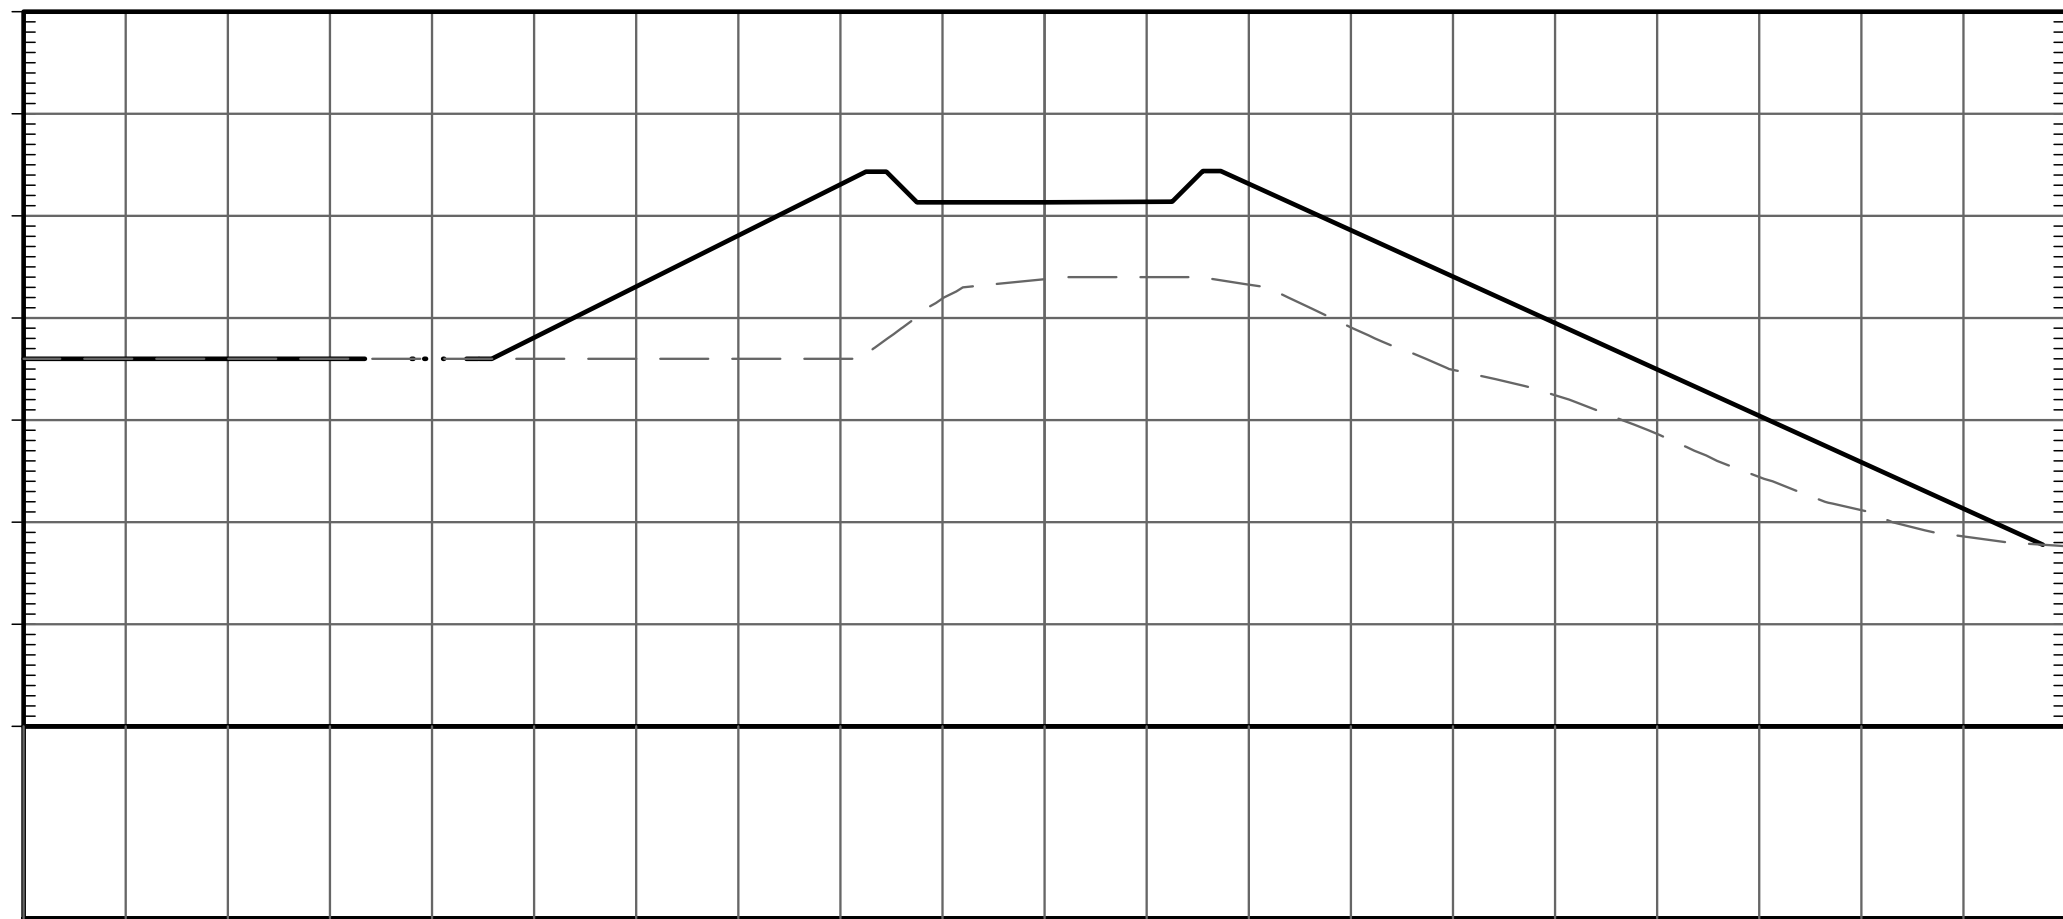


ELEVATIONS ARE REFERENCED TO NORTH AMERICAN VERTICAL DATUM 1988

AERIAL IMAGE FROM PRIOR TO CONSTRUCTION AND IS NOT REPRESENTATIVE OF FINAL PROFILES OR CONDITIONS

<p>Attention:</p> <p>If this scale bar does not measure 1" then drawing is not original scale.</p>	Designed: BJJ
	Drawn: BJJ
	Checked: JPB
	Approved: JPB
	P.E. No: 40594
GEI Project 2300038	



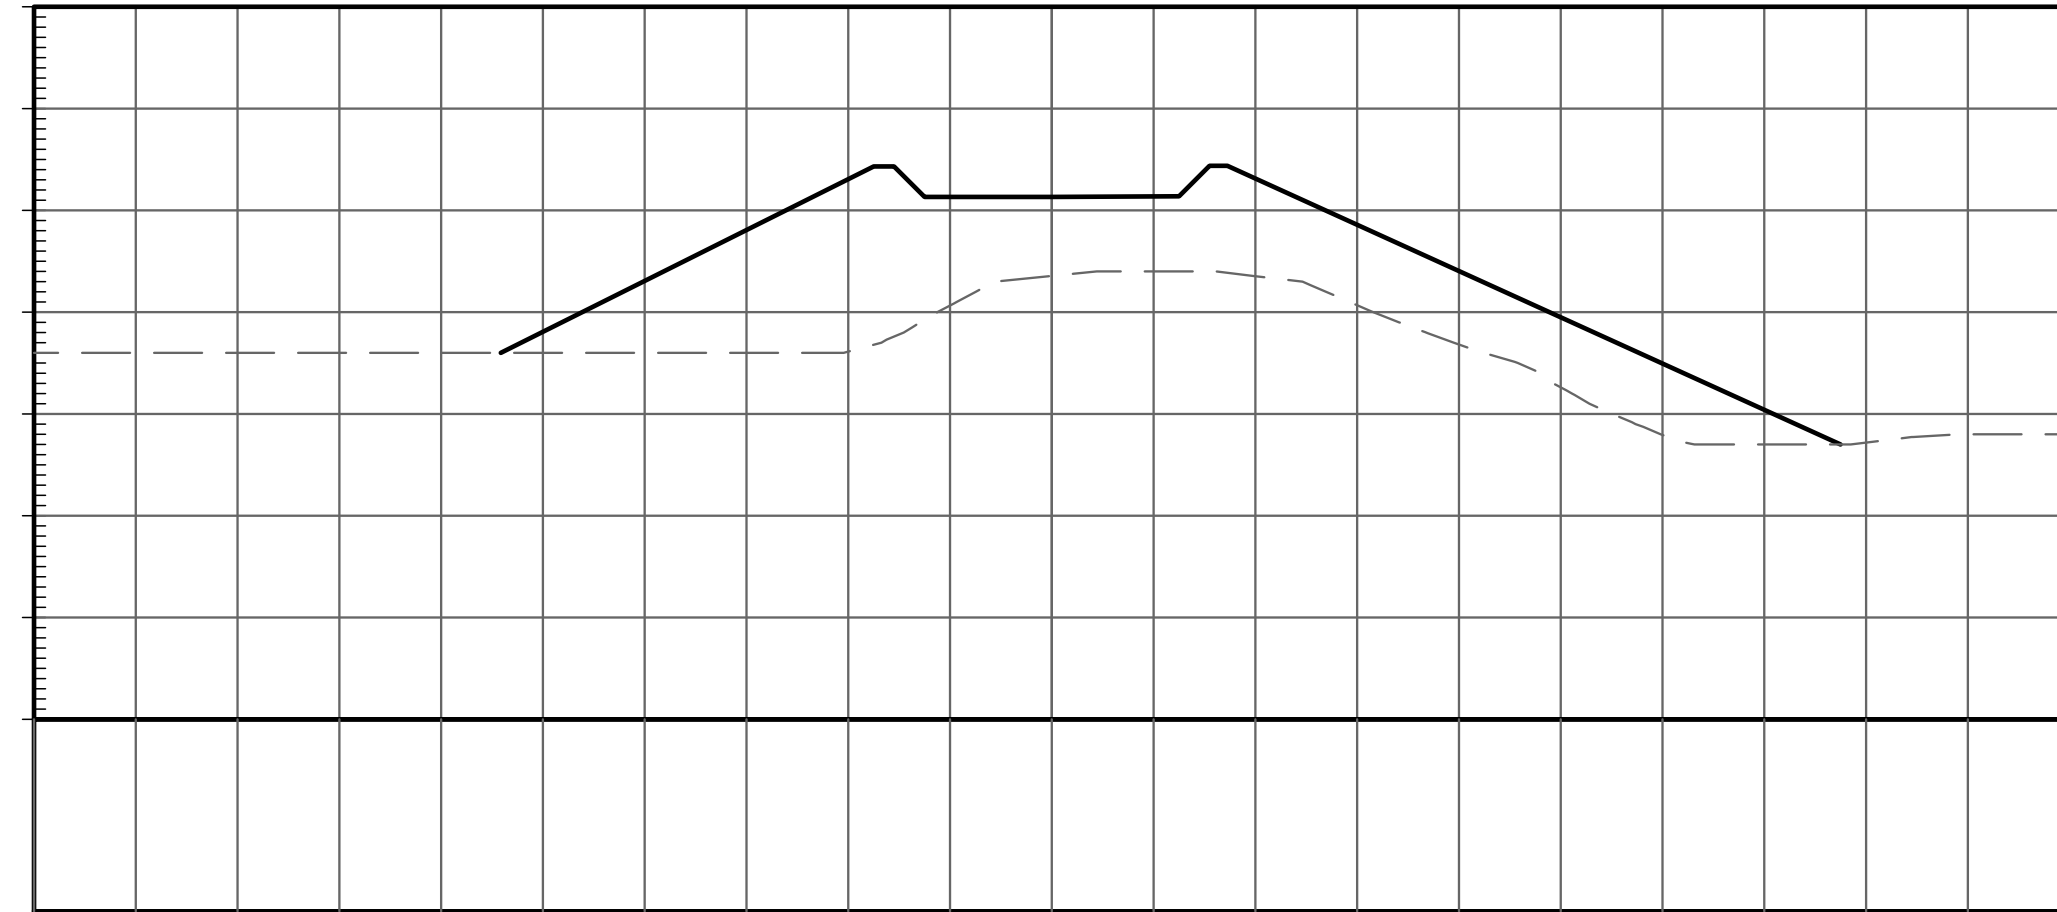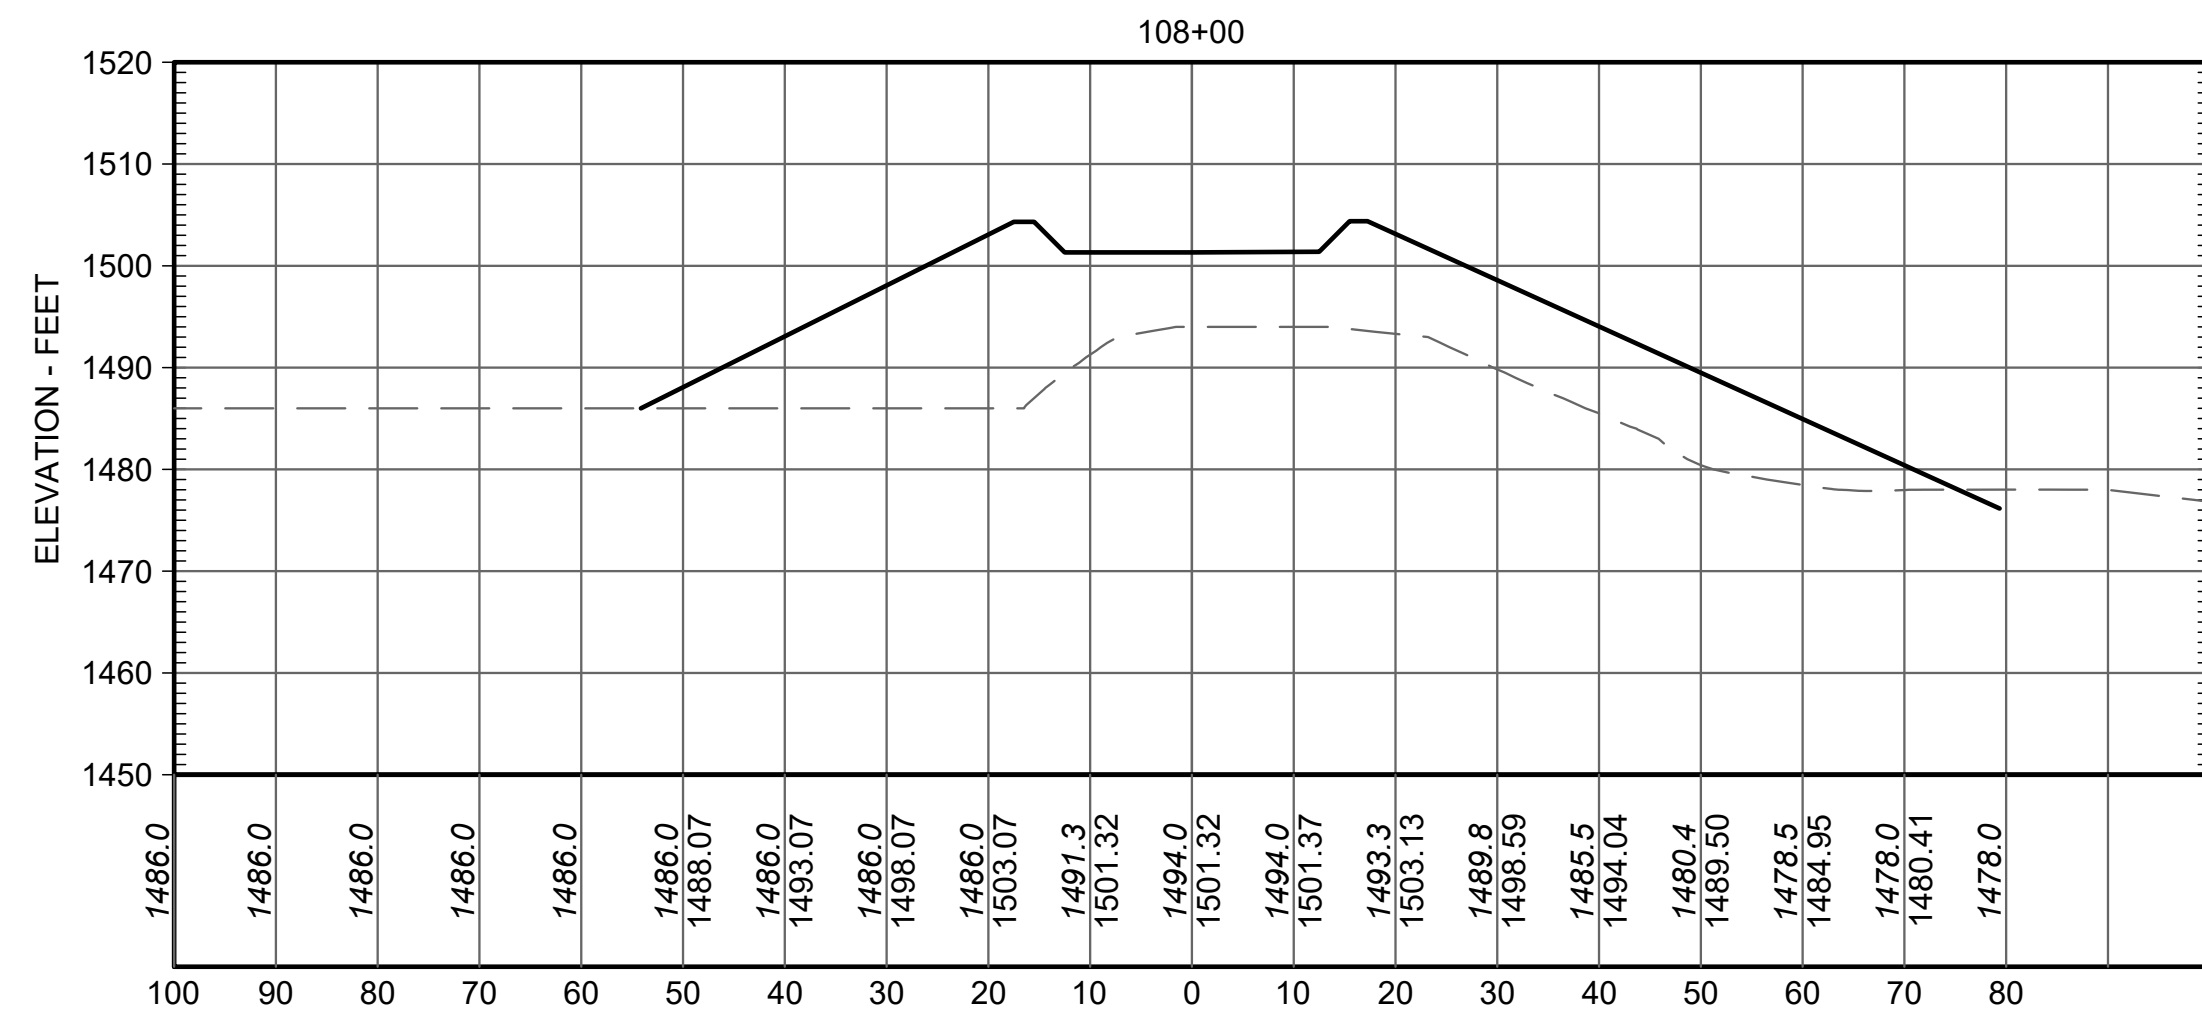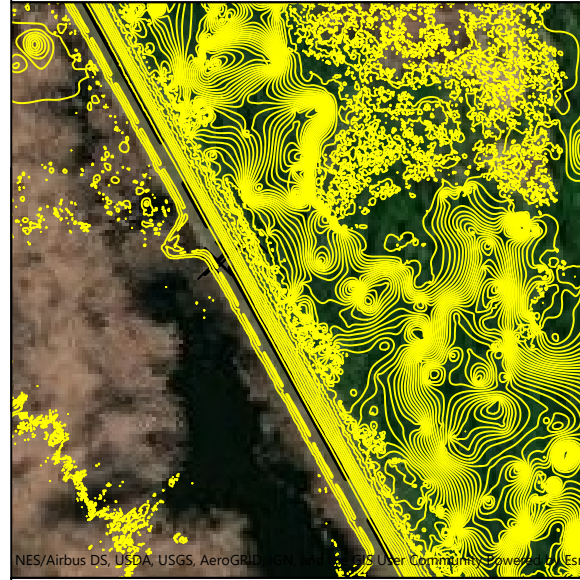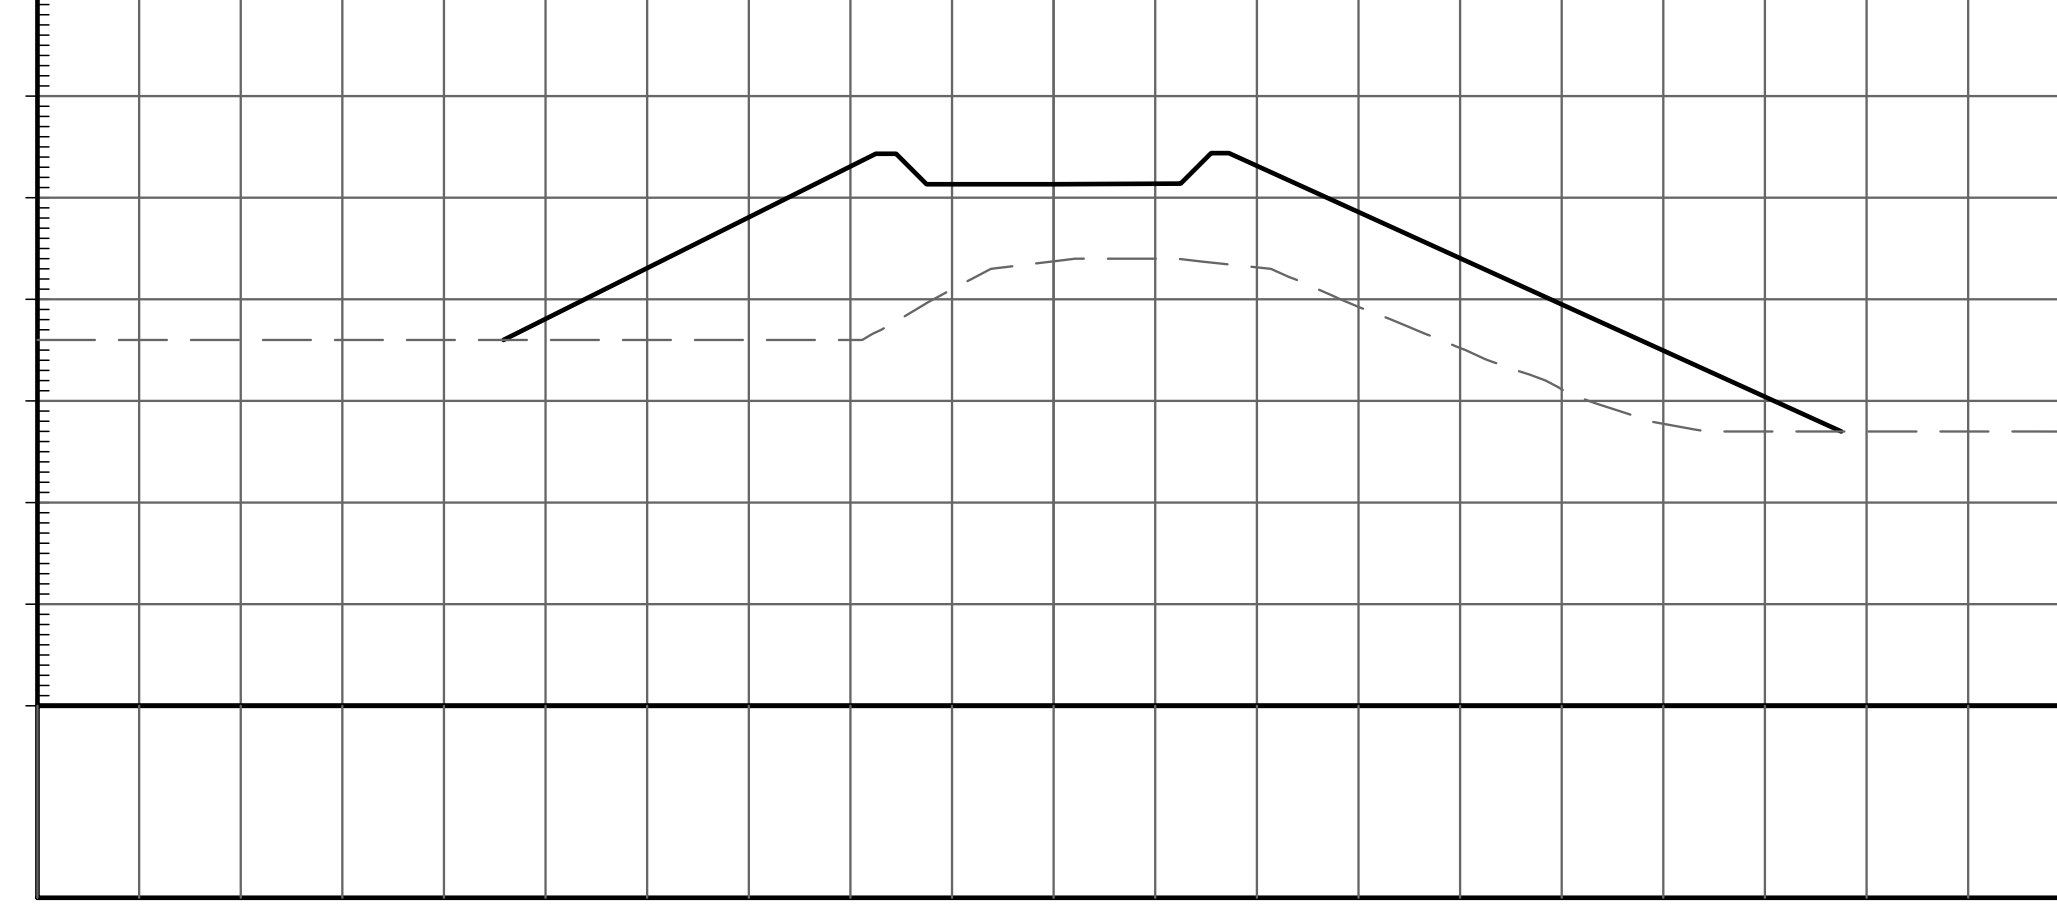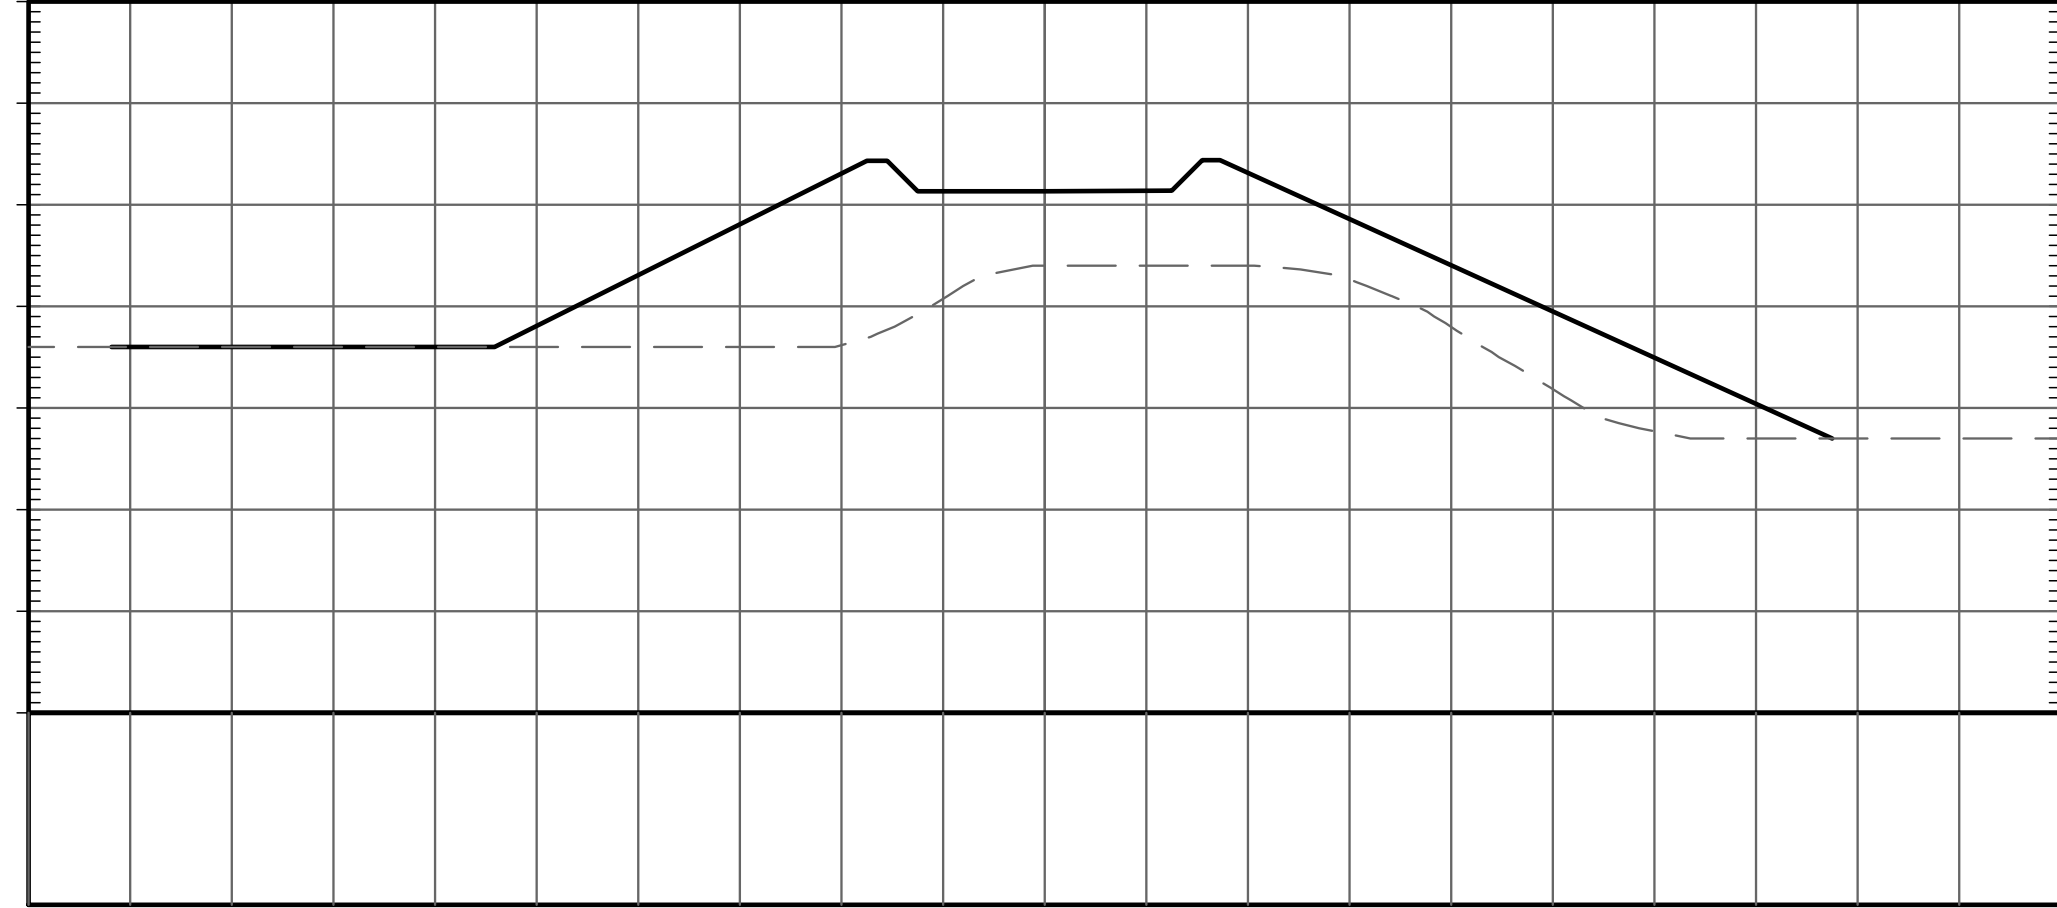






ELEVATIONS ARE REFERENCED TO NORTH AMERICAN VERTICAL DATUM 1988

AERIAL IMAGE FROM PRIOR TO CONSTRUCTION AND IS NOT REPRESENTATIVE OF FINAL PROFILES OR CONDITIONS

Attention: <small>If this scale bar does not measure 1" then drawing is not original scale.</small>	<i>Designed:</i> BJF
	<i>Drawn:</i> BJF
	<i>Checked:</i> JPB
	<i>Approved:</i> JPB
	<i>P.E. No.:</i> 40594
<i>GEI Project</i> 2300038	



FEARING, BRIAN B:\Working\UNITED STATES STEEL CORPORATION\2403917 Phase I (2024) Dike Construction\00_CADD\Design\Civil\DKK\Keebz_2023.dwg - 1/13/2025

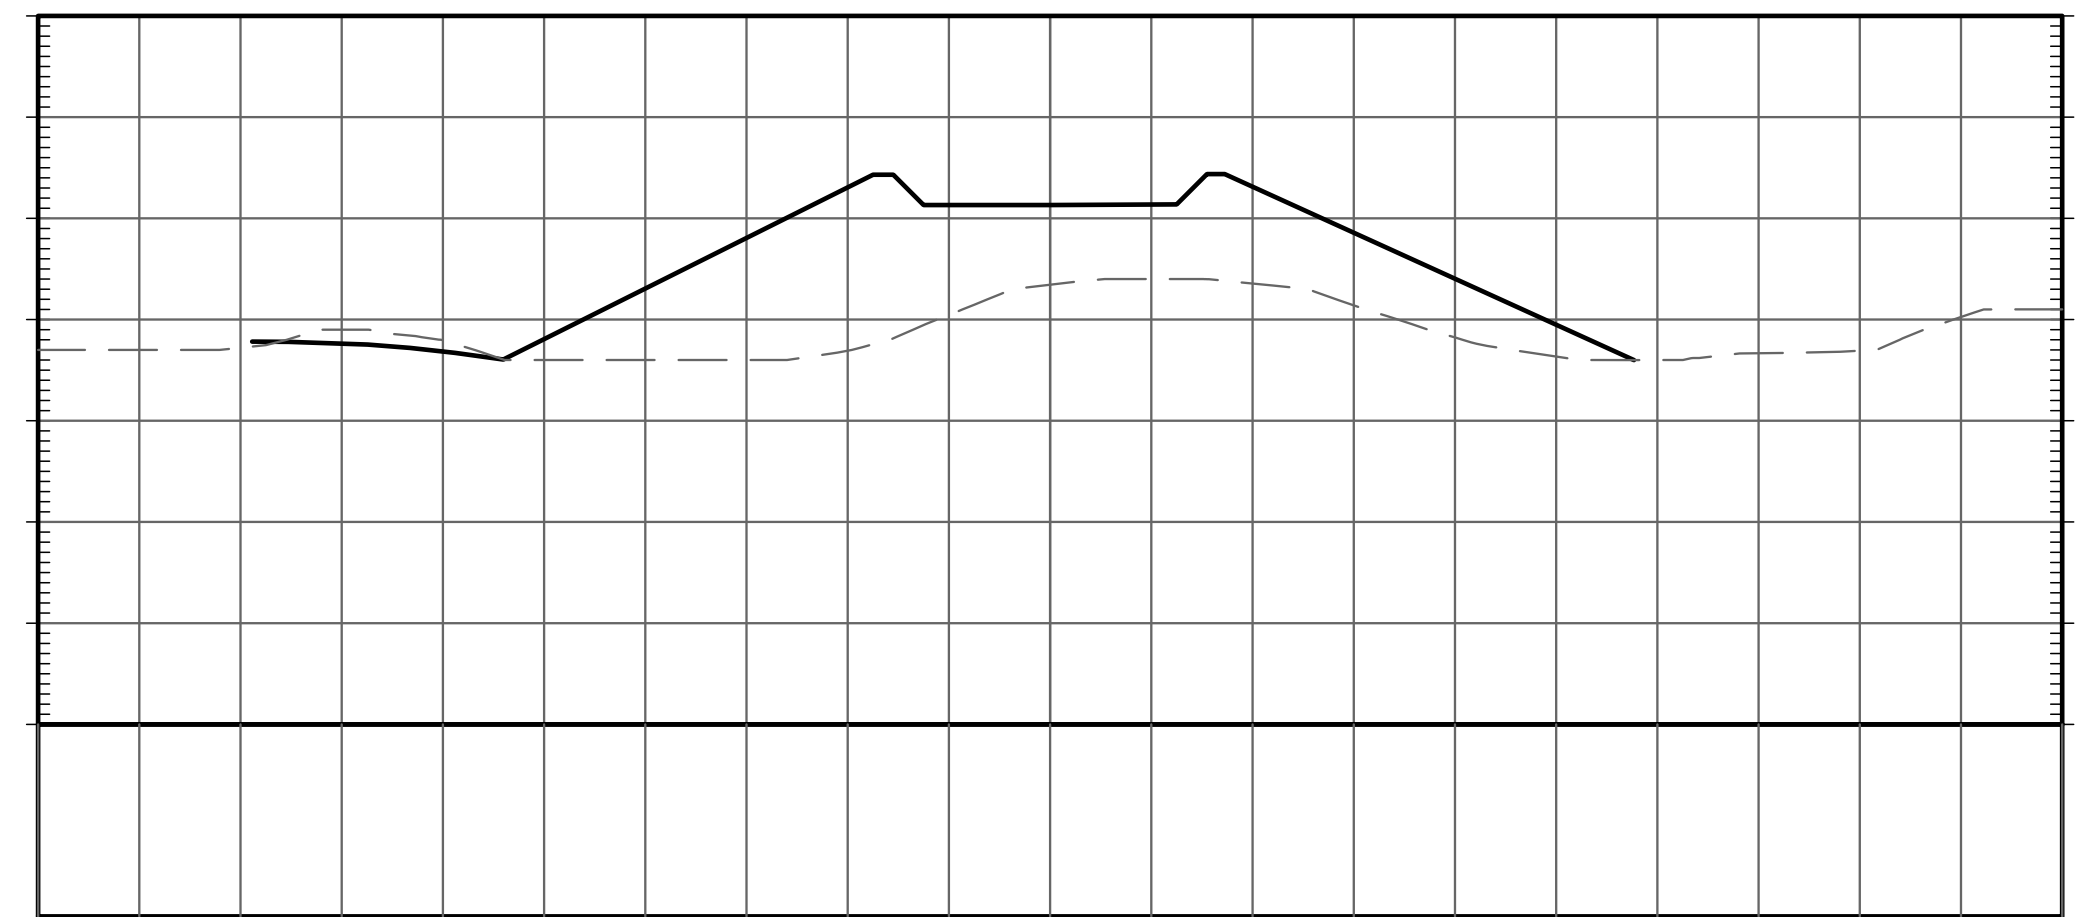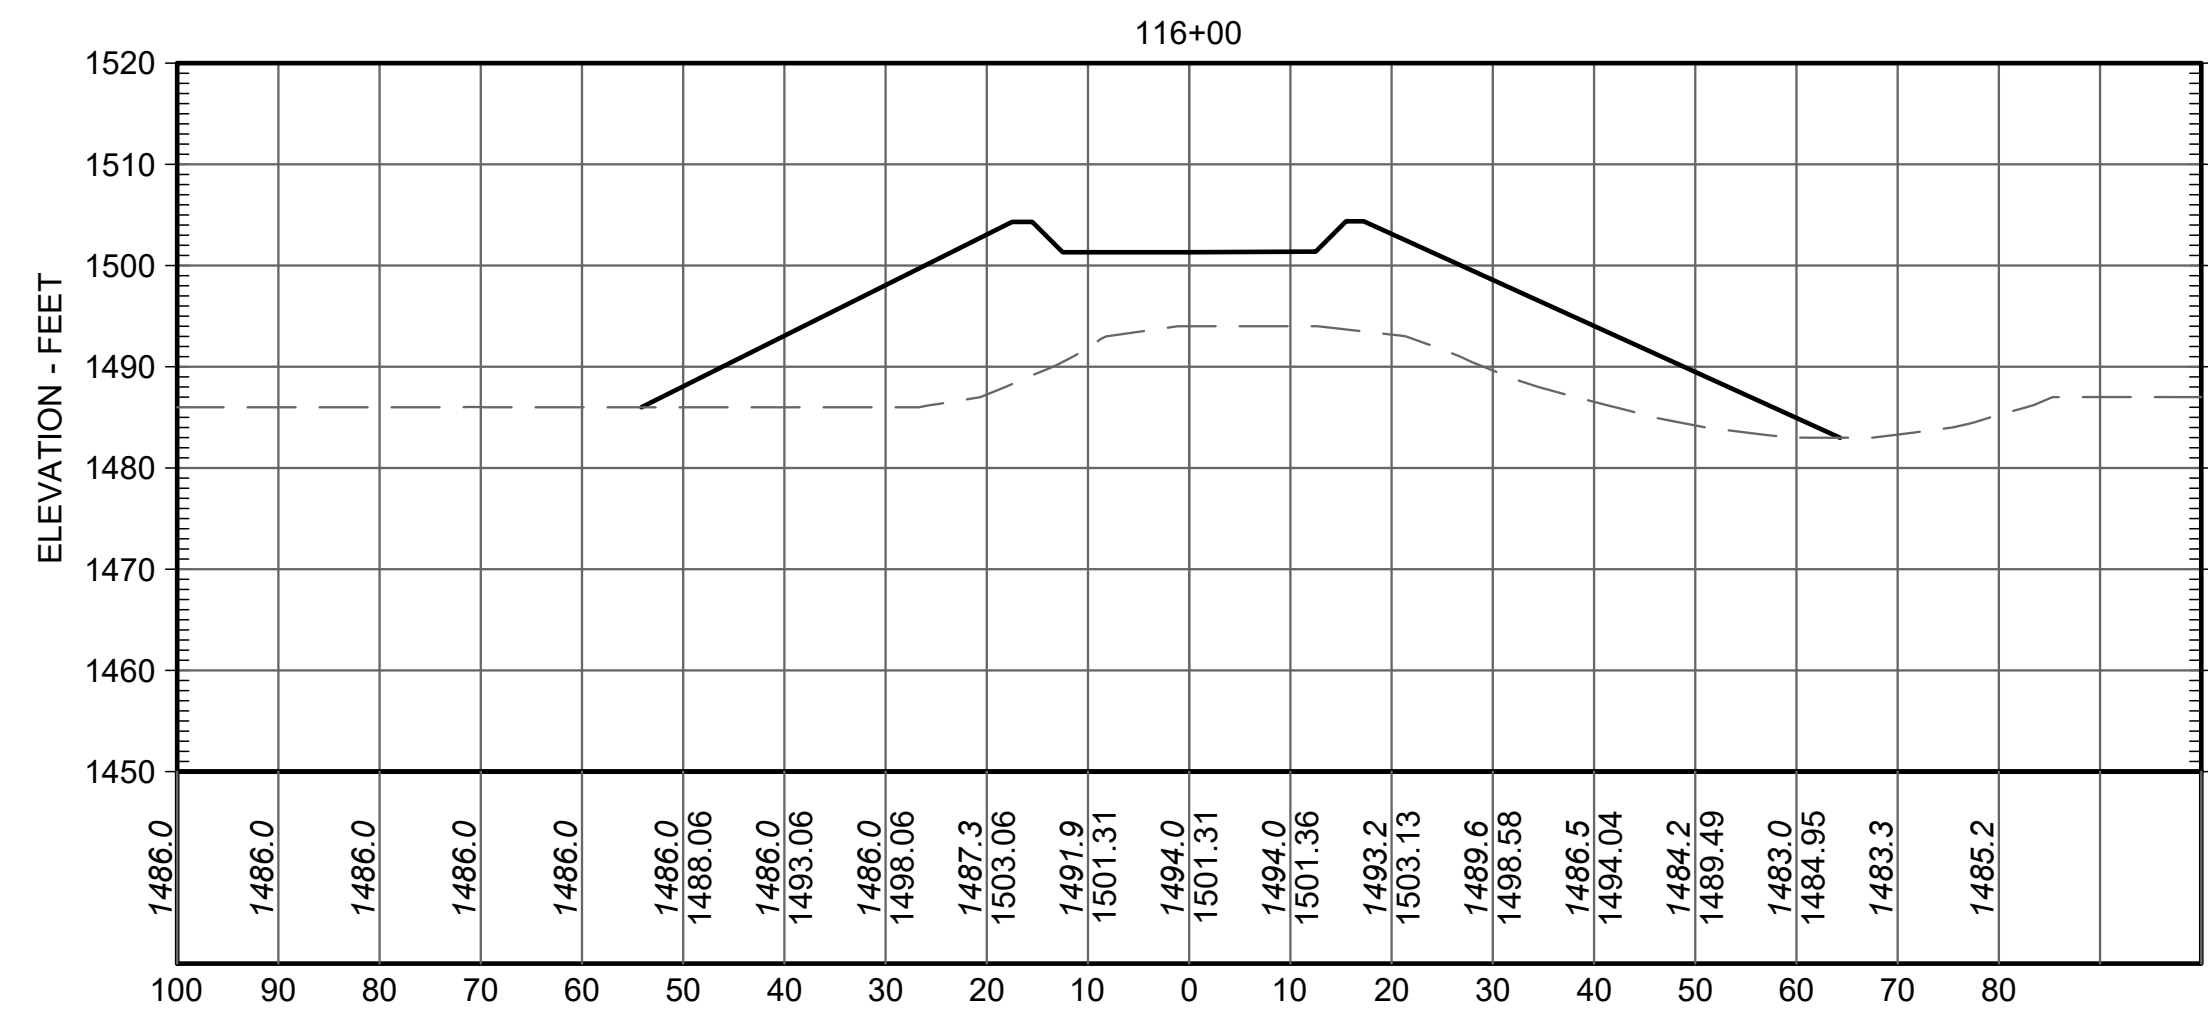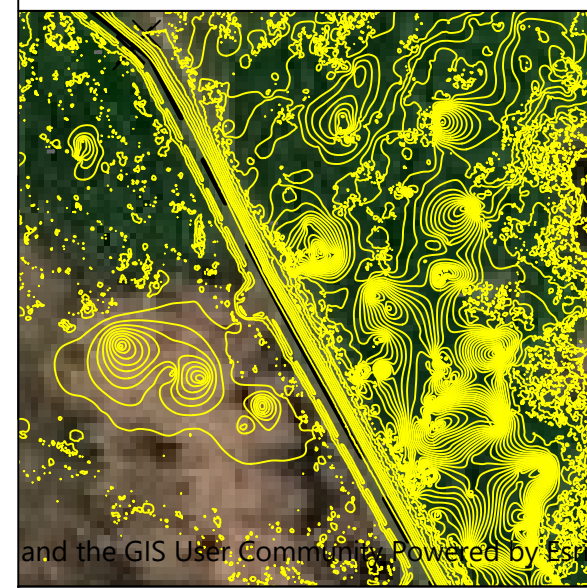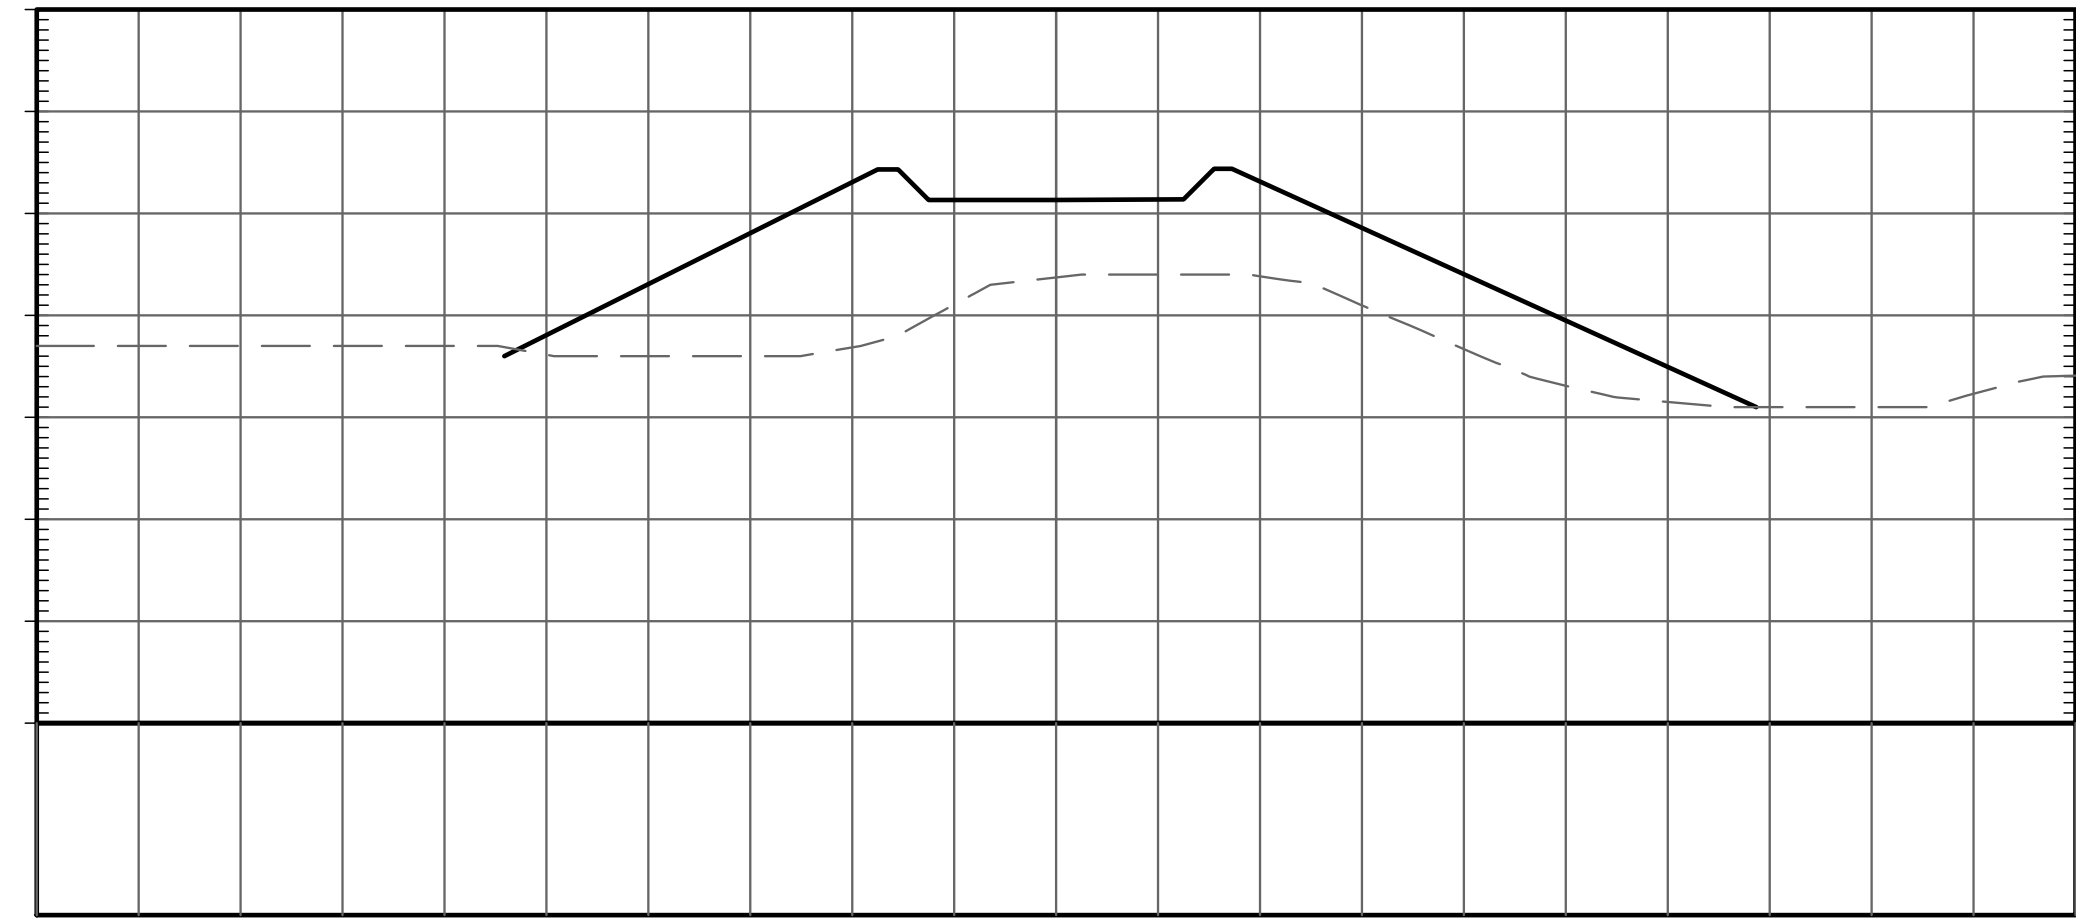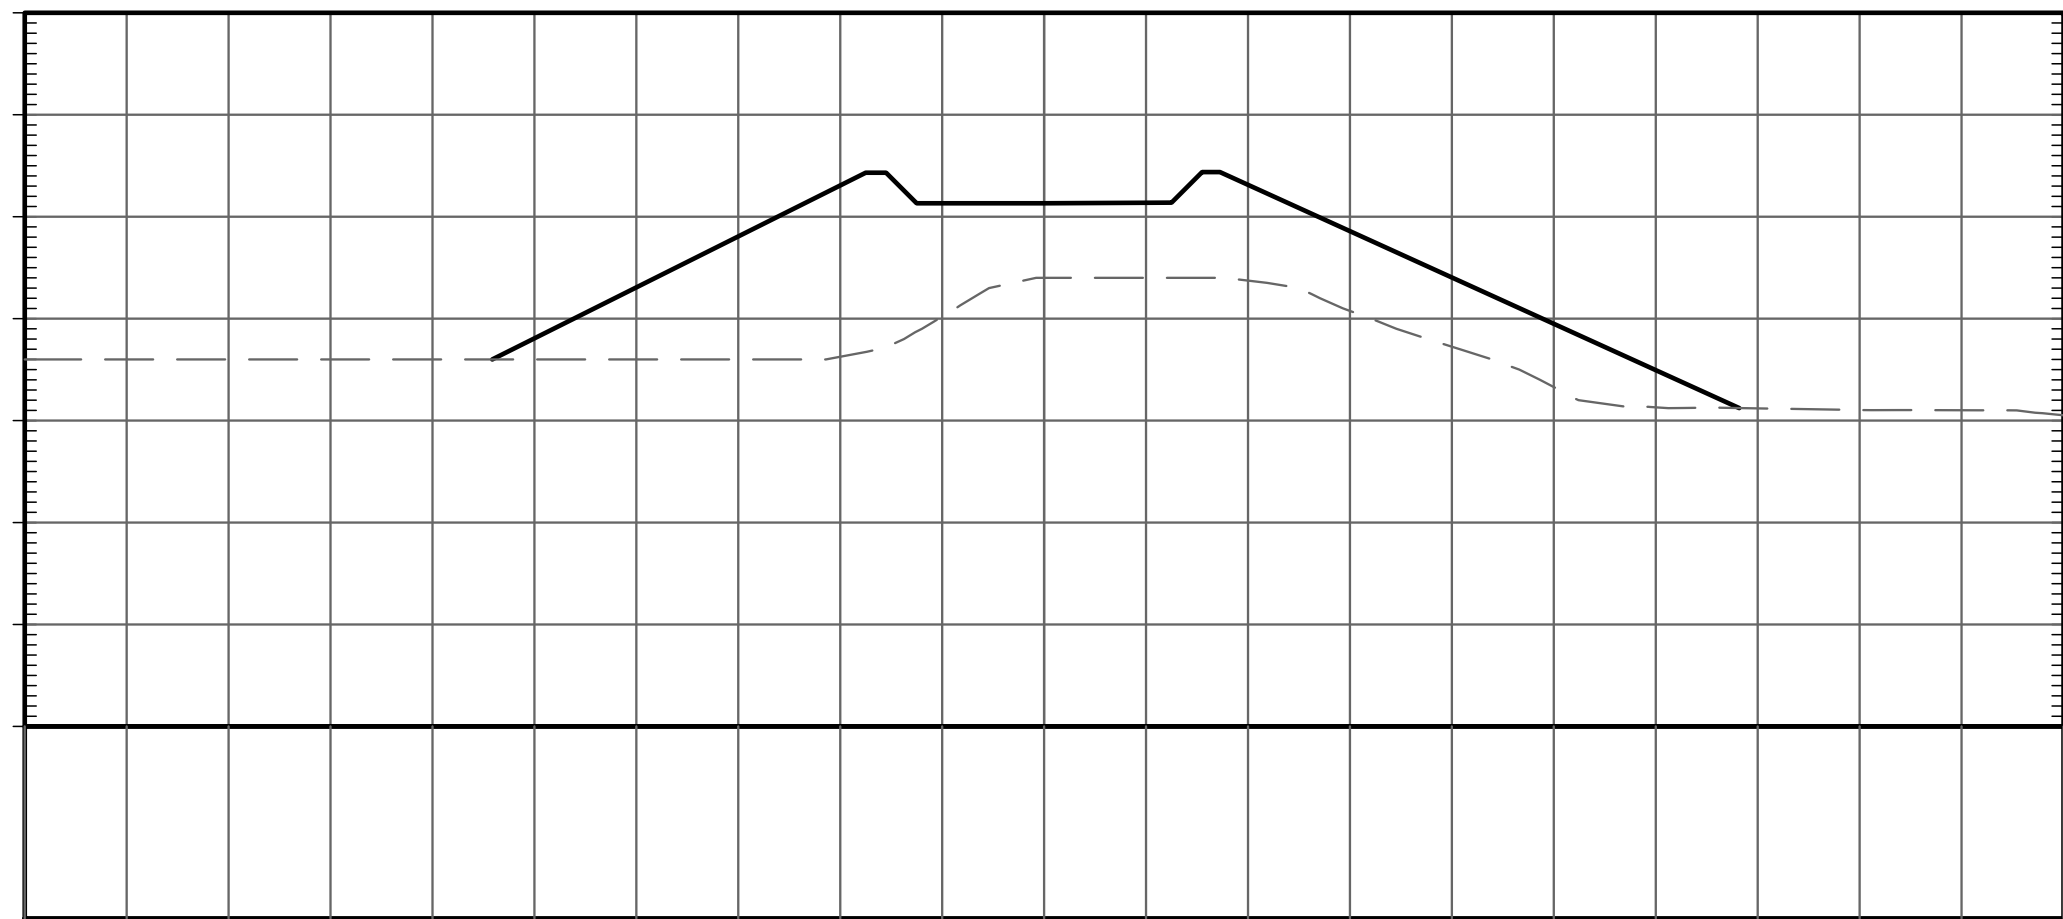


ELEVATIONS ARE REFERENCED TO NORTH AMERICAN VERTICAL DATUM 1988

AERIAL IMAGE FROM PRIOR TO CONSTRUCTION AND IS NOT REPRESENTATIVE OF FINAL PROFILES OR CONDITIONS

<p style="font-size: small;">Attention:</p> <p style="font-size: x-small;">If this scale bar does not measure 1" then drawing is not original scale.</p>	<i>Designed:</i> BJB
	<i>Drawn:</i> BJB
	<i>Checked:</i> JPB
	<i>Approved:</i> JPB
	<i>P.E. No.:</i> 40594
<i>GEI Project:</i> 2300038	



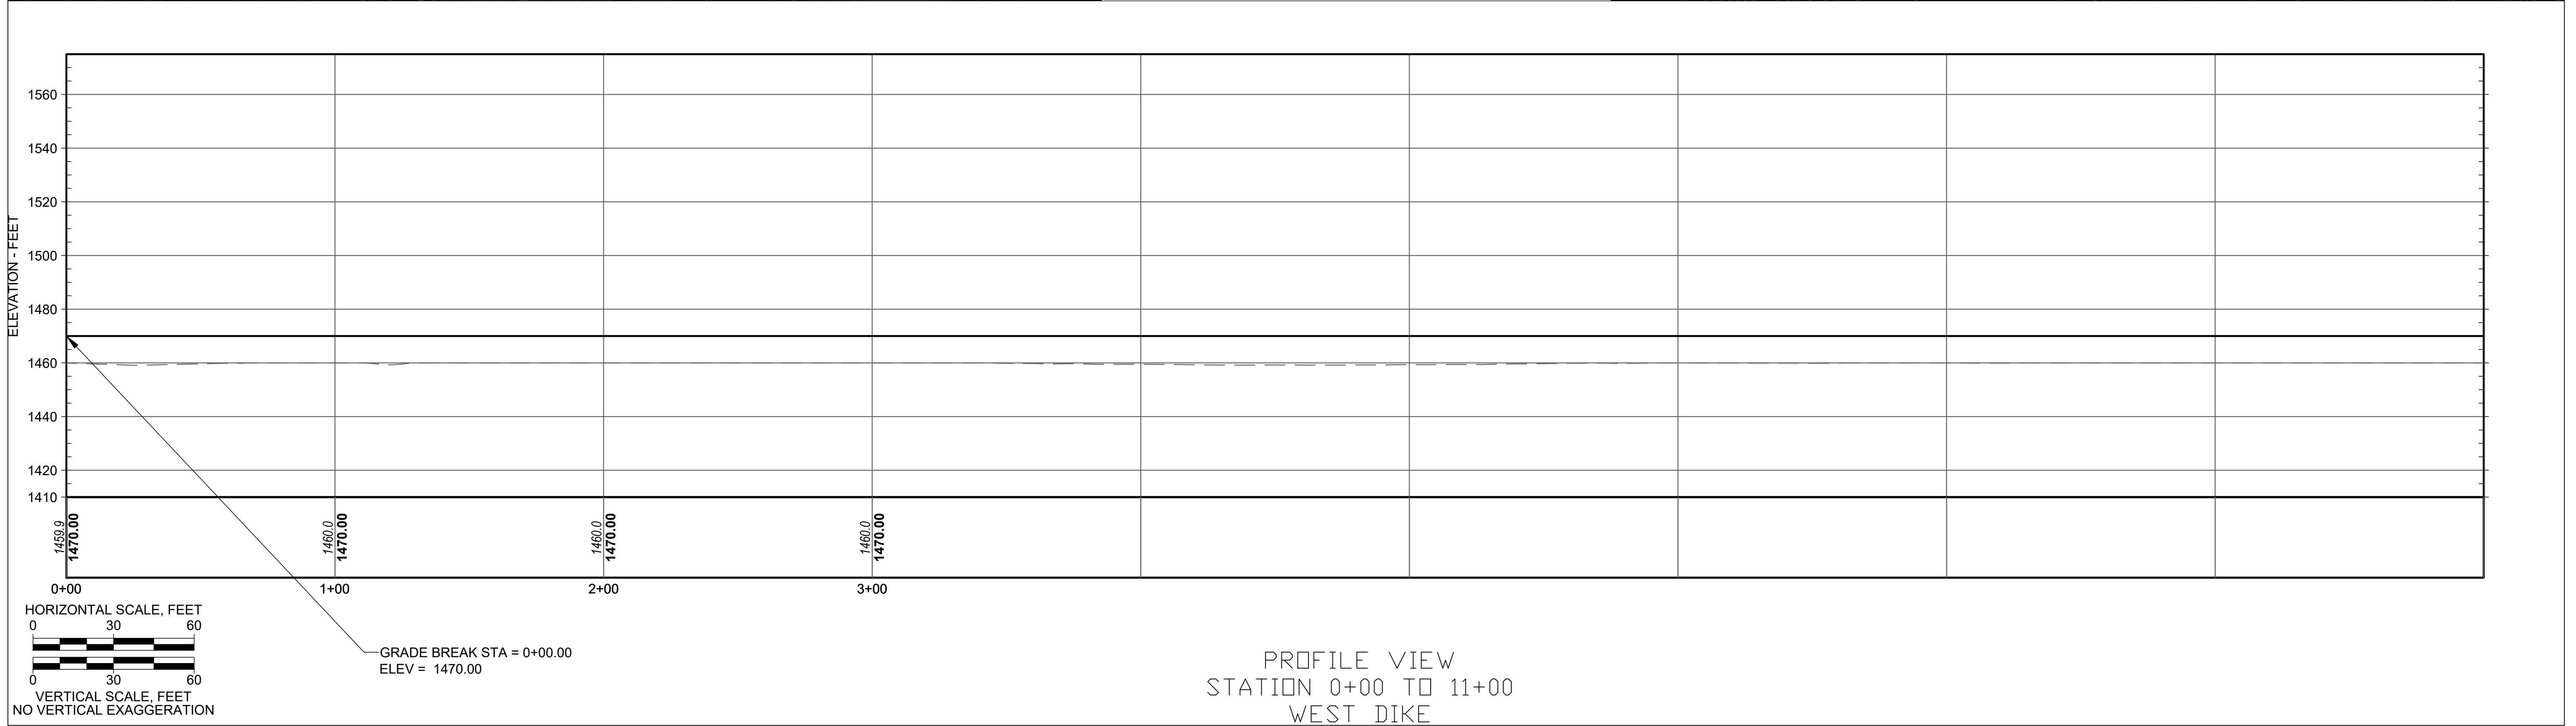


ELEVATIONS ARE REFERENCED TO NORTH AMERICAN VERTICAL DATUM 1988

AERIAL IMAGE FROM PRIOR TO CONSTRUCTION AND IS NOT REPRESENTATIVE OF FINAL PROFILES OR CONDITIONS


Attention: If this scale bar does not measure 1" then drawing is not original scale.	Designed: BJF
	Drawn: BJF
	Checked: JPB
	Approved: JPB
	P.E. No: 40594
	GEI Project 2300038



8/8/2024 1:26:00 PM C:\Users\bfelias3250\OneDrive - GEI Consultants, Inc\Desktop\Kearns 2024\Res 6 West Dike\VFG - West Dike - (1).dwg

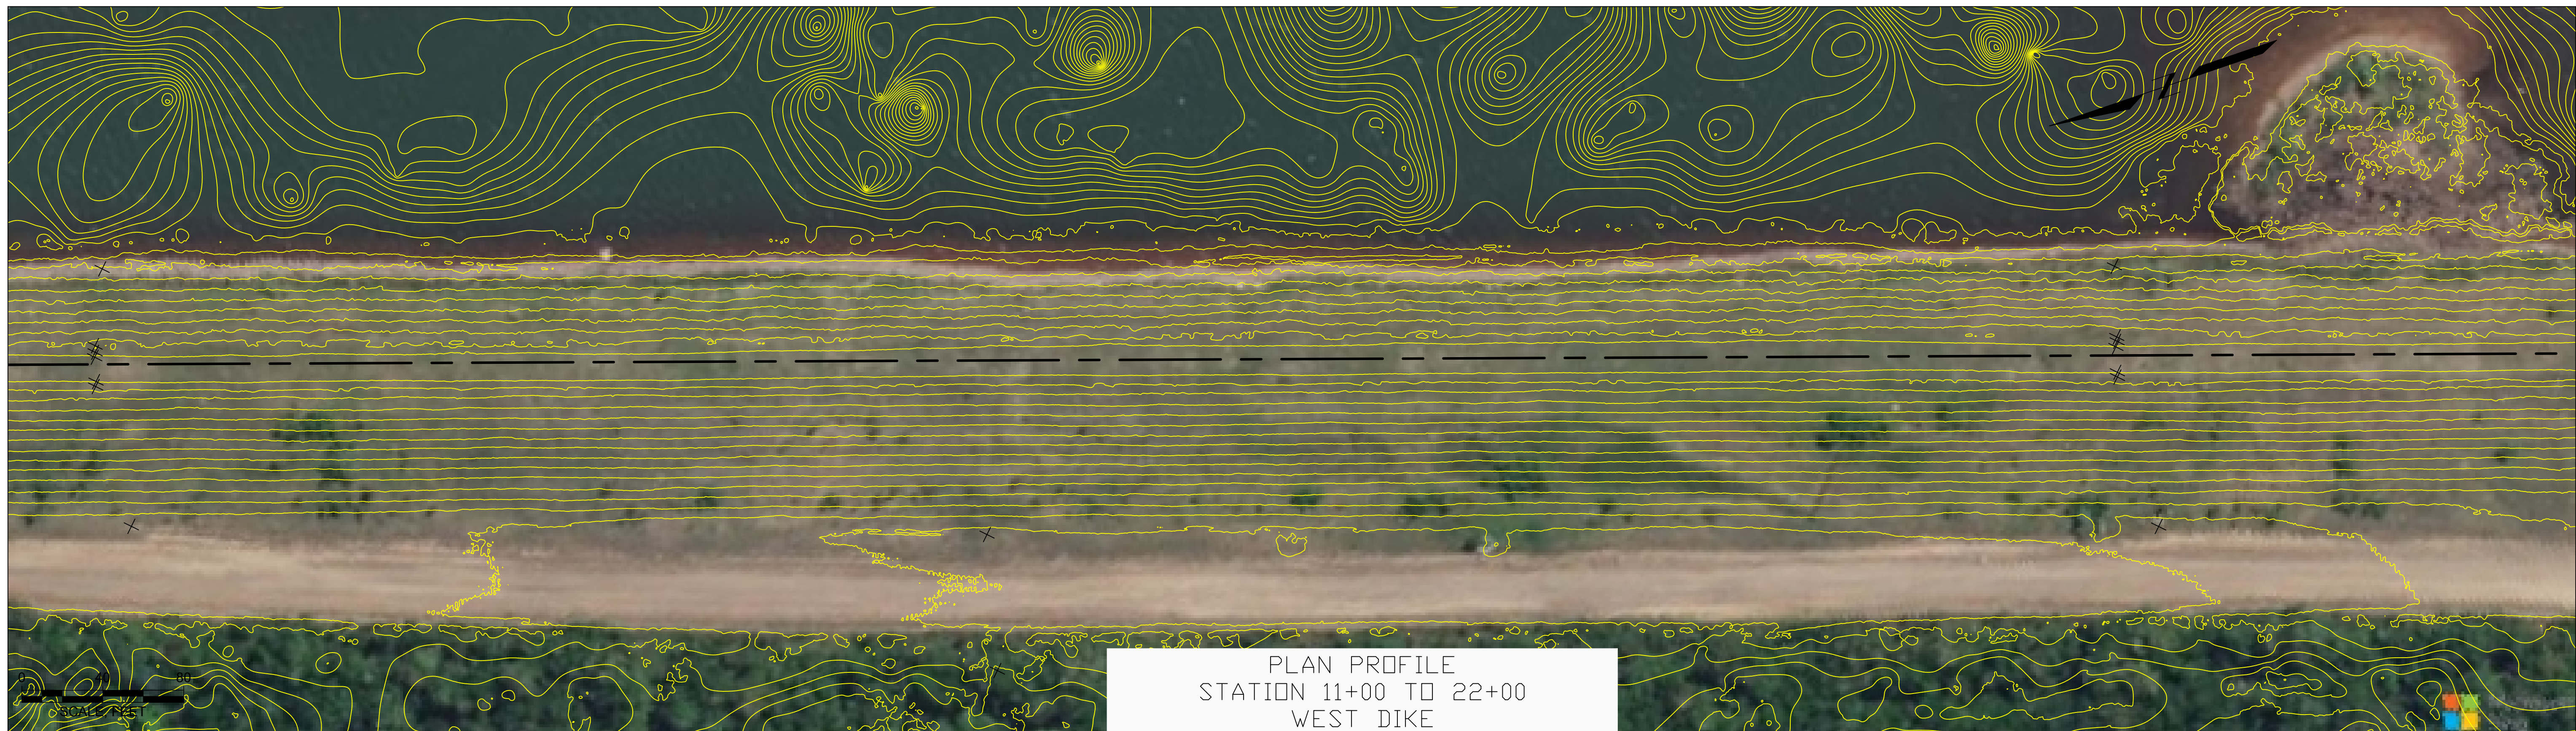

PLAN PROFILE
STATION 11+00 TO 22+00
WEST DIKE

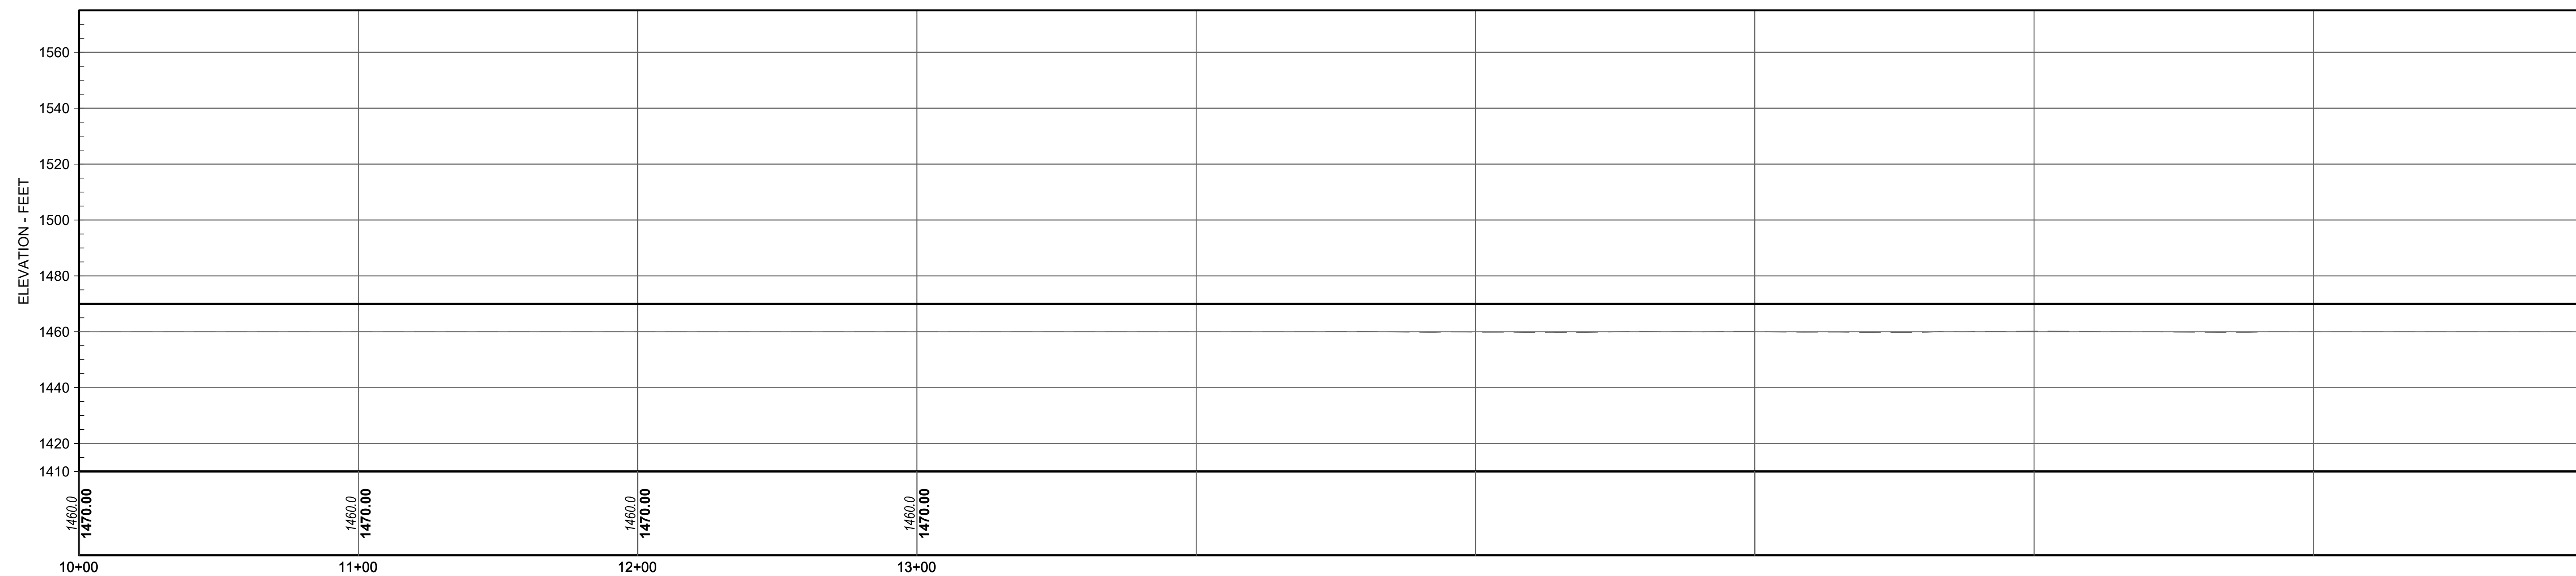

PROFILE VIEW
STATION 11+00 TO 22+00
WEST DIKE

HORIZONTAL SCALE, FEET
0 30 60
VERTICAL SCALE, FEET
NO VERTICAL EXAGGERATION


ELEVATIONS ARE REFERENCED TO NORTH
AMERICAN VERTICAL DATUM 1988

AERIAL IMAGE FROM PRIOR TO CONSTRUCTION AND IS
NOT REPRESENTATIVE OF FINAL PROFILES OR CONDITIONS


Attention:
If this scale bar
does not measure
1" then drawing is
not original scale.

Designed: BJJ
Drawn: BJJ
Checked: JPB
Approved: JPB
P.E. No: 40594
GEI Project 2300038



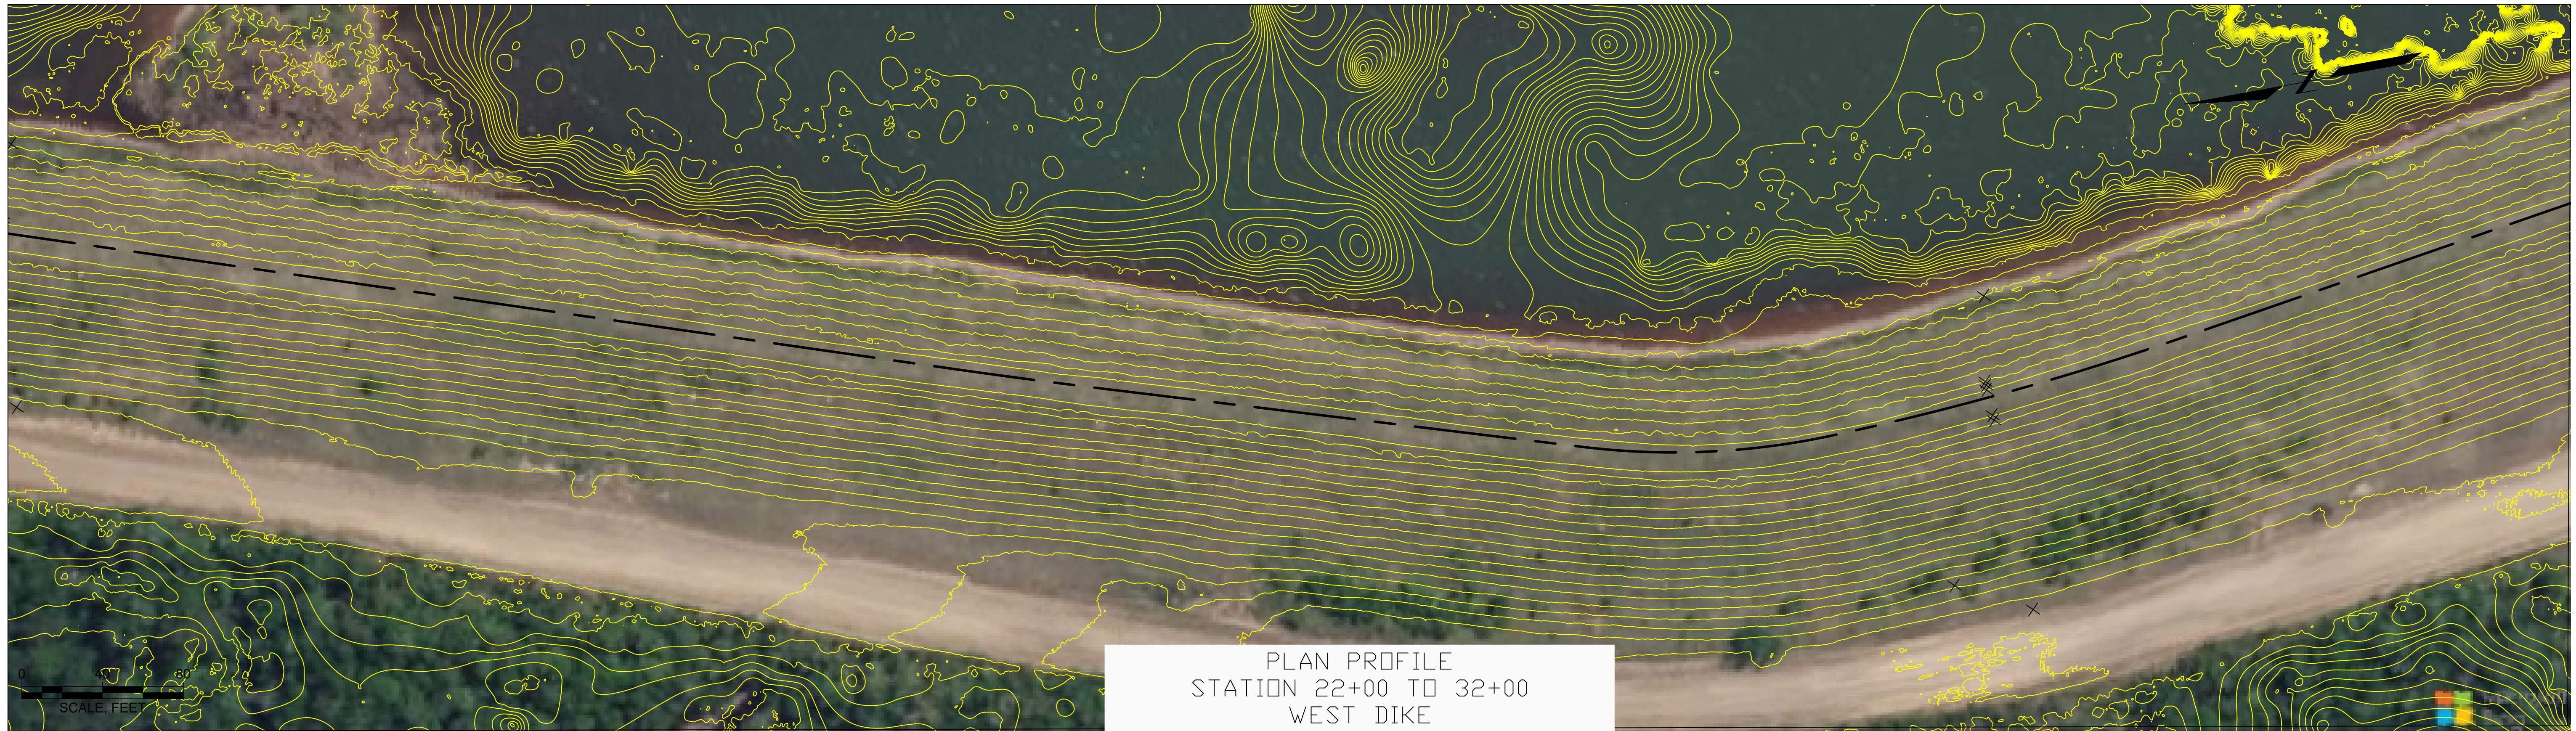

PLAN PROFILE
STATION 22+00 TO 32+00
WEST DIKE

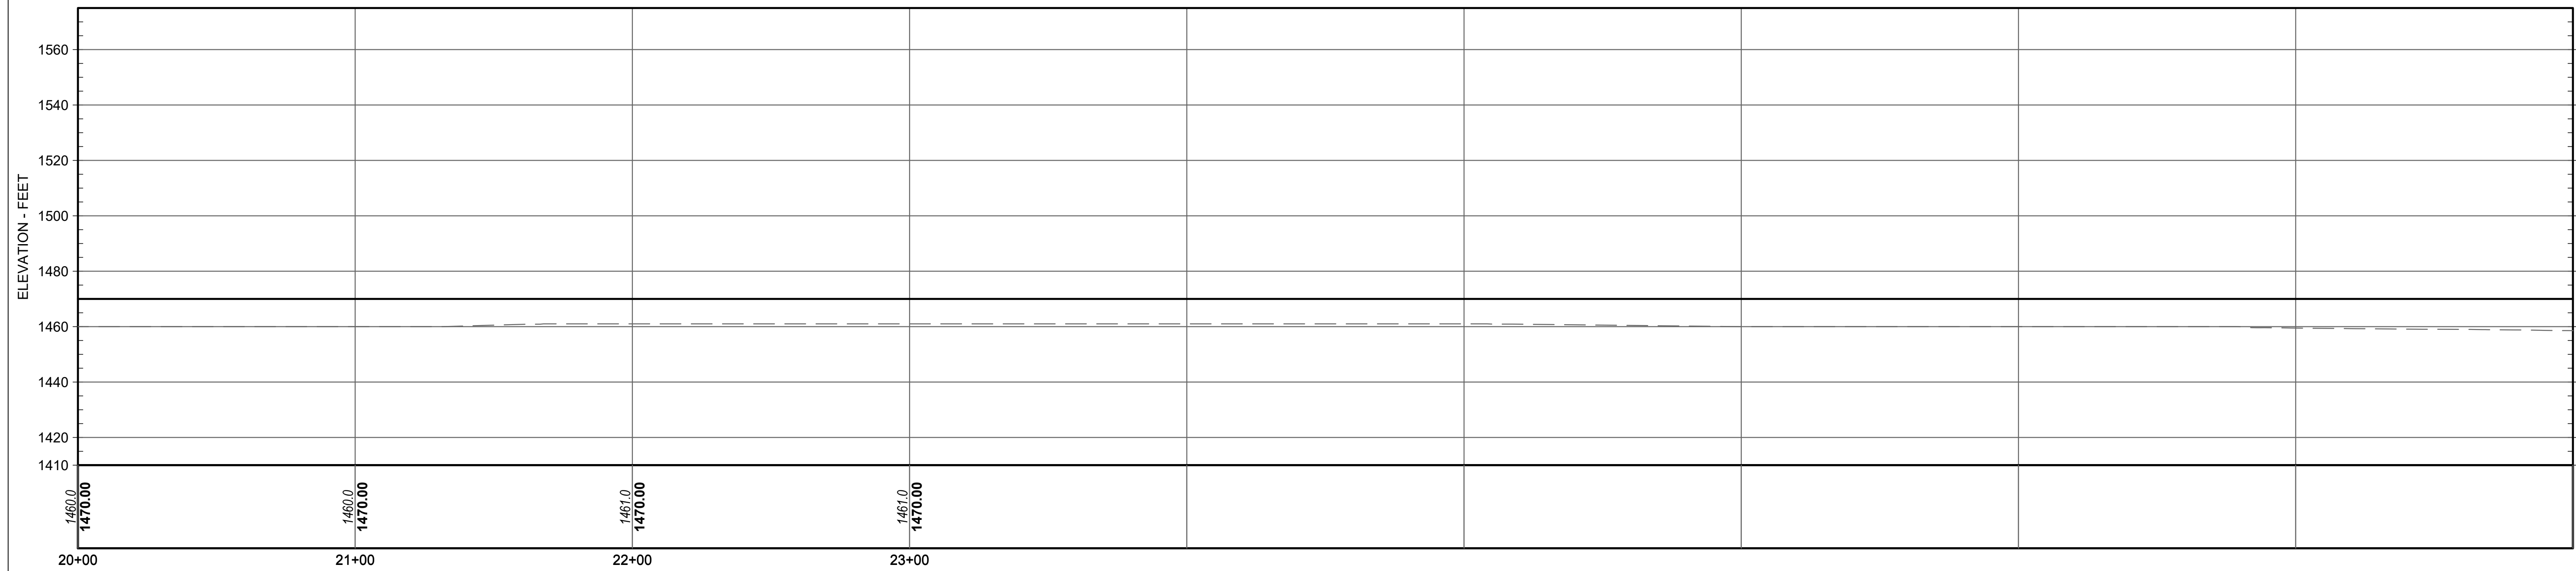


HORIZONTAL SCALE, FEET
0 30 60
VERTICAL SCALE, FEET
NO VERTICAL EXAGGERATION

PROFILE VIEW
STATION 22+00 TO 32+00
WEST DIKE


ELEVATIONS ARE REFERENCED TO NORTH AMERICAN VERTICAL DATUM 1988
AERIAL IMAGE FROM PRIOR TO CONSTRUCTION AND IS NOT REPRESENTATIVE OF FINAL PROFILES OR CONDITIONS

<p>Attention:</p> <p>If this scale bar does not measure 1" then drawing is not original scale.</p>	Designed: BJJ
	Drawn: BJJ
	Checked: JPB
	Approved: JPB
	P.E. No: 40594
GEI Project 2300038	




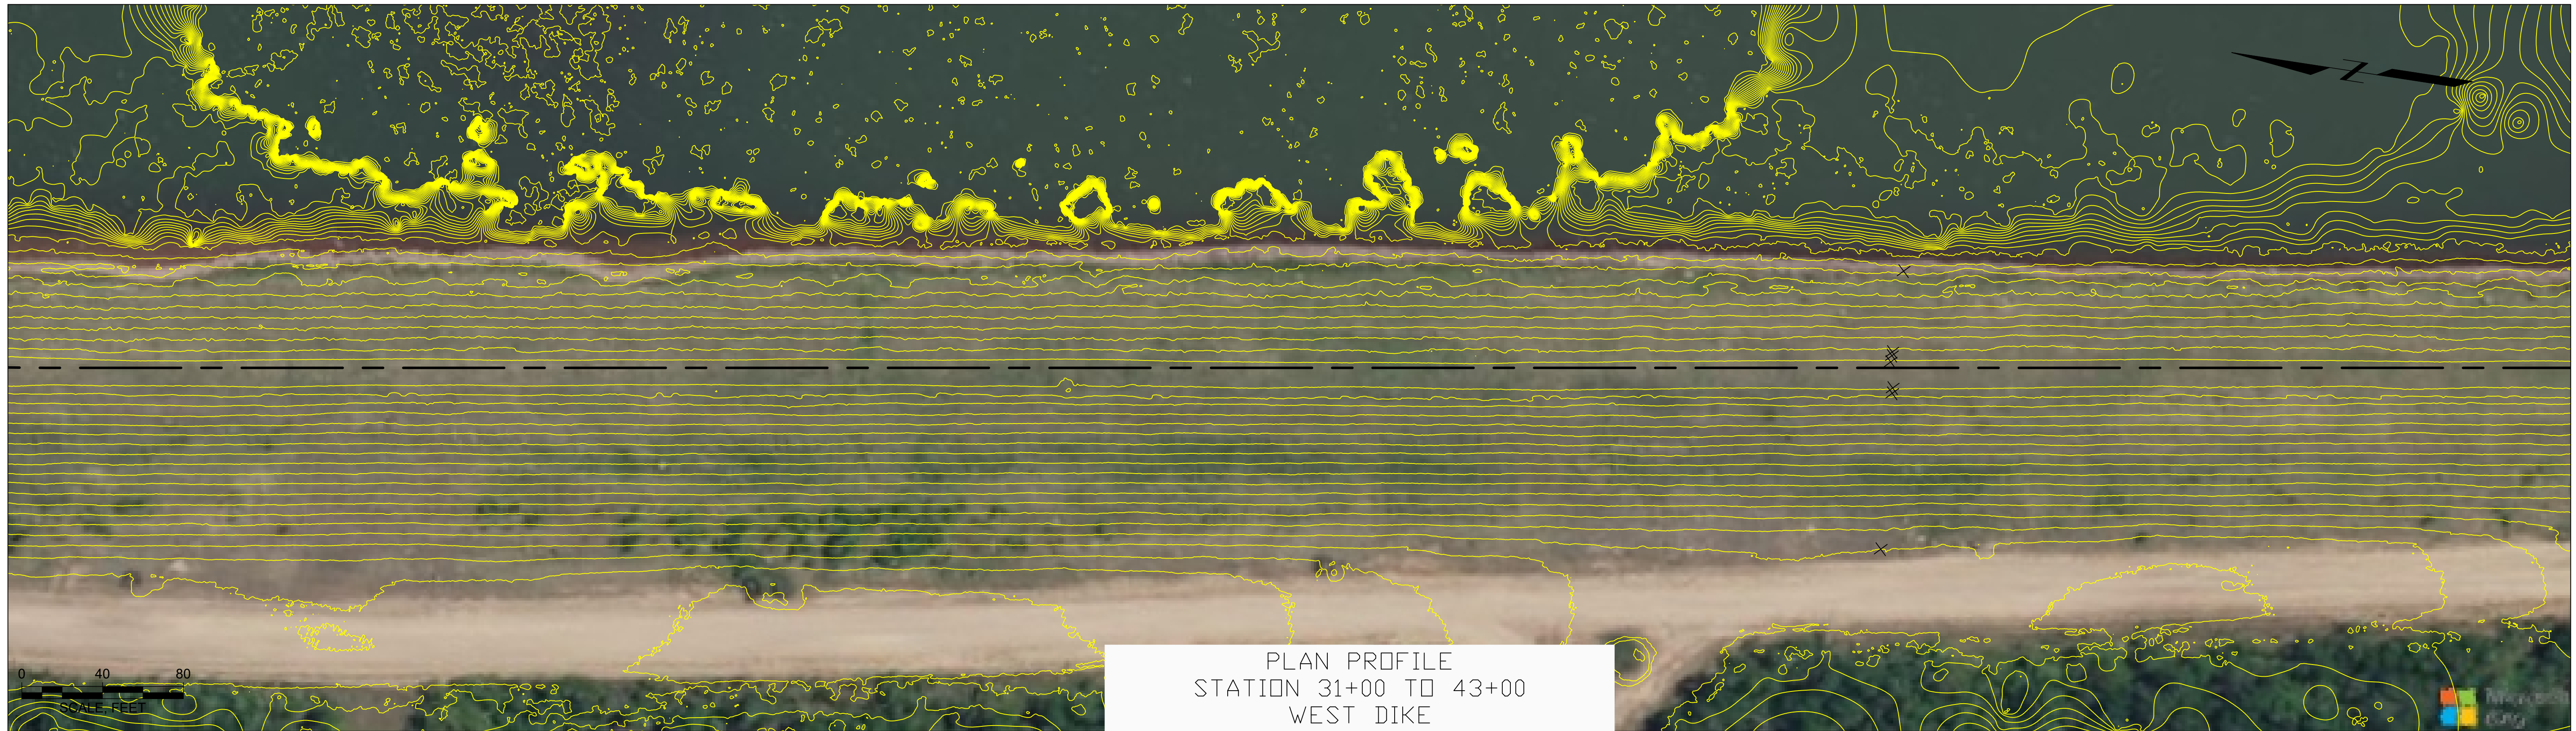

PLAN PROFILE
STATION 31+00 TO 43+00
WEST DIKE

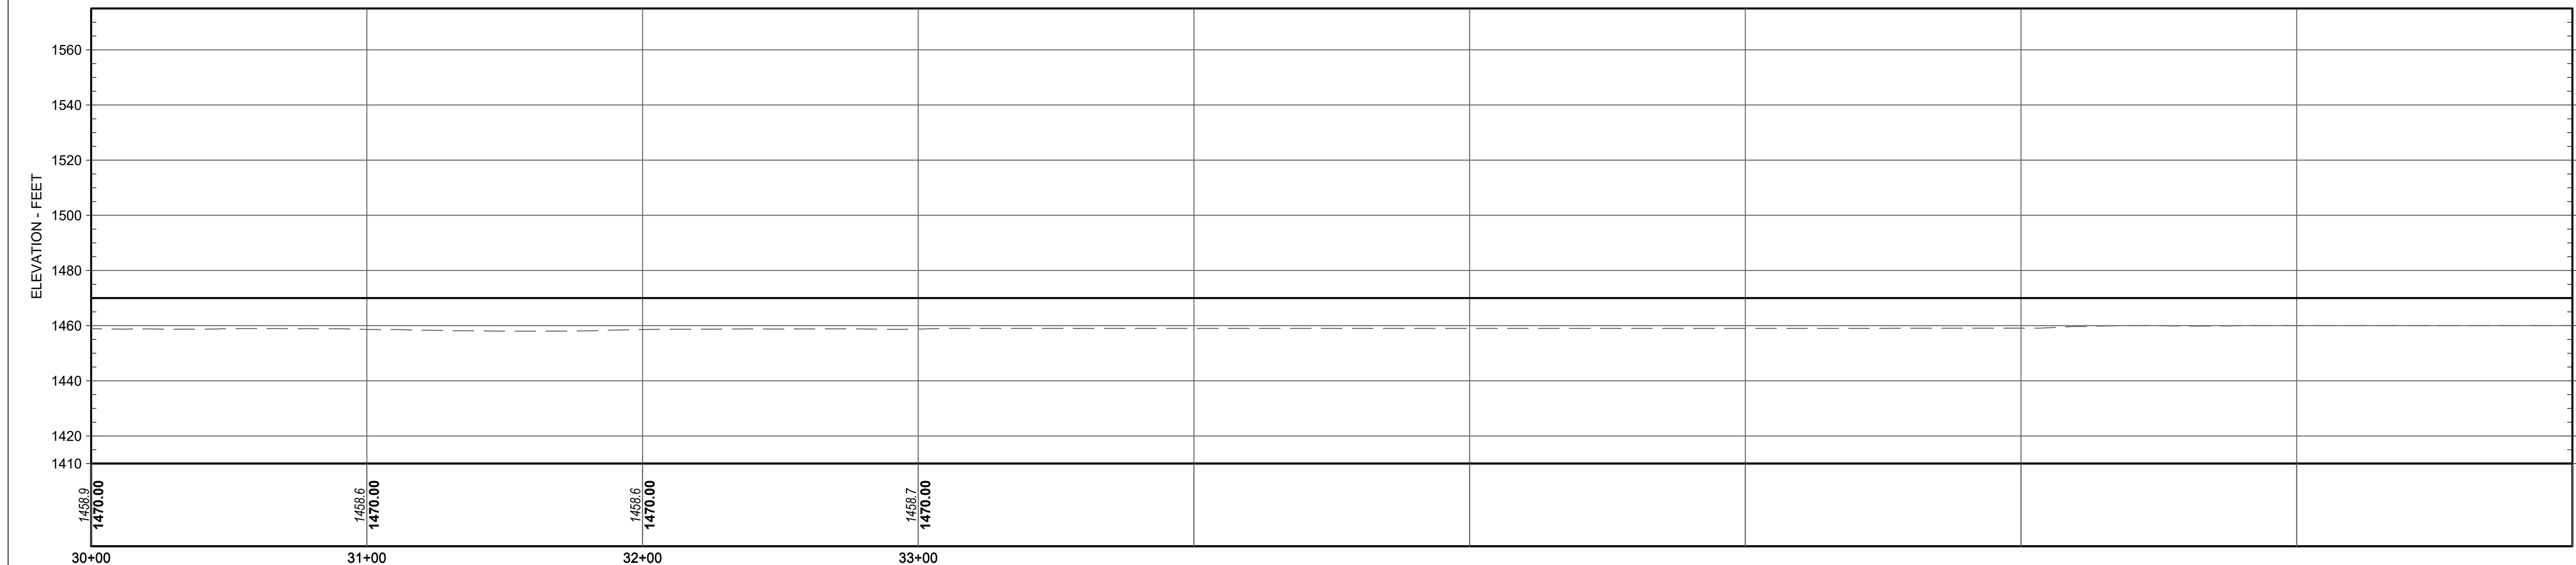


PROFILE VIEW
STATION 31+00 TO 43+00
WEST DIKE

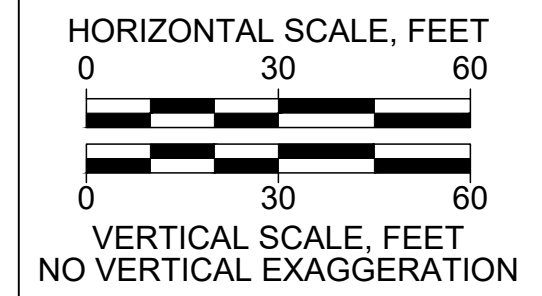


ELEVATIONS ARE REFERENCED TO NORTH AMERICAN VERTICAL DATUM 1988
AERIAL IMAGE FROM PRIOR TO CONSTRUCTION AND IS NOT REPRESENTATIVE OF FINAL PROFILES OR CONDITIONS

Attention: If this scale bar does not measure 1" then drawing is not original scale.	<i>Designed:</i> BJJ
	<i>Drawn:</i> BJJ
	<i>Checked:</i> JPB
	<i>Approved:</i> JPB
	<i>P.E. No:</i> 40594
<i>GEI Project</i> 2300038	



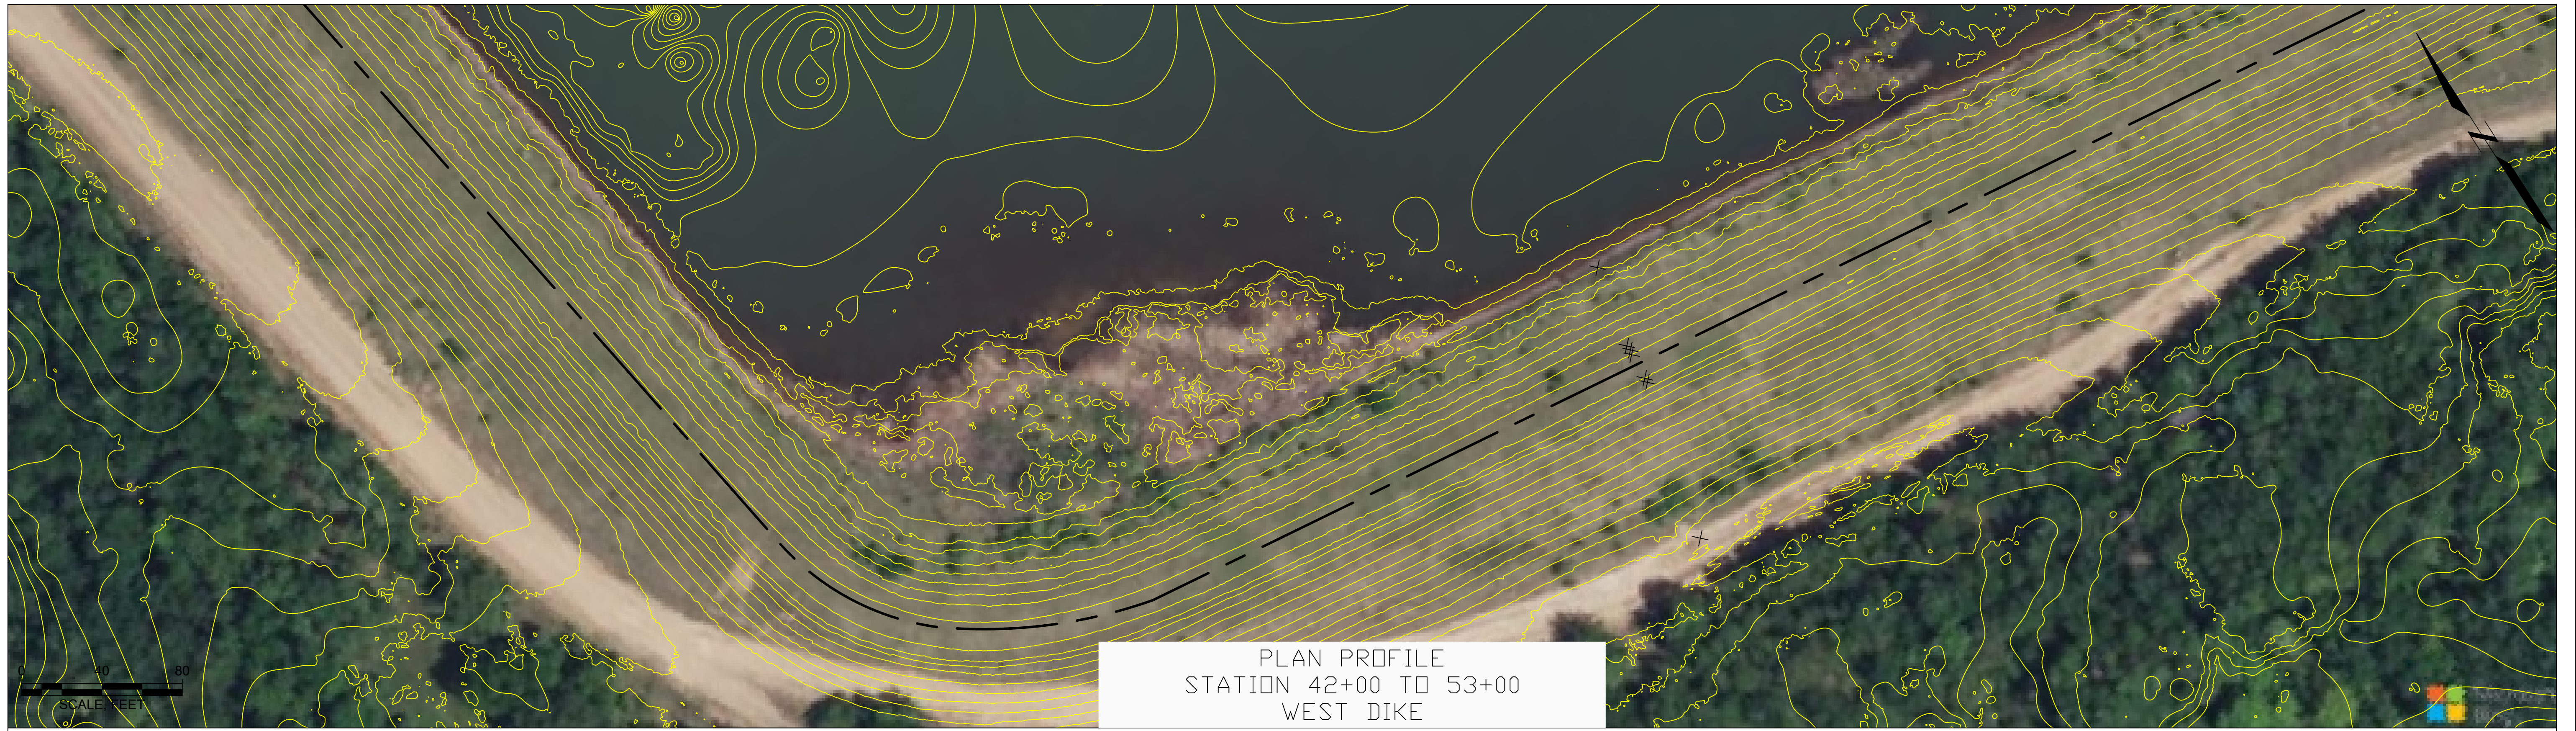

PLAN PROFILE
STATION 42+00 TO 53+00
WEST DIKE

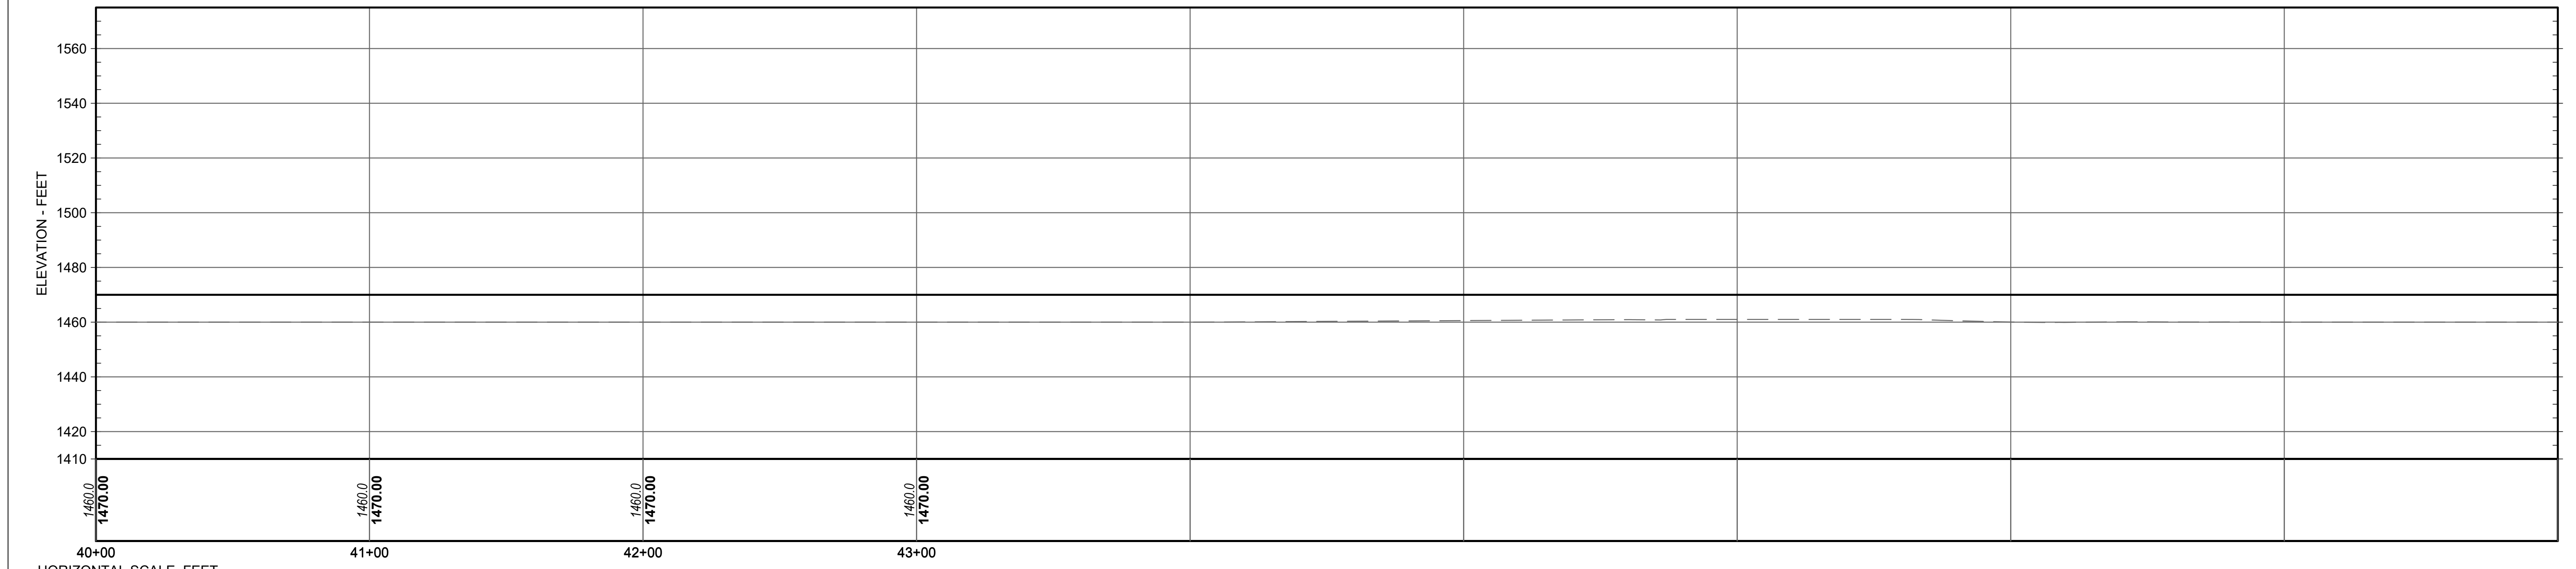


PROFILE VIEW
STATION 42+00 TO 53+00
WEST DIKE




HORIZONTAL SCALE, FEET
0 30 60
VERTICAL SCALE, FEET
NO VERTICAL EXAGGERATION

ELEVATIONS ARE REFERENCED TO NORTH AMERICAN VERTICAL DATUM 1988

AERIAL IMAGE FROM PRIOR TO CONSTRUCTION AND IS NOT REPRESENTATIVE OF FINAL PROFILES OR CONDITIONS


Attention:  If this scale bar does not measure 1" then drawing is not original scale.	Designed: BJF
	Drawn: BJF
	Checked: JPB
	Approved: JPB
	P.E. No: 40594
	GEI Project 2300038



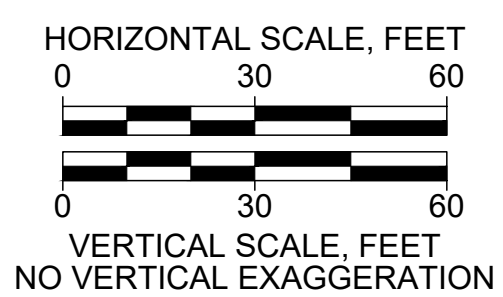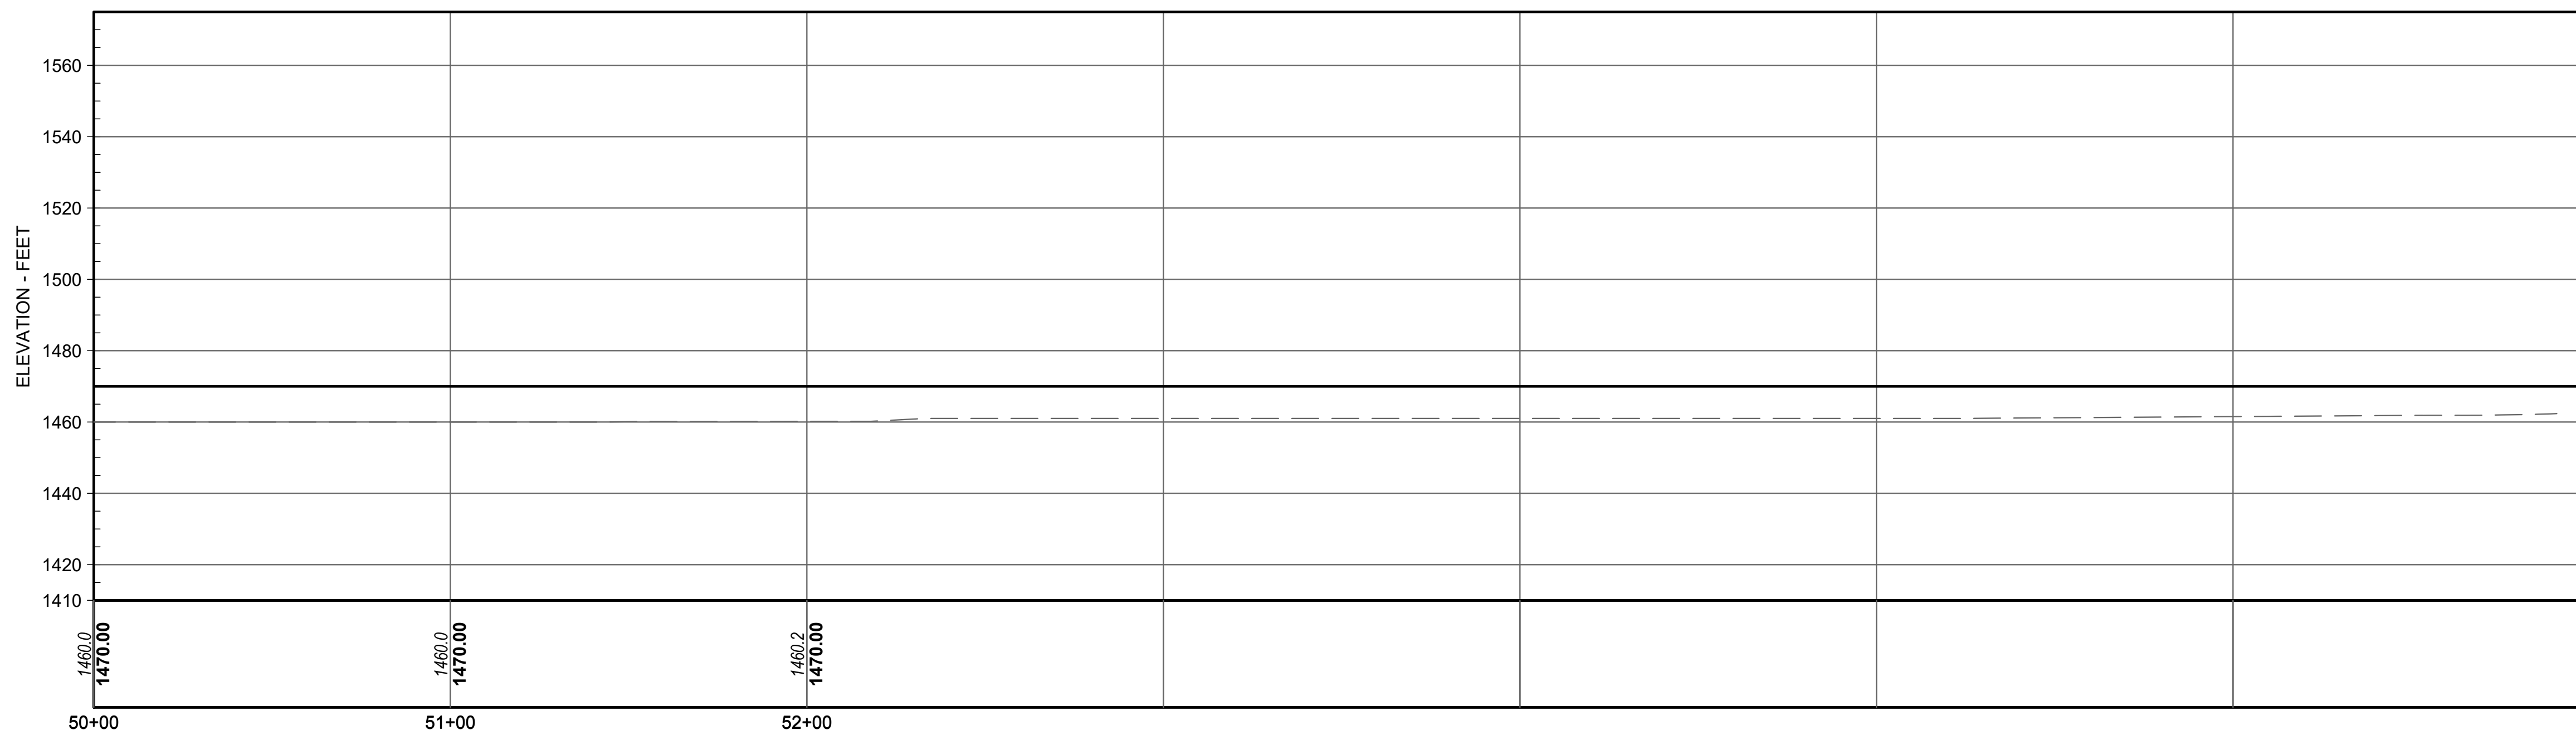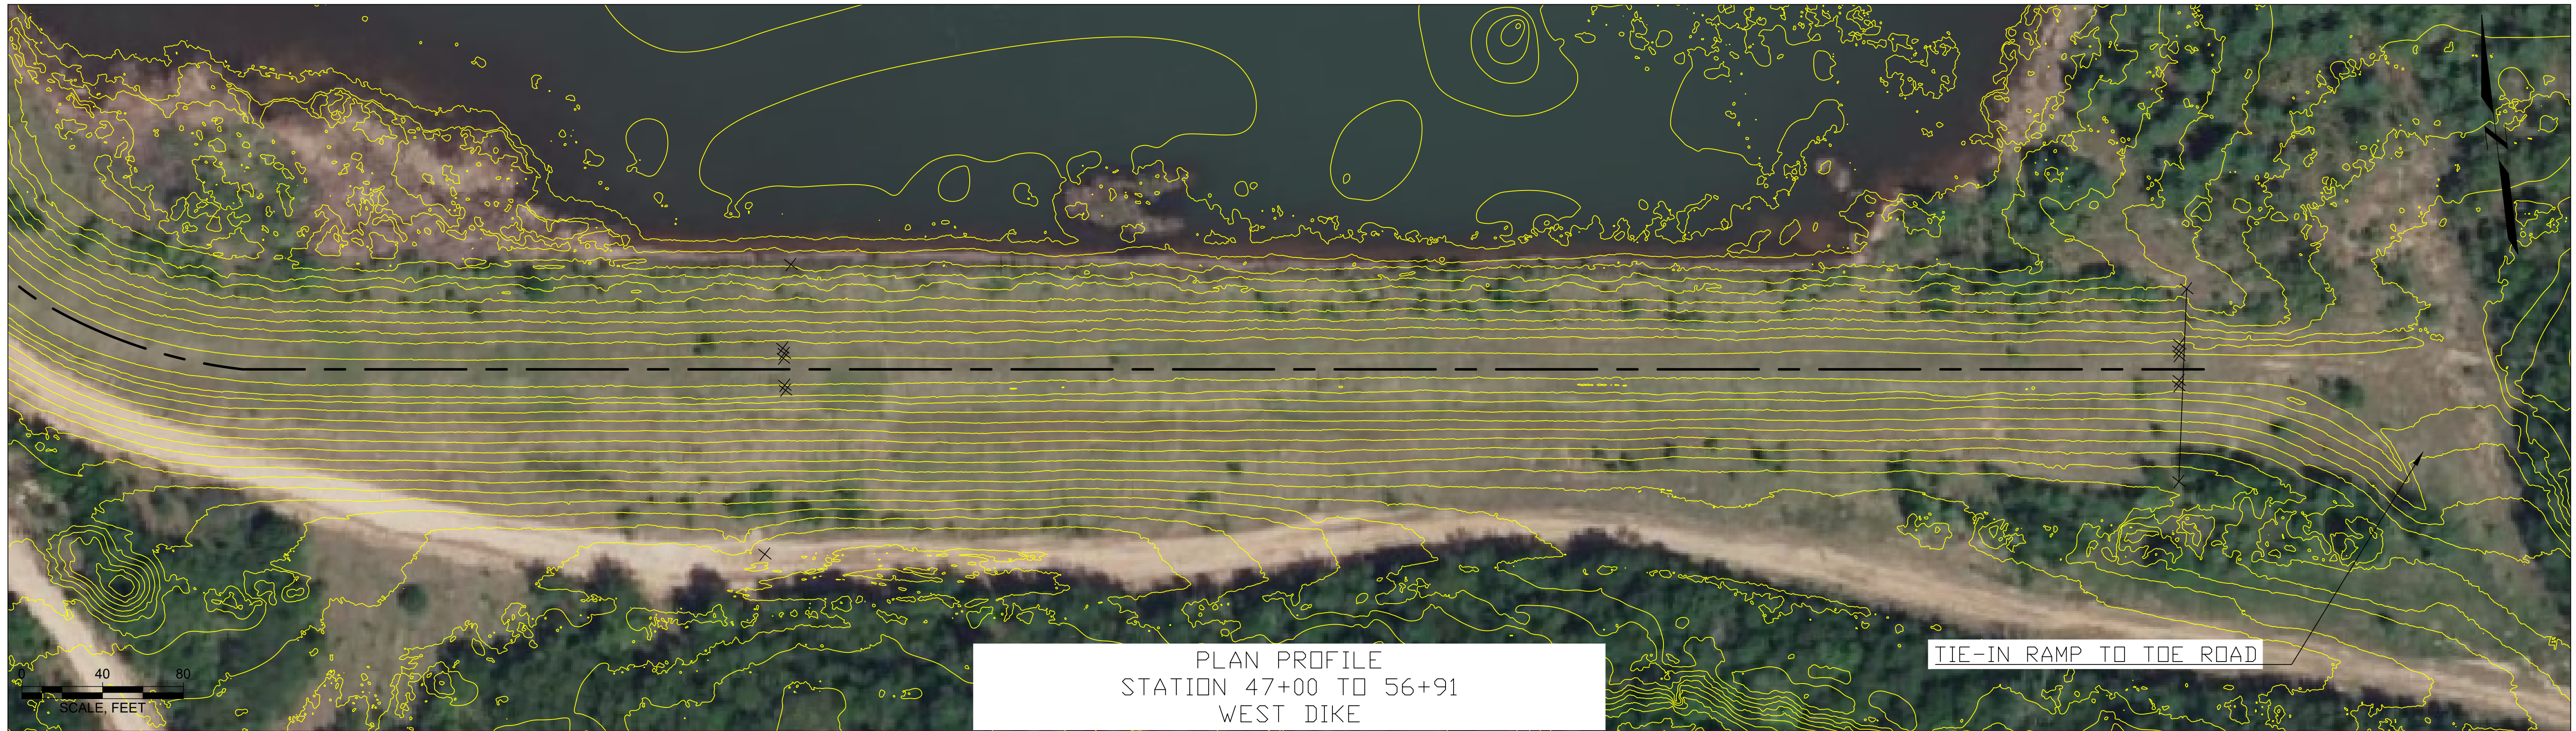


ELEVATIONS ARE REFERENCED TO NORTH AMERICAN VERTICAL DATUM 1988

AERIAL IMAGE FROM PRIOR TO CONSTRUCTION AND IS NOT REPRESENTATIVE OF FINAL PROFILES OR CONDITIONS


Attention:  If this scale bar does not measure 1" then drawing is not original scale.	Designed:	BJF
	Drawn:	BJF
	Checked:	JPB
	Approved:	JPB
	P.E. No:	40594
GEI Project		2200074



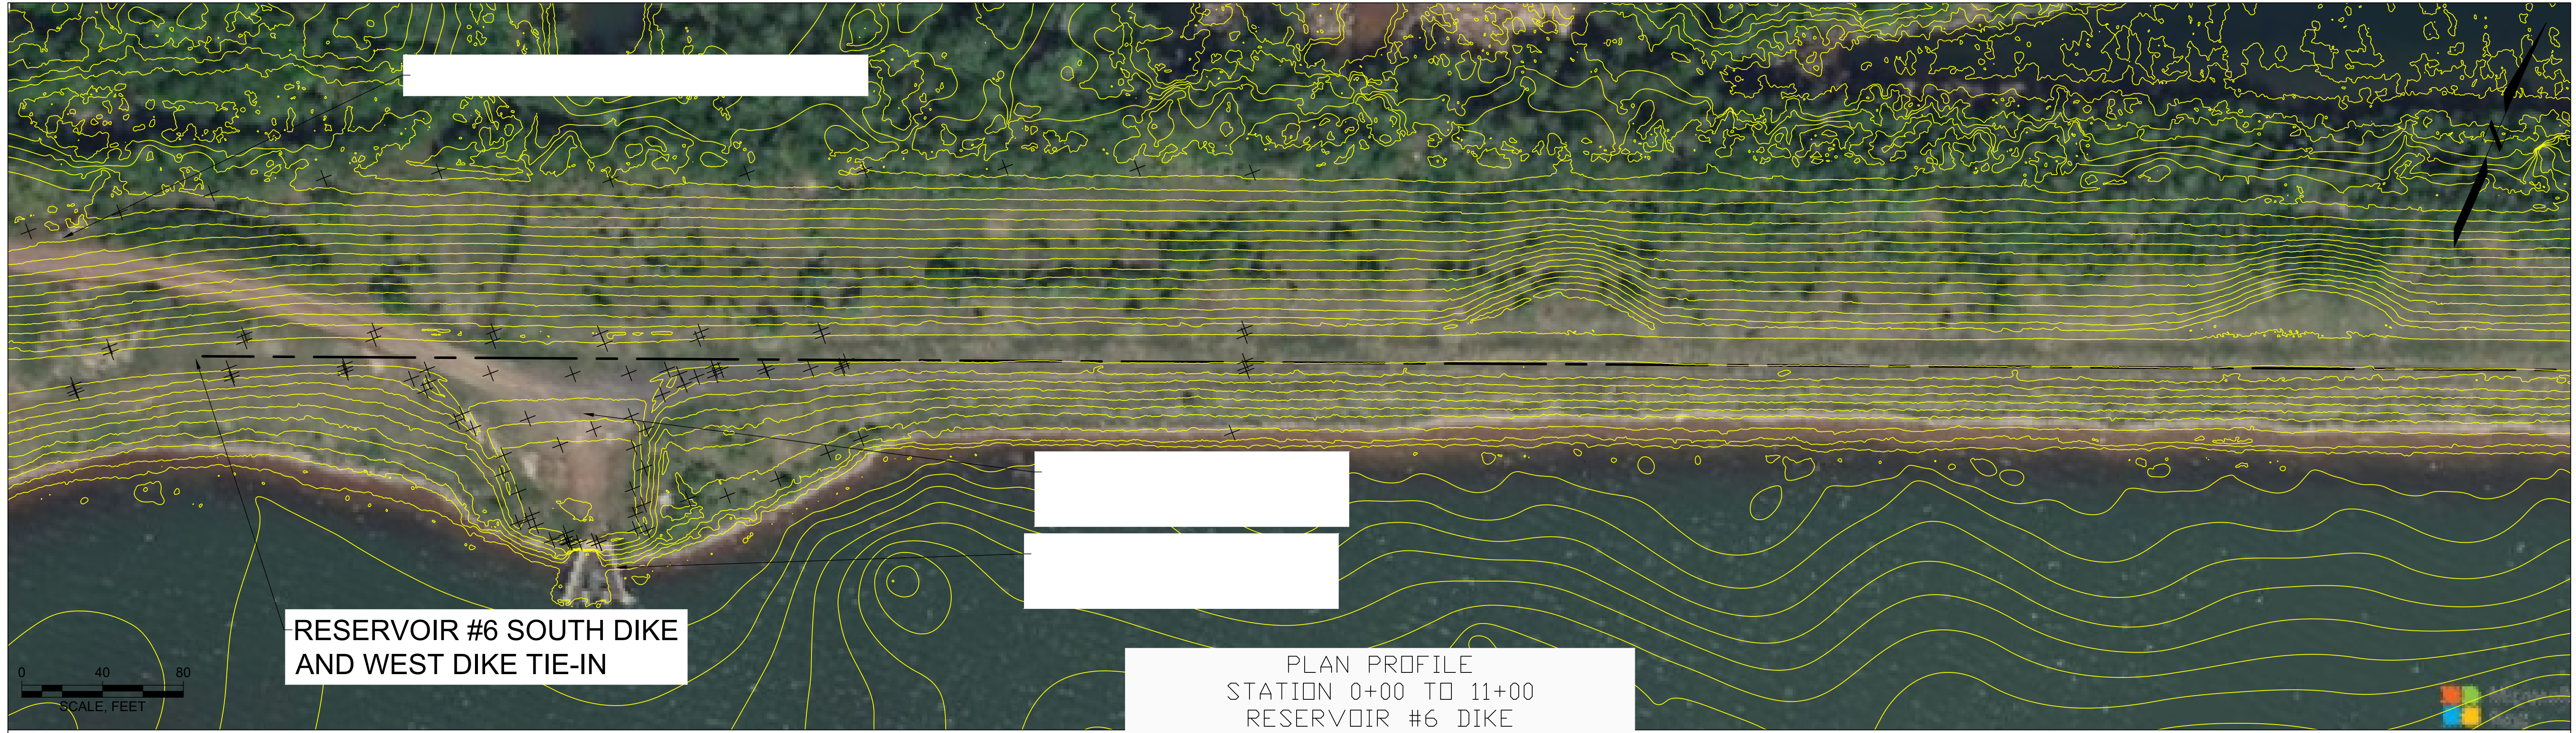


RESERVOIR #6 SOUTH DIKE
AND WEST DIKE TIE-IN

PLAN PROFILE
STATION 0+00 TO 11+00
RESERVOIR #6 DIKE

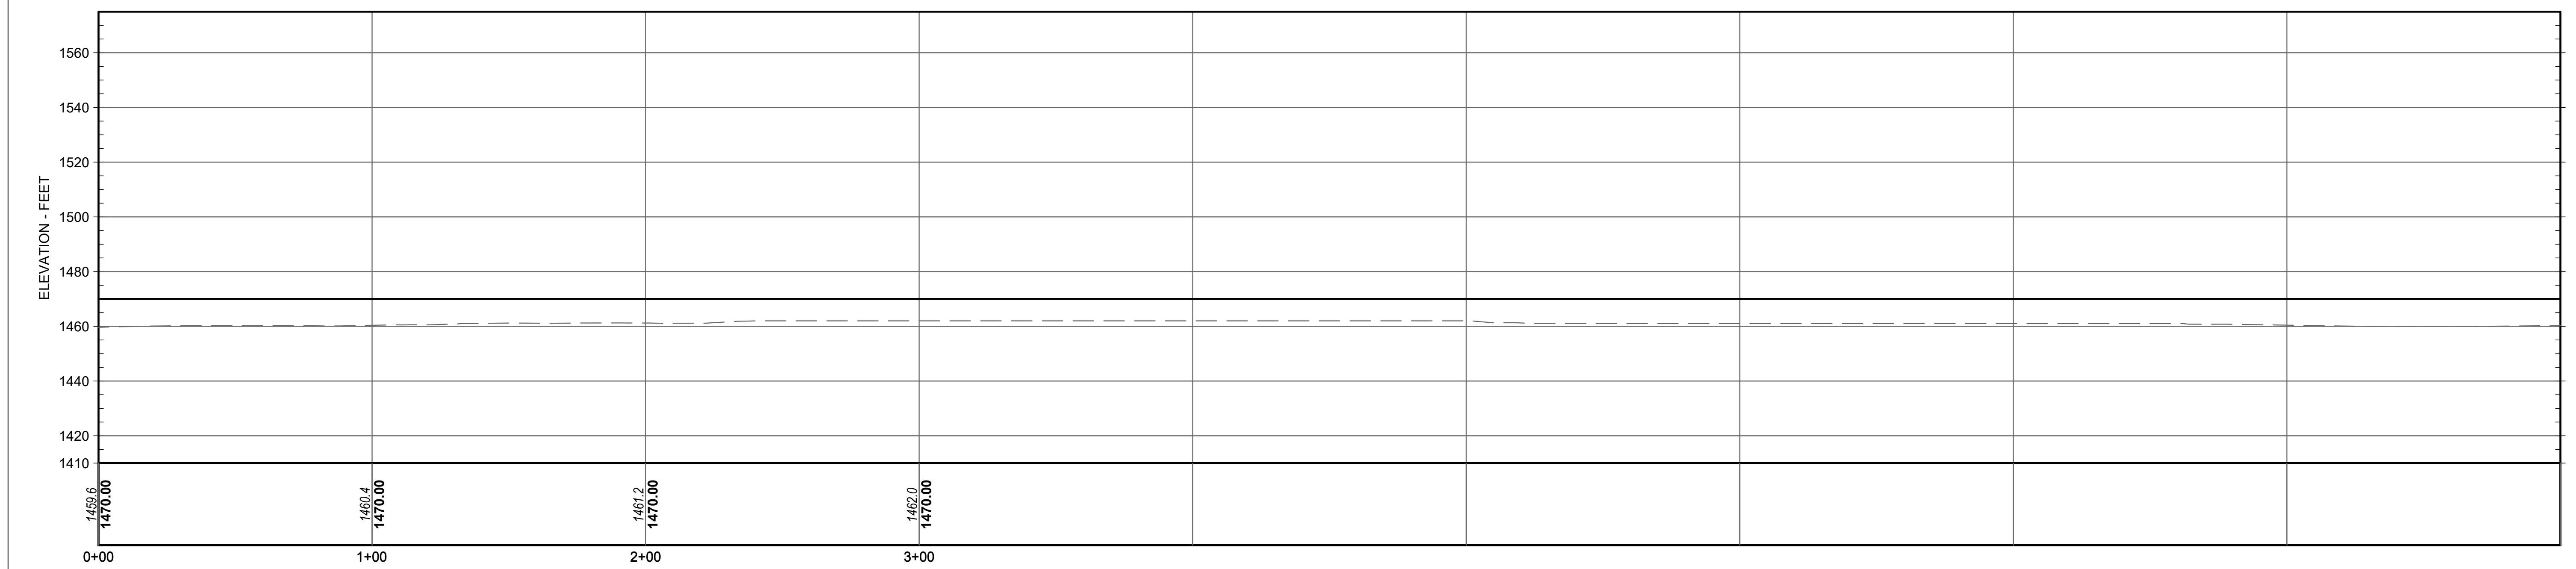

PROFILE VIEW
STATION 0+00 TO 11+00
RESRVOIR # 6 DIKE

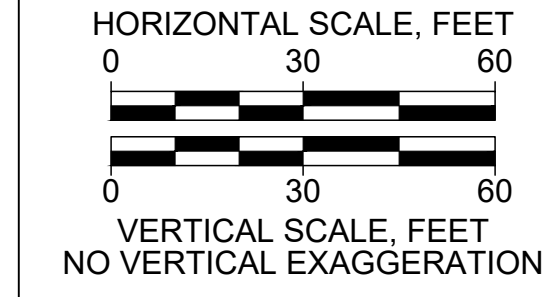


ELEVATIONS ARE REFERENCED TO NORTH
AMERICAN VERTICAL DATUM 1988


AERIAL IMAGE FROM PRIOR TO CONSTRUCTION AND IS
NOT REPRESENTATIVE OF FINAL PROFILES OR CONDITIONS

<p>Attention:</p> <p>If this scale bar does not measure 1" then drawing is not original scale.</p>	Designed: BJF
	Drawn: BJF
	Checked: JPB
	Approved: JPB
	P.E. No: 40594
GEI Project 2300038	



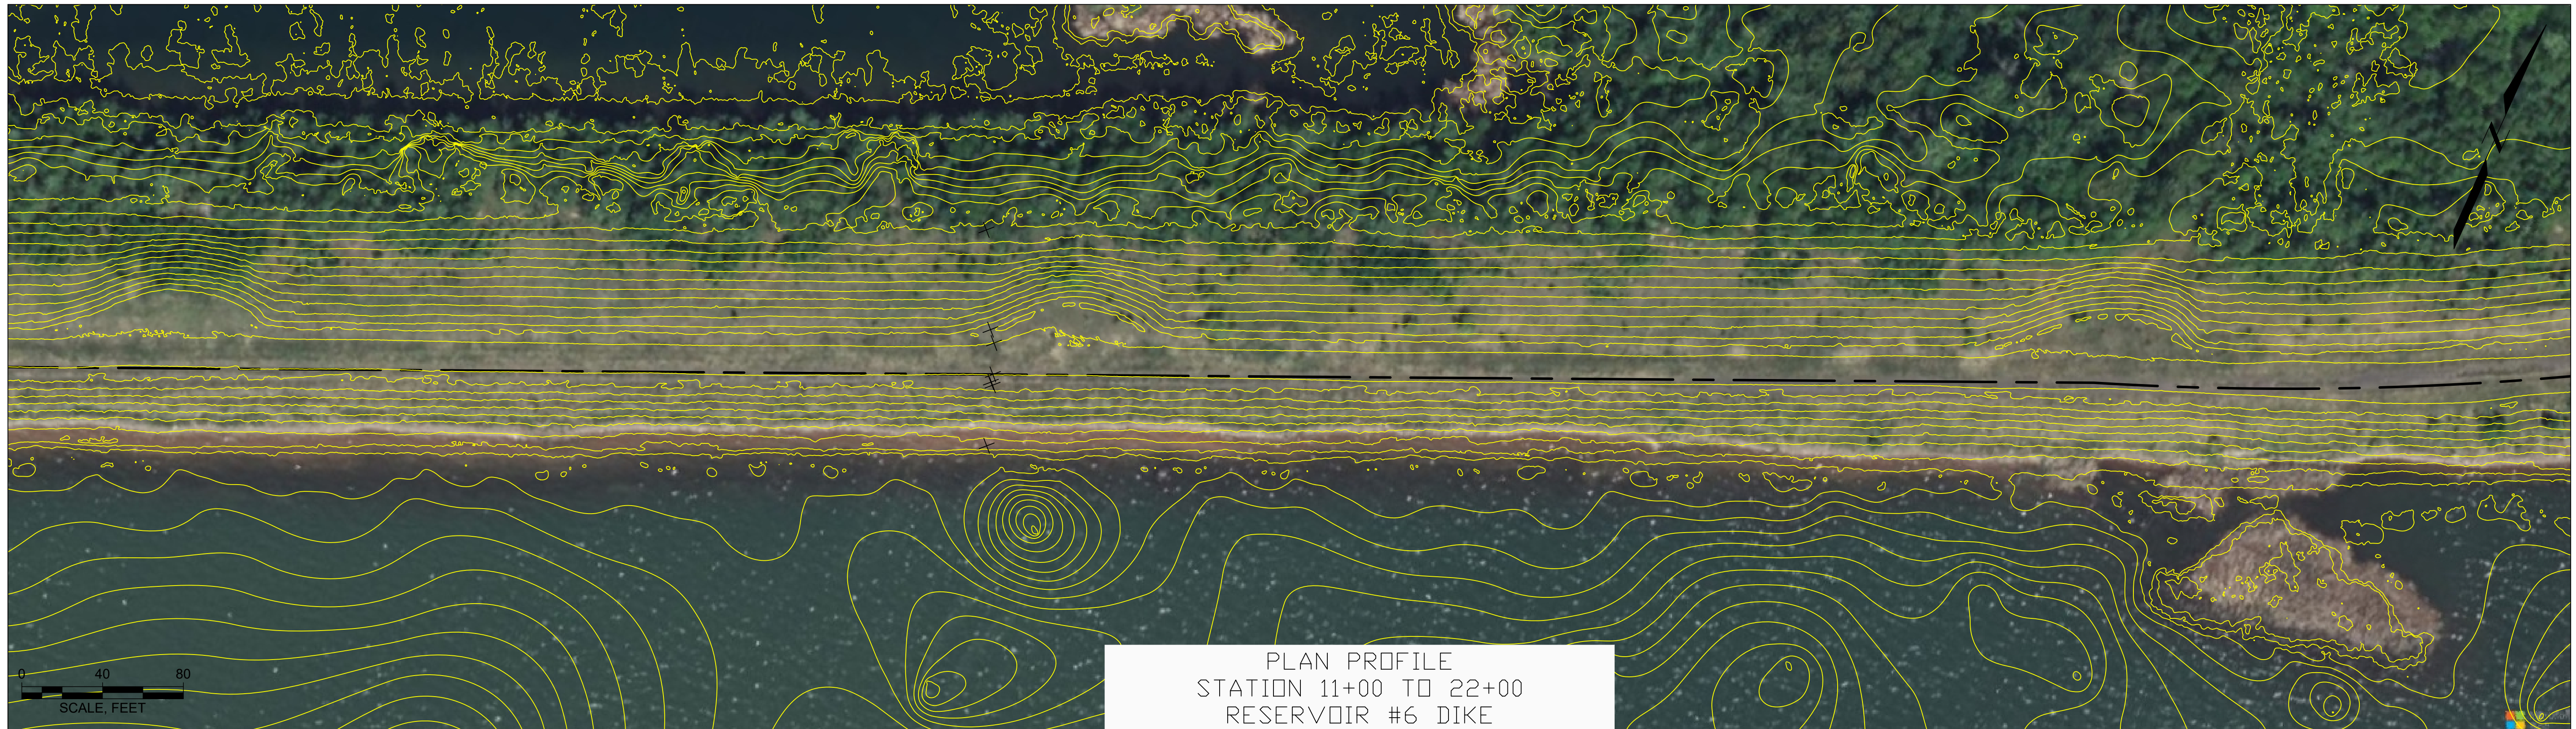

PLAN PROFILE
STATION 11+00 TO 22+00
RESERVOIR #6 DIKE

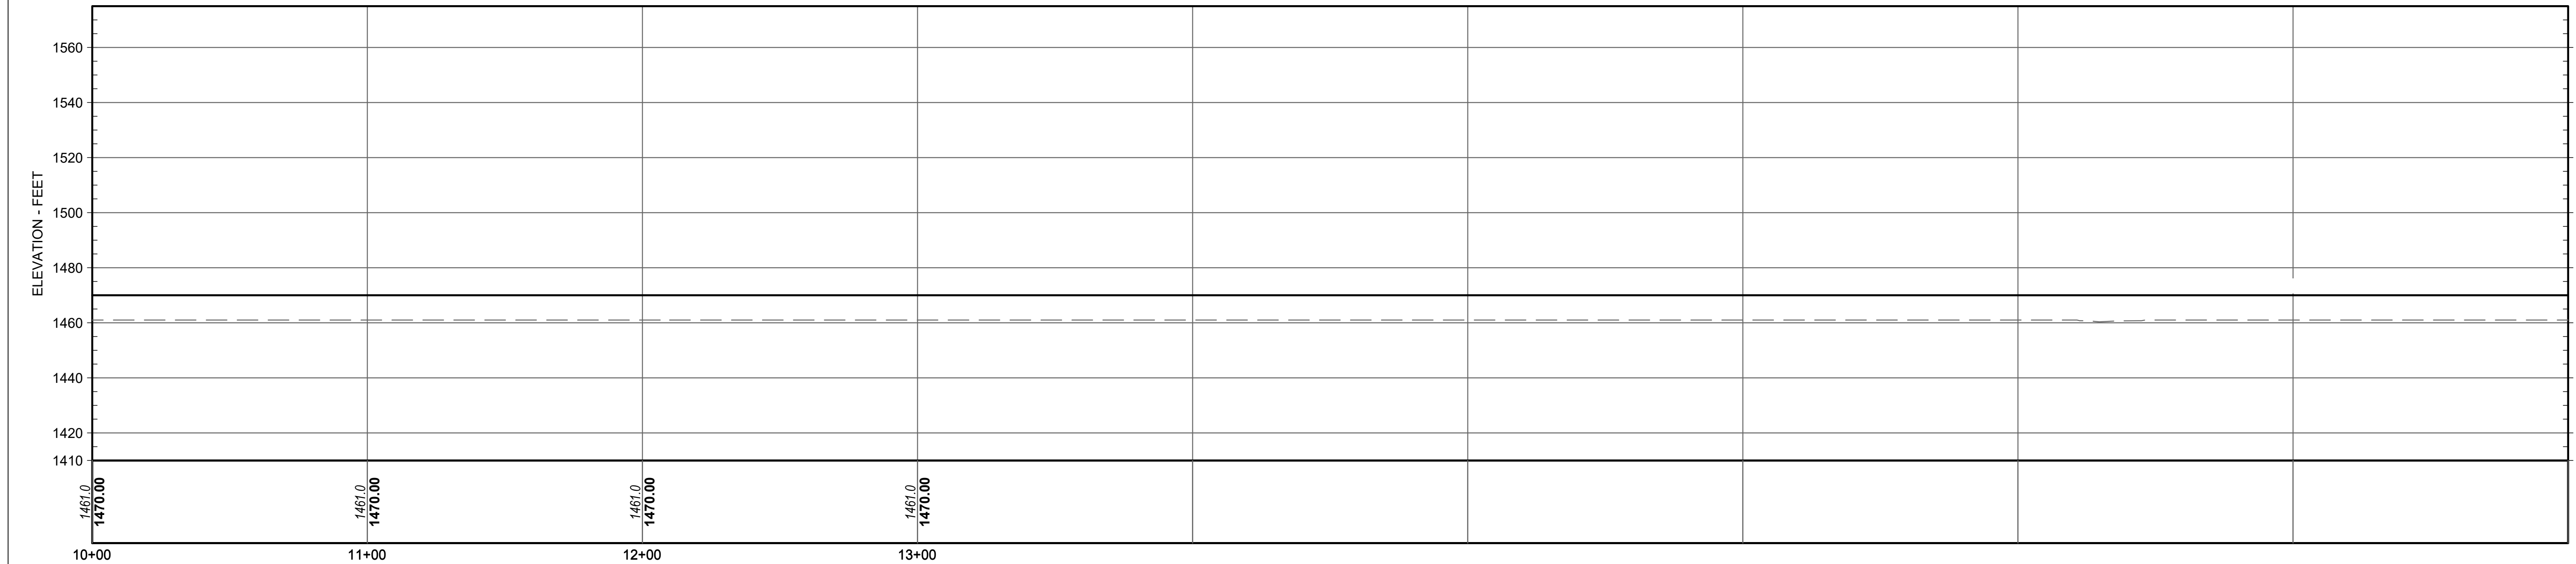

HORIZONTAL SCALE, FEET
0 30 60
VERTICAL SCALE, FEET
NO VERTICAL EXAGGERATION
0 30 60

PROFILE VIEW
STATION 11+00 TO 22+00
RESRVOIR # 6 DIKE

ELEVATIONS ARE REFERENCED TO NORTH AMERICAN VERTICAL DATUM 1988
AERIAL IMAGE FROM PRIOR TO CONSTRUCTION AND IS NOT REPRESENTATIVE OF FINAL PROFILES OR CONDITIONS




Attention:
0 1"
If this scale bar does not measure 1" then drawing is not original scale.

Designed:	BJF
Drawn:	BJF
Checked:	JPB
Approved:	JPB
P.E. No.:	40594
GEI Project:	2300038





PLAN PROFILE
STATION 26+00 TO 36+00
RESERVOIR #6 DIKE

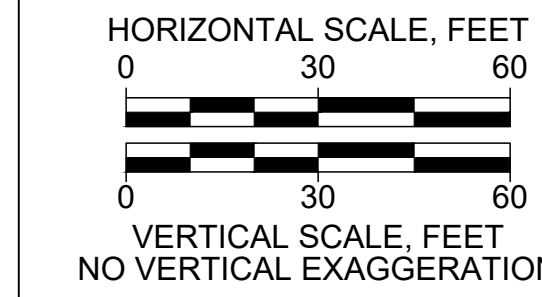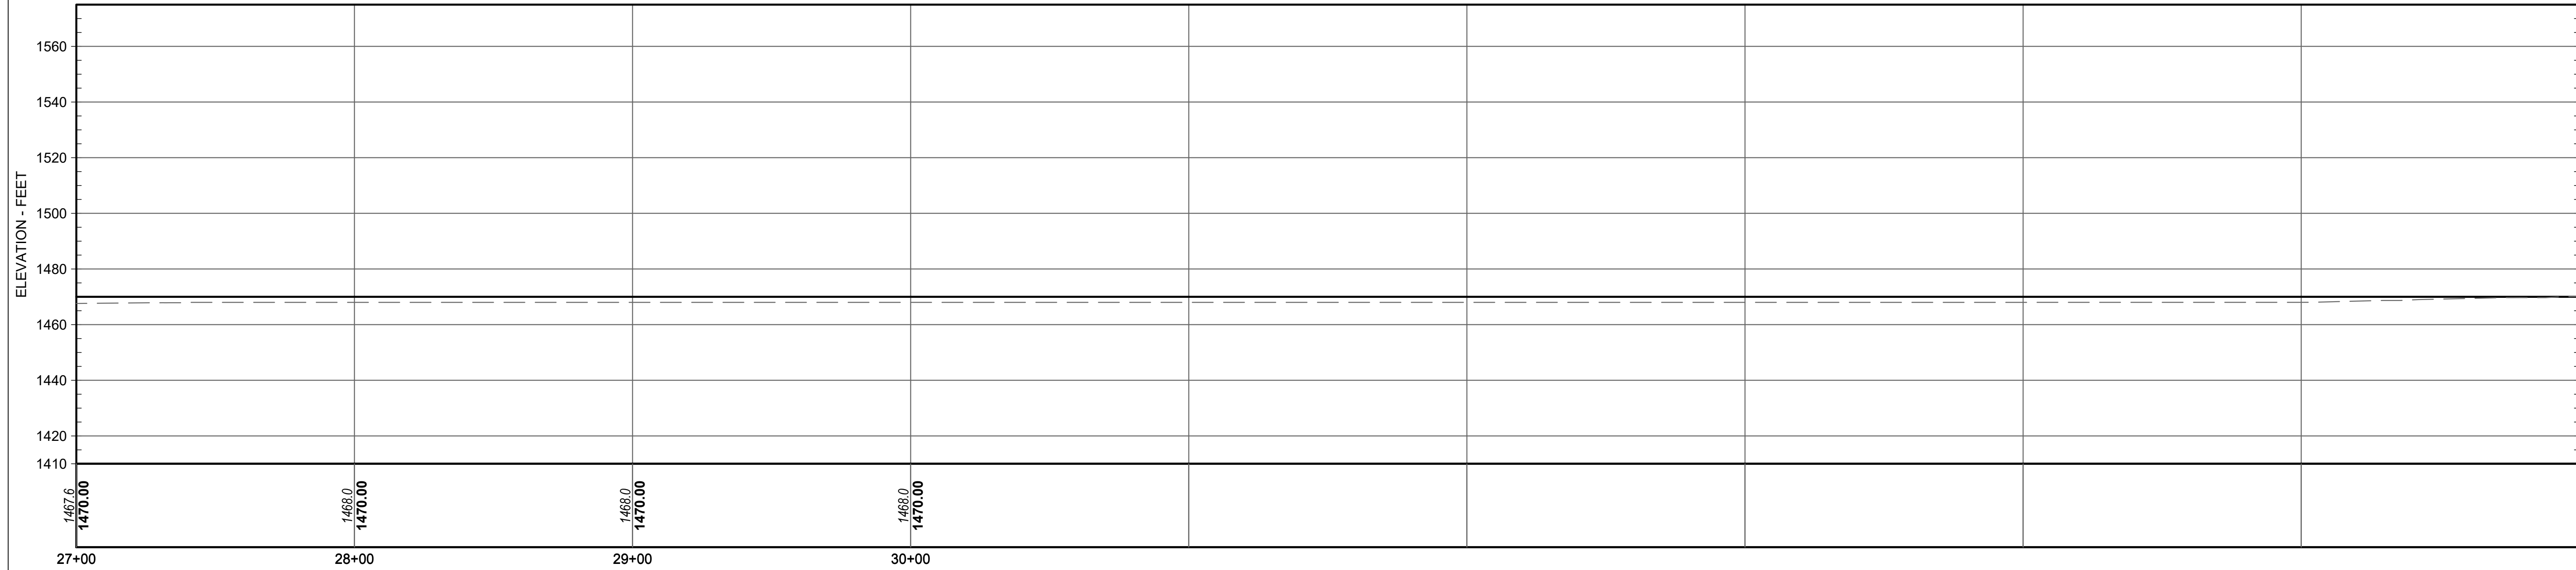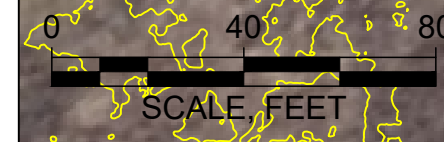




PROFILE VIEW
STATION 26+00 TO 36+00
RESRVOIR # 6 DIKE

ELEVATIONS ARE REFERENCED TO NORTH
AMERICAN VERTICAL DATUM 1988

AERIAL IMAGE FROM PRIOR TO CONSTRUCTION AND IS
NOT REPRESENTATIVE OF FINAL PROFILES OR CONDITIONS

<p>Attention:</p> <p>If this scale bar does not measure 1" then drawing is not original scale.</p>	Designed: BJJ
	Drawn: BJJ
	Checked: JPB
	Approved: JPB
	P.E. No: 40594
GEI Project 2300038	




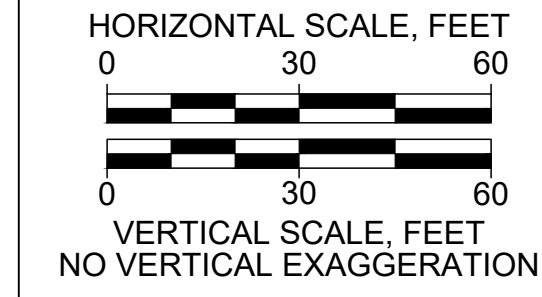
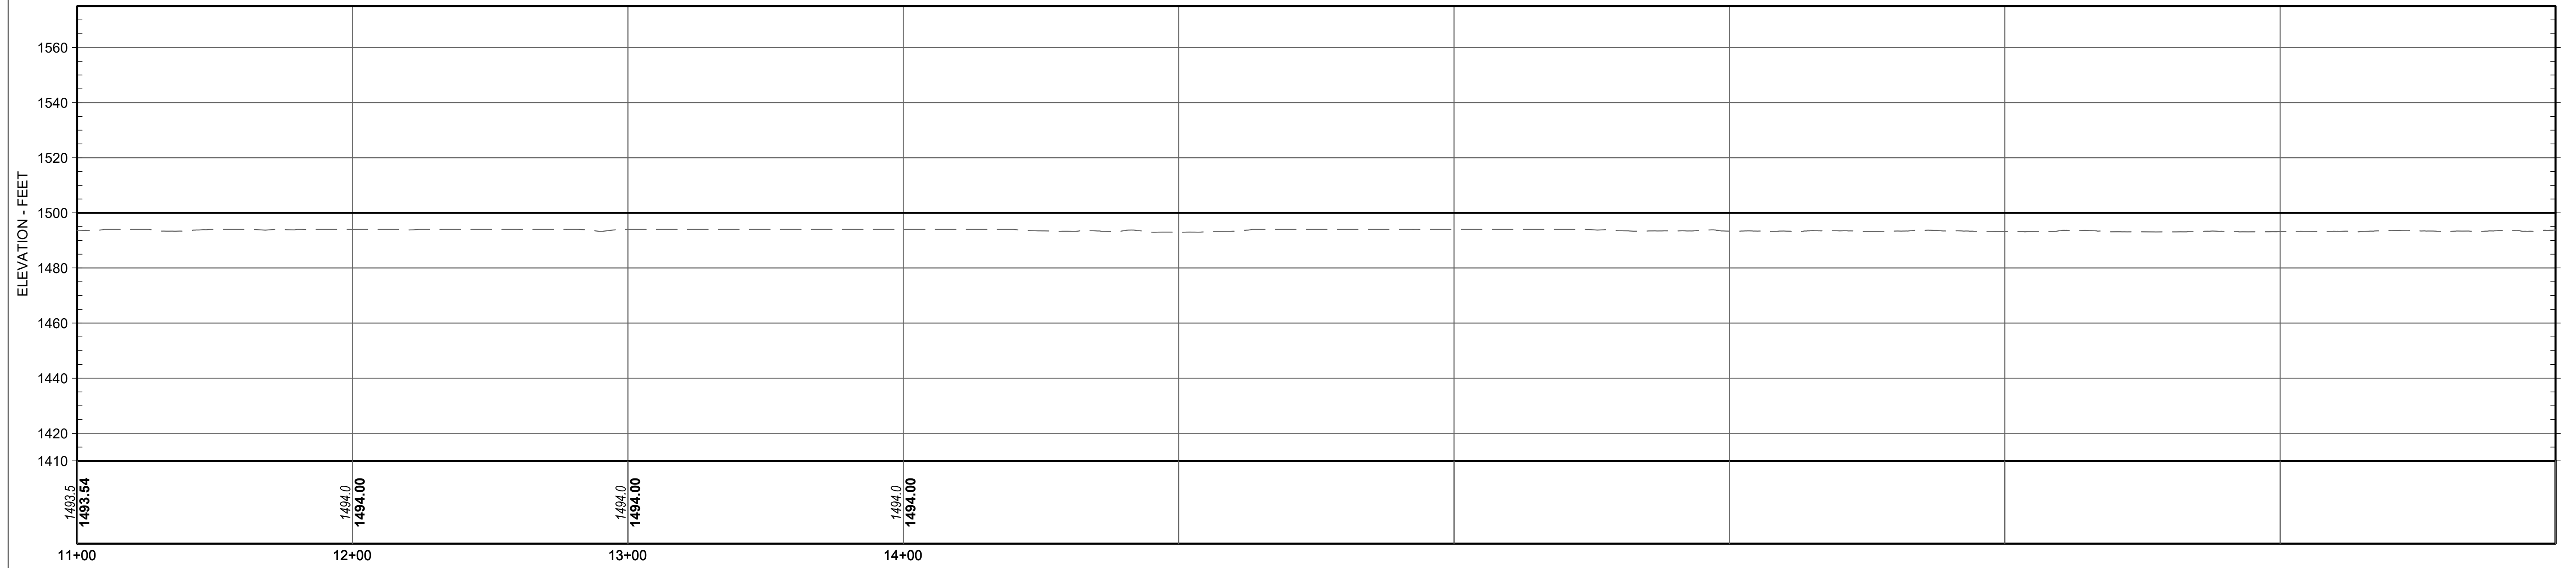
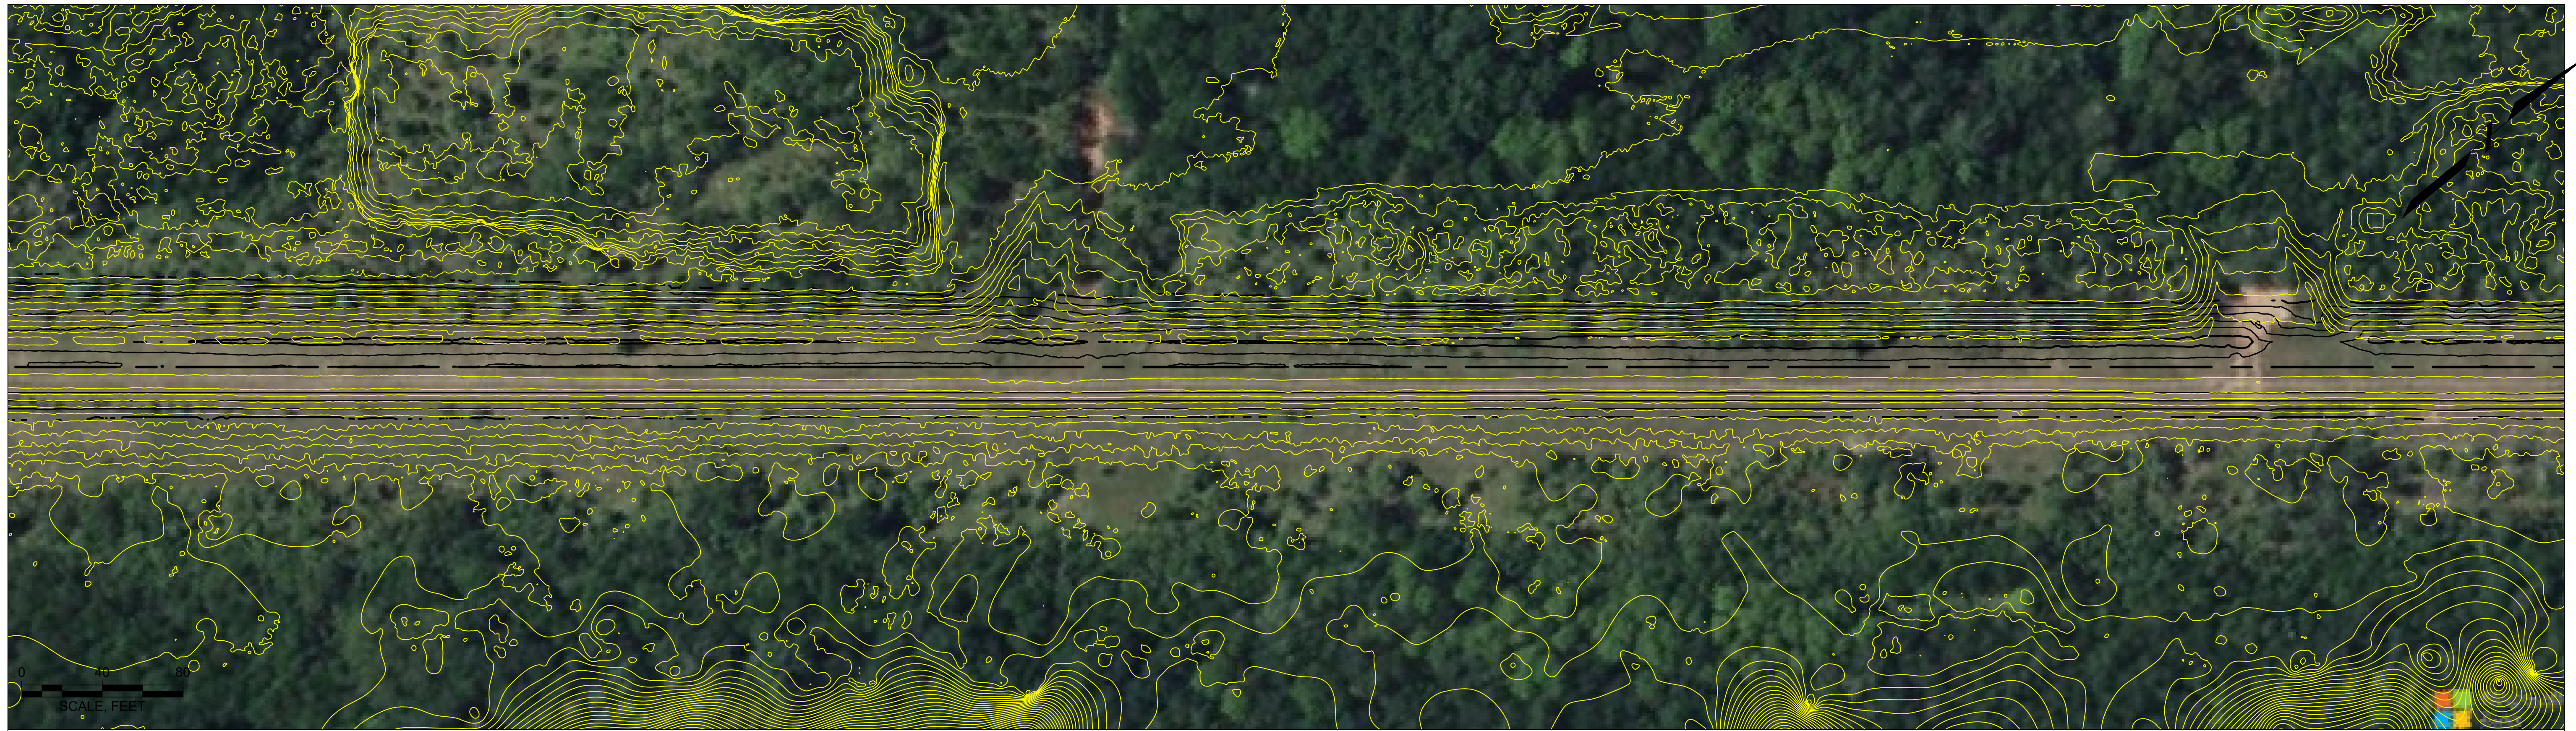


ELEVATIONS ARE REFERENCED TO NORTH AMERICAN VERTICAL DATUM 1988
 AERIAL IMAGE FROM PRIOR TO CONSTRUCTION AND IS NOT REPRESENTATIVE OF FINAL PROFILES OR CONDITIONS

Attention:
 0 1"
 If this scale bar does not measure 1" then drawing is not original scale.

Designed:	BJF
Drawn:	BJF
Checked:	JPB
Approved:	JPB
P.E. No.:	40594
GEI Project:	2300038


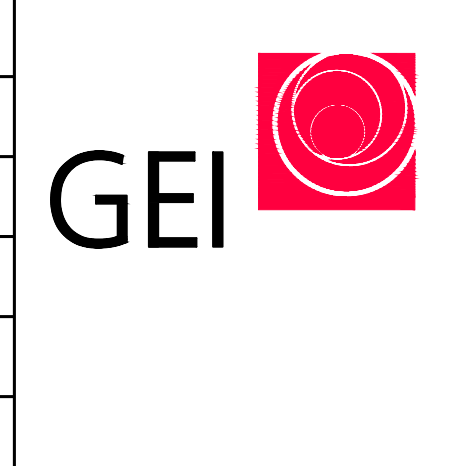


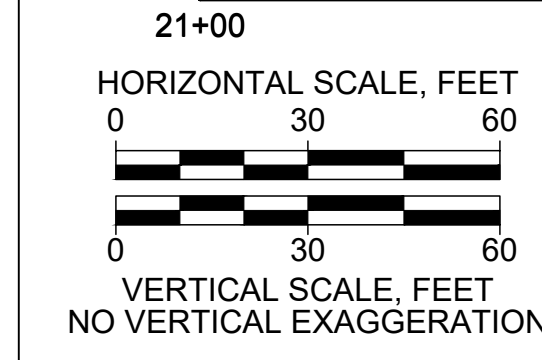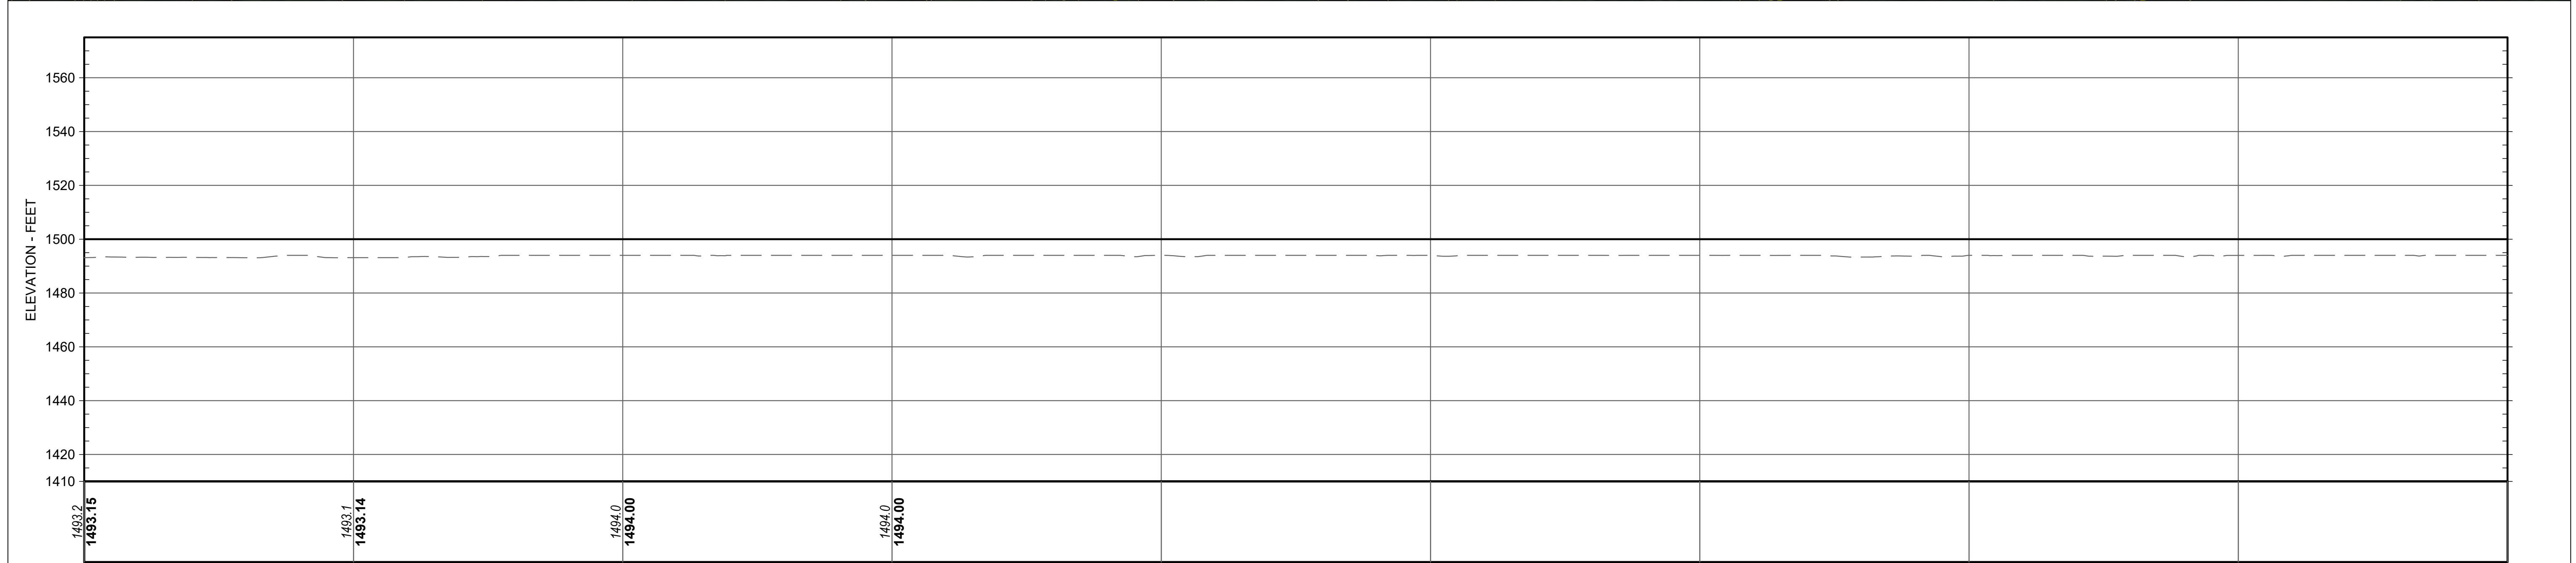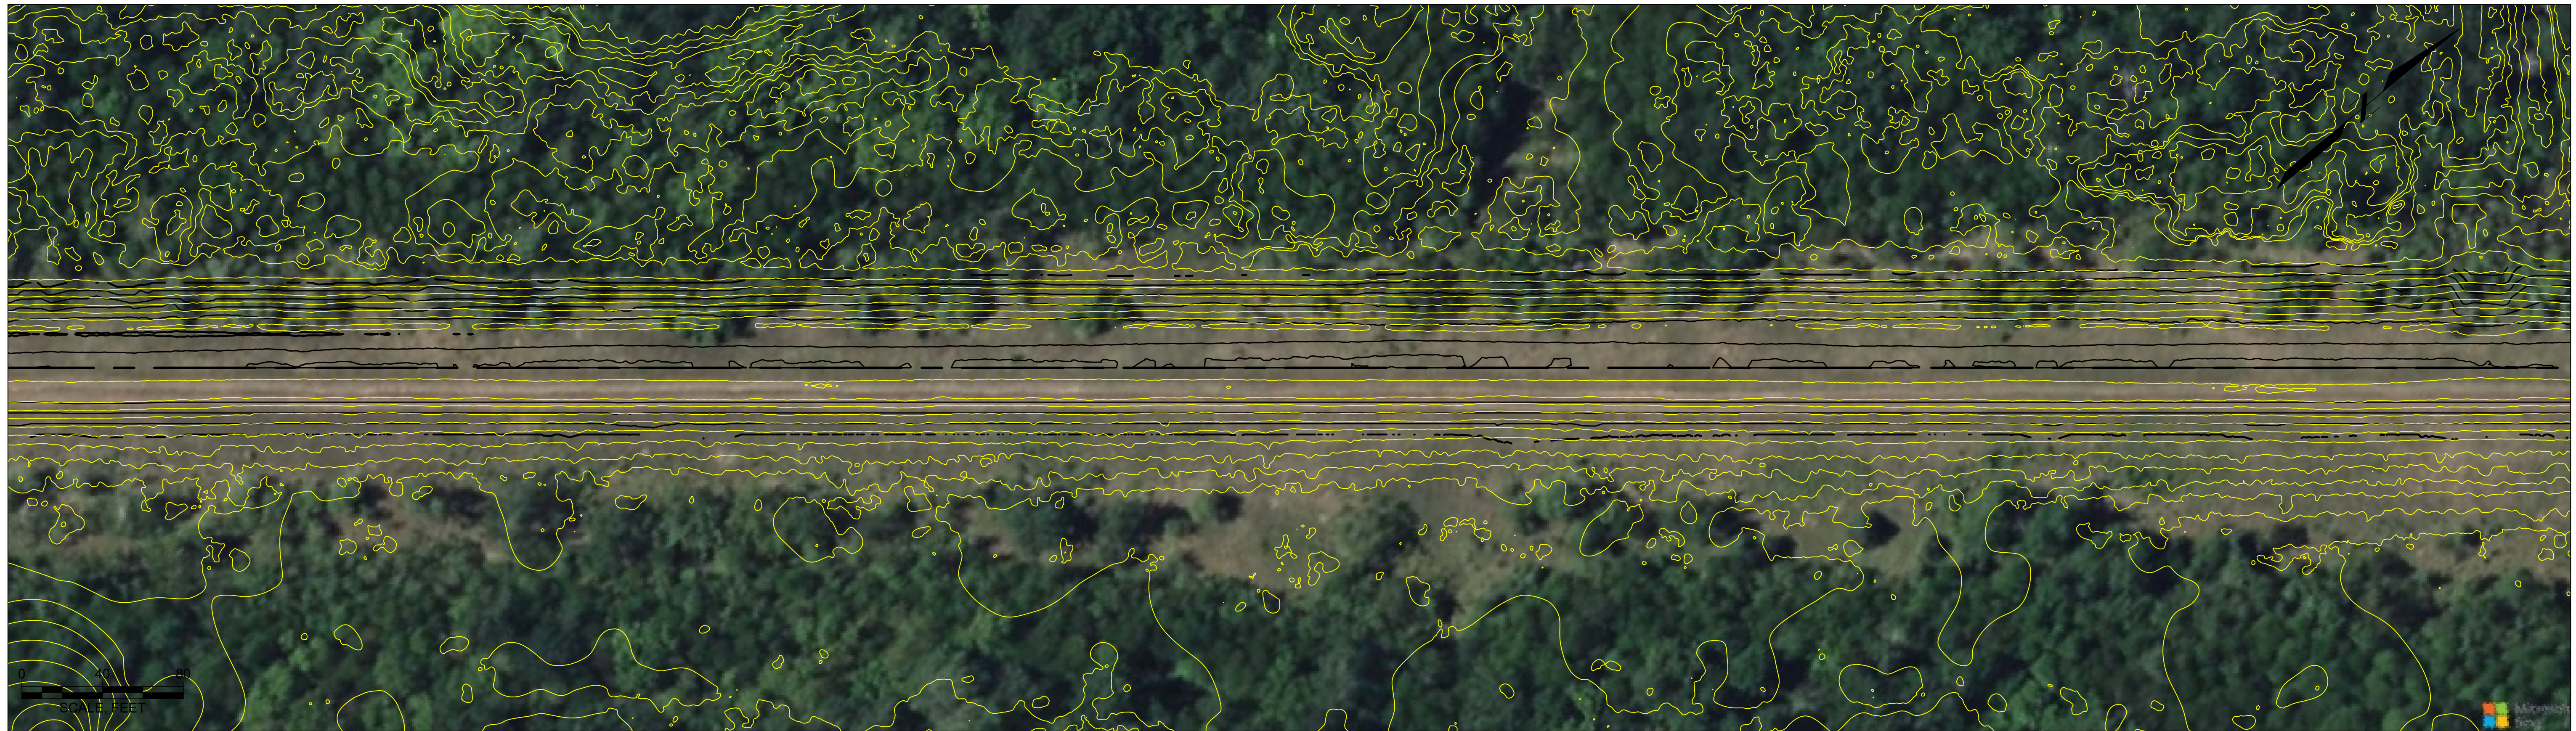

ELEVATIONS ARE REFERENCED TO NORTH AMERICAN VERTICAL DATUM 1988

AERIAL IMAGE FROM PRIOR TO CONSTRUCTION AND IS NOT REPRESENTATIVE OF FINAL PROFILES OR CONDITIONS

Attention: If this scale bar does not measure 1" then drawing is not original scale.	<i>Designed:</i> BJJ
	<i>Drawn:</i> BJJ
	<i>Checked:</i> JPB
	<i>Approved:</i> JPB
	<i>P.E. No.:</i> 40594
<i>GEI Project:</i> 2300038	


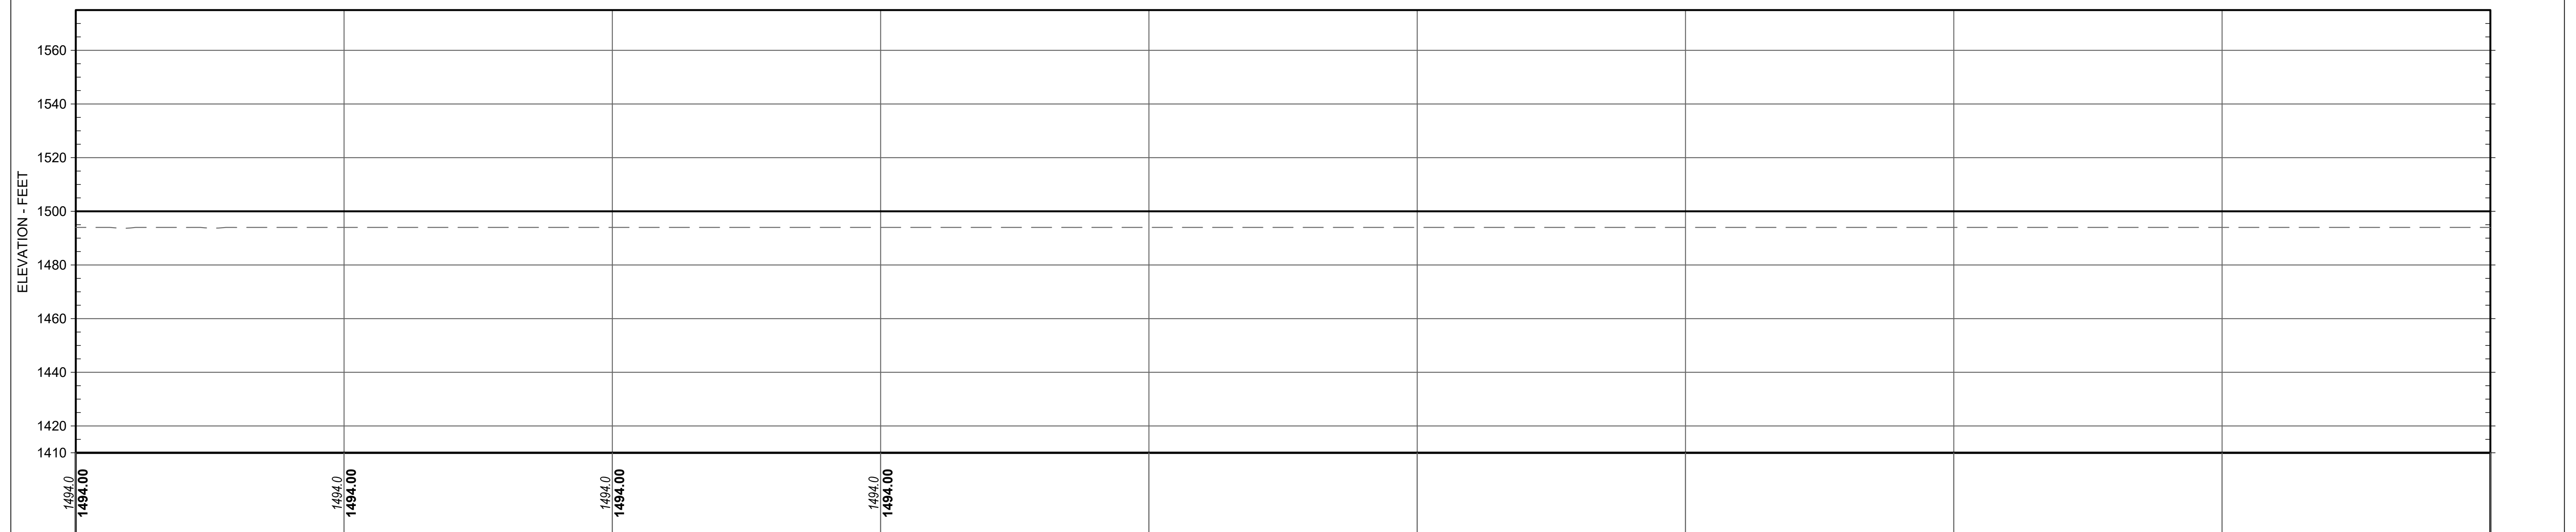
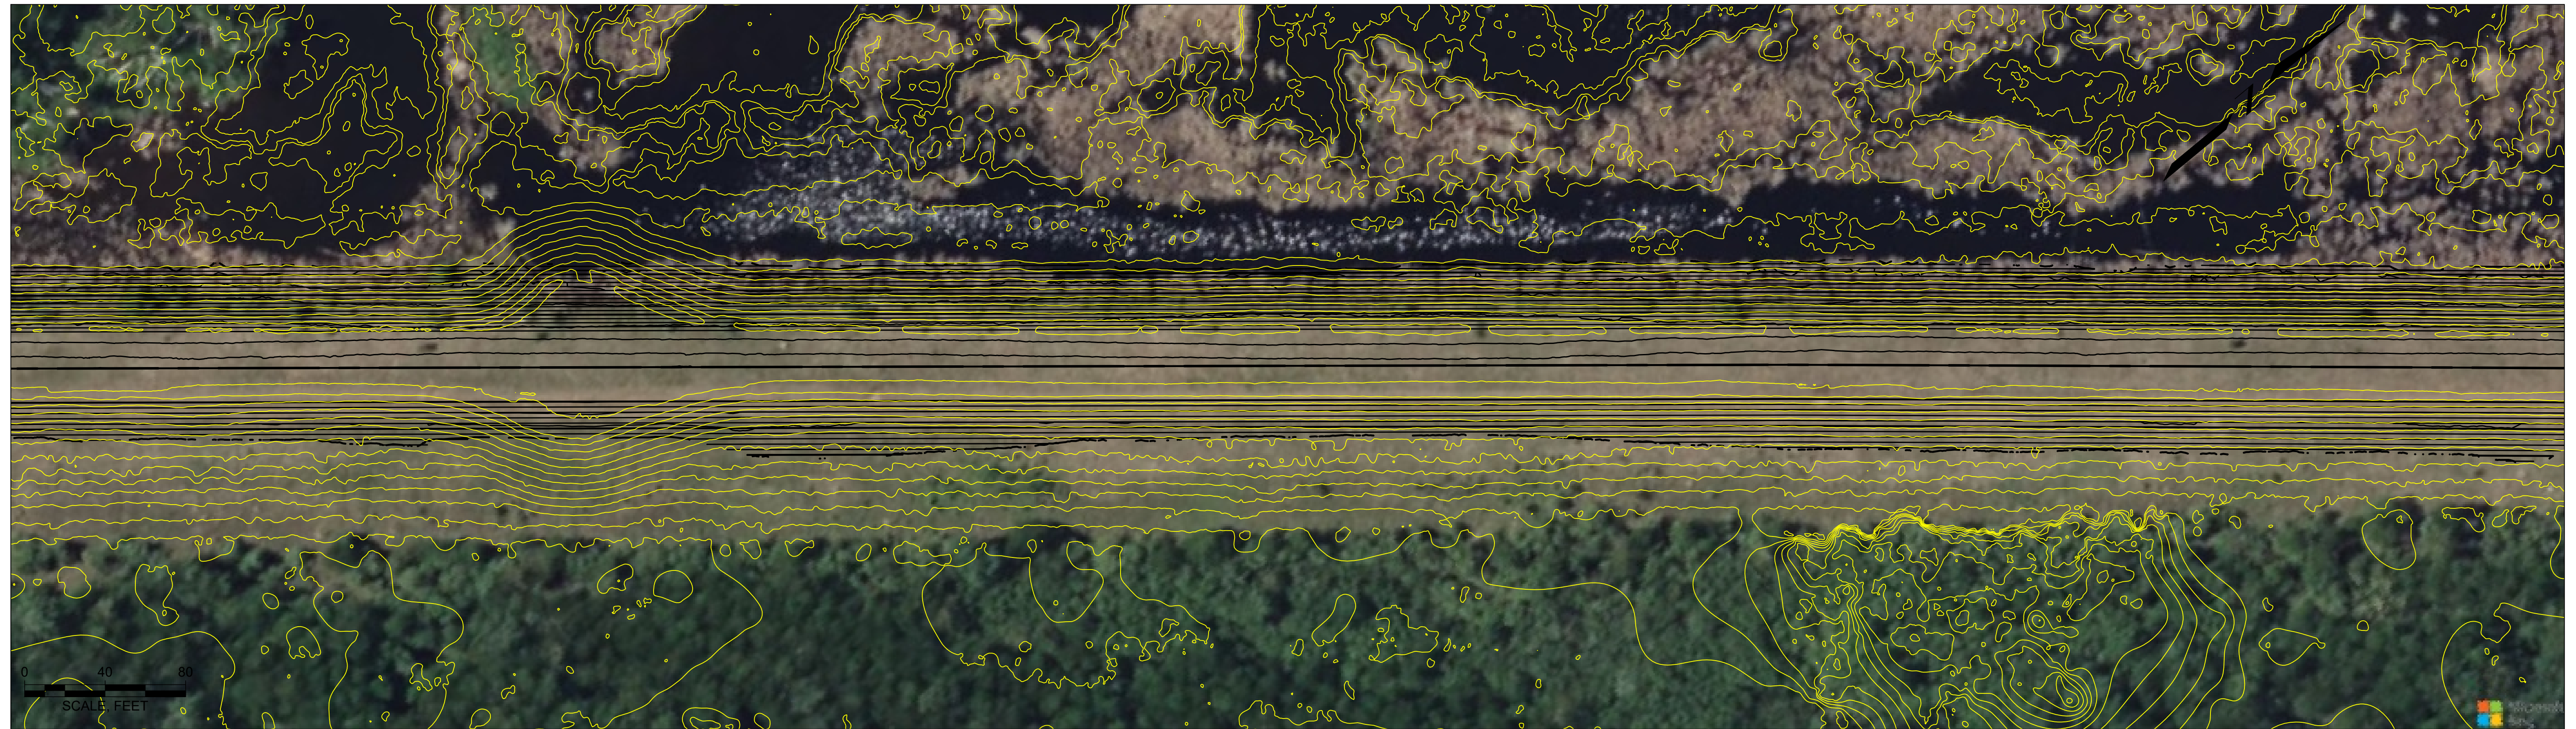


HORIZONTAL SCALE, FEET
 0 30 60
 VERTICAL SCALE, FEET
 NO VERTICAL EXAGGERATION

ELEVATIONS ARE REFERENCED TO NORTH AMERICAN VERTICAL DATUM 1988

 AERIAL IMAGE FROM PRIOR TO CONSTRUCTION AND IS NOT REPRESENTATIVE OF FINAL PROFILES OR CONDITIONS

Attention:  If this scale bar does not measure 1" then drawing is not original scale.	Designed: BJJ		<table border="1"> <tr><td></td><td></td></tr> <tr><td></td><td></td></tr> <tr><td></td><td></td></tr> <tr><td></td><td></td></tr> <tr><td></td><td></td></tr> </table>										
Drawn: BJJ													
Checked: JPB													
Approved: JPB													
P.E. No: 40594													
GEI Project 2300038													

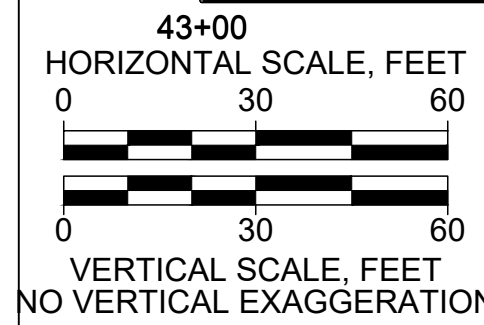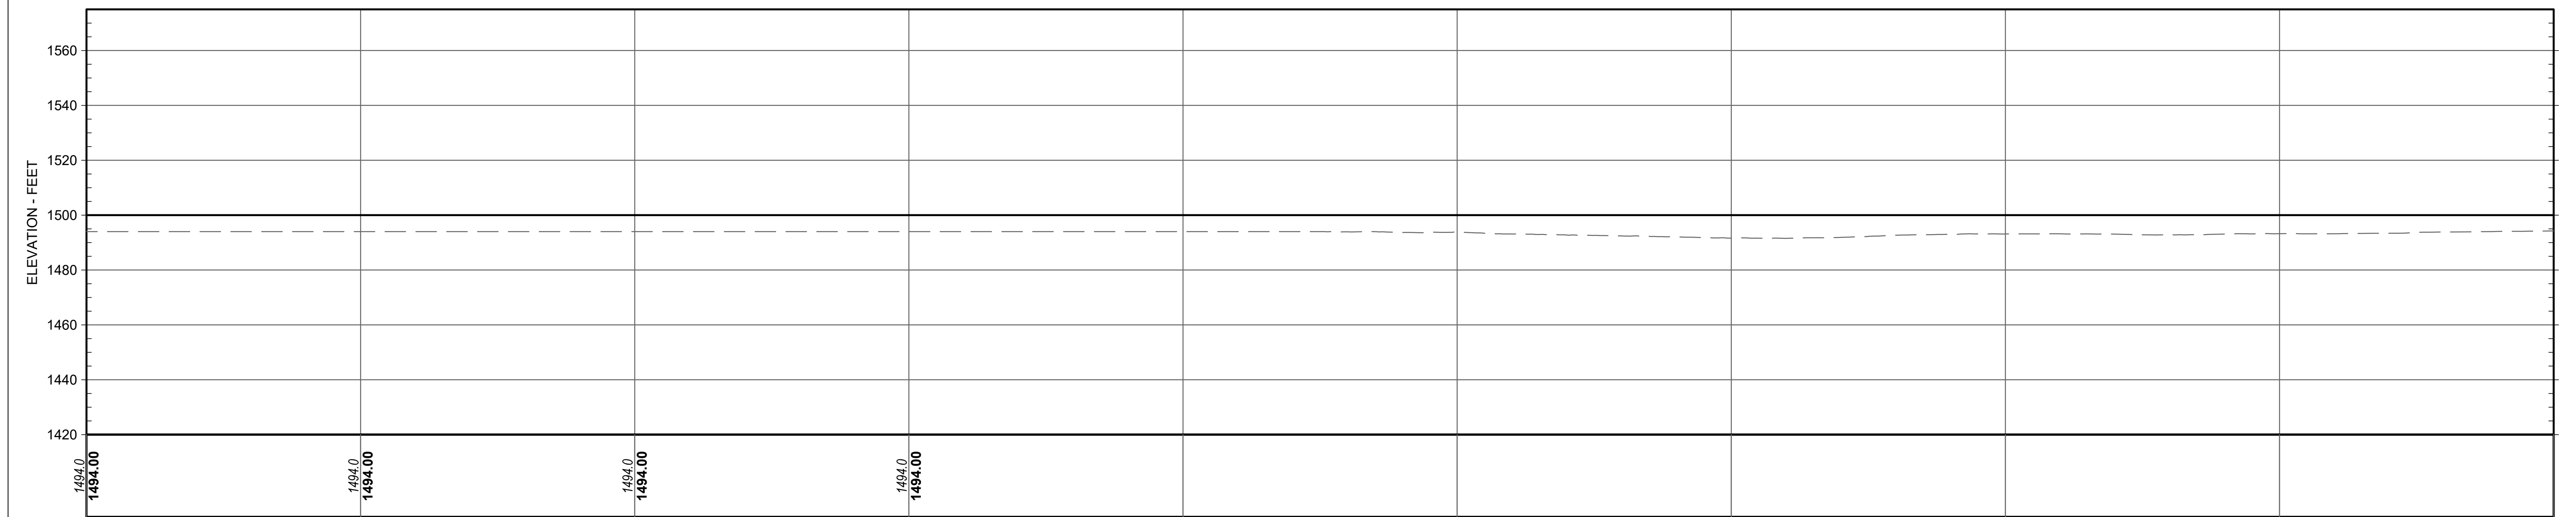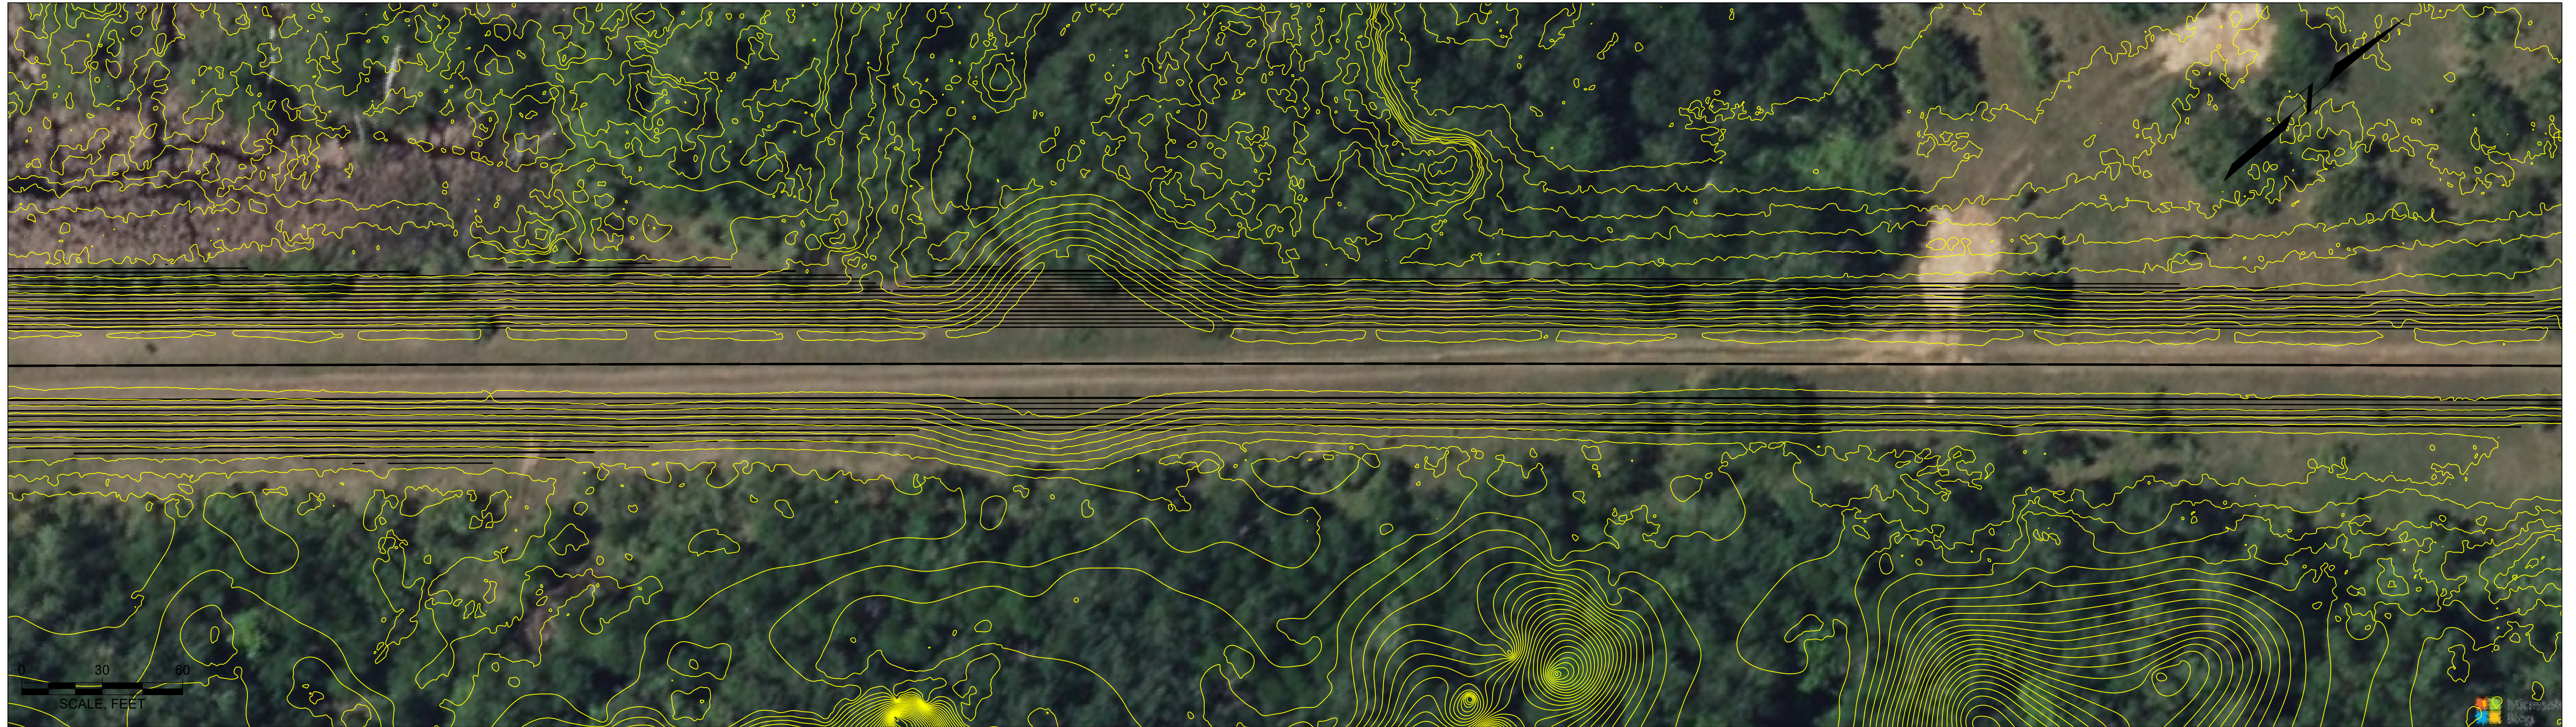

ELEVATIONS ARE REFERENCED TO NORTH AMERICAN VERTICAL DATUM 1988

AERIAL IMAGE FROM PRIOR TO CONSTRUCTION AND IS NOT REPRESENTATIVE OF FINAL PROFILES OR CONDITIONS



Attention:

0 1"

If this scale bar does not measure 1" then drawing is not original scale.

<i>Designed:</i>	BJF
<i>Drawn:</i>	BJF
<i>Checked:</i>	JPB
<i>Approved:</i>	JPB
<i>P.E. No.:</i>	40594
<i>GEI Project:</i>	2300038



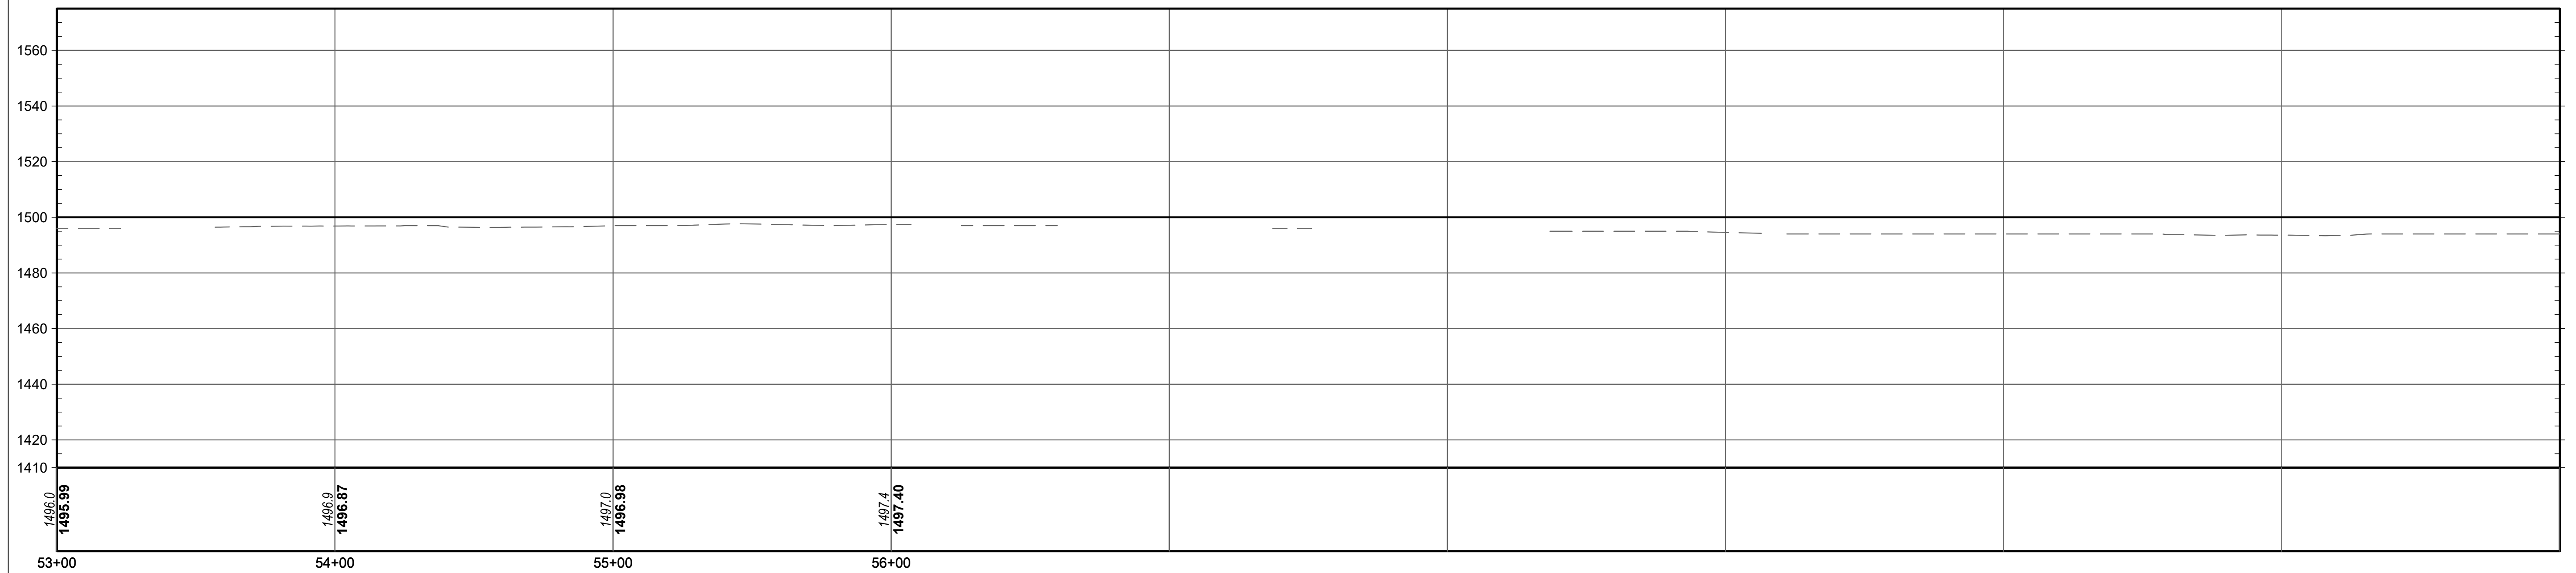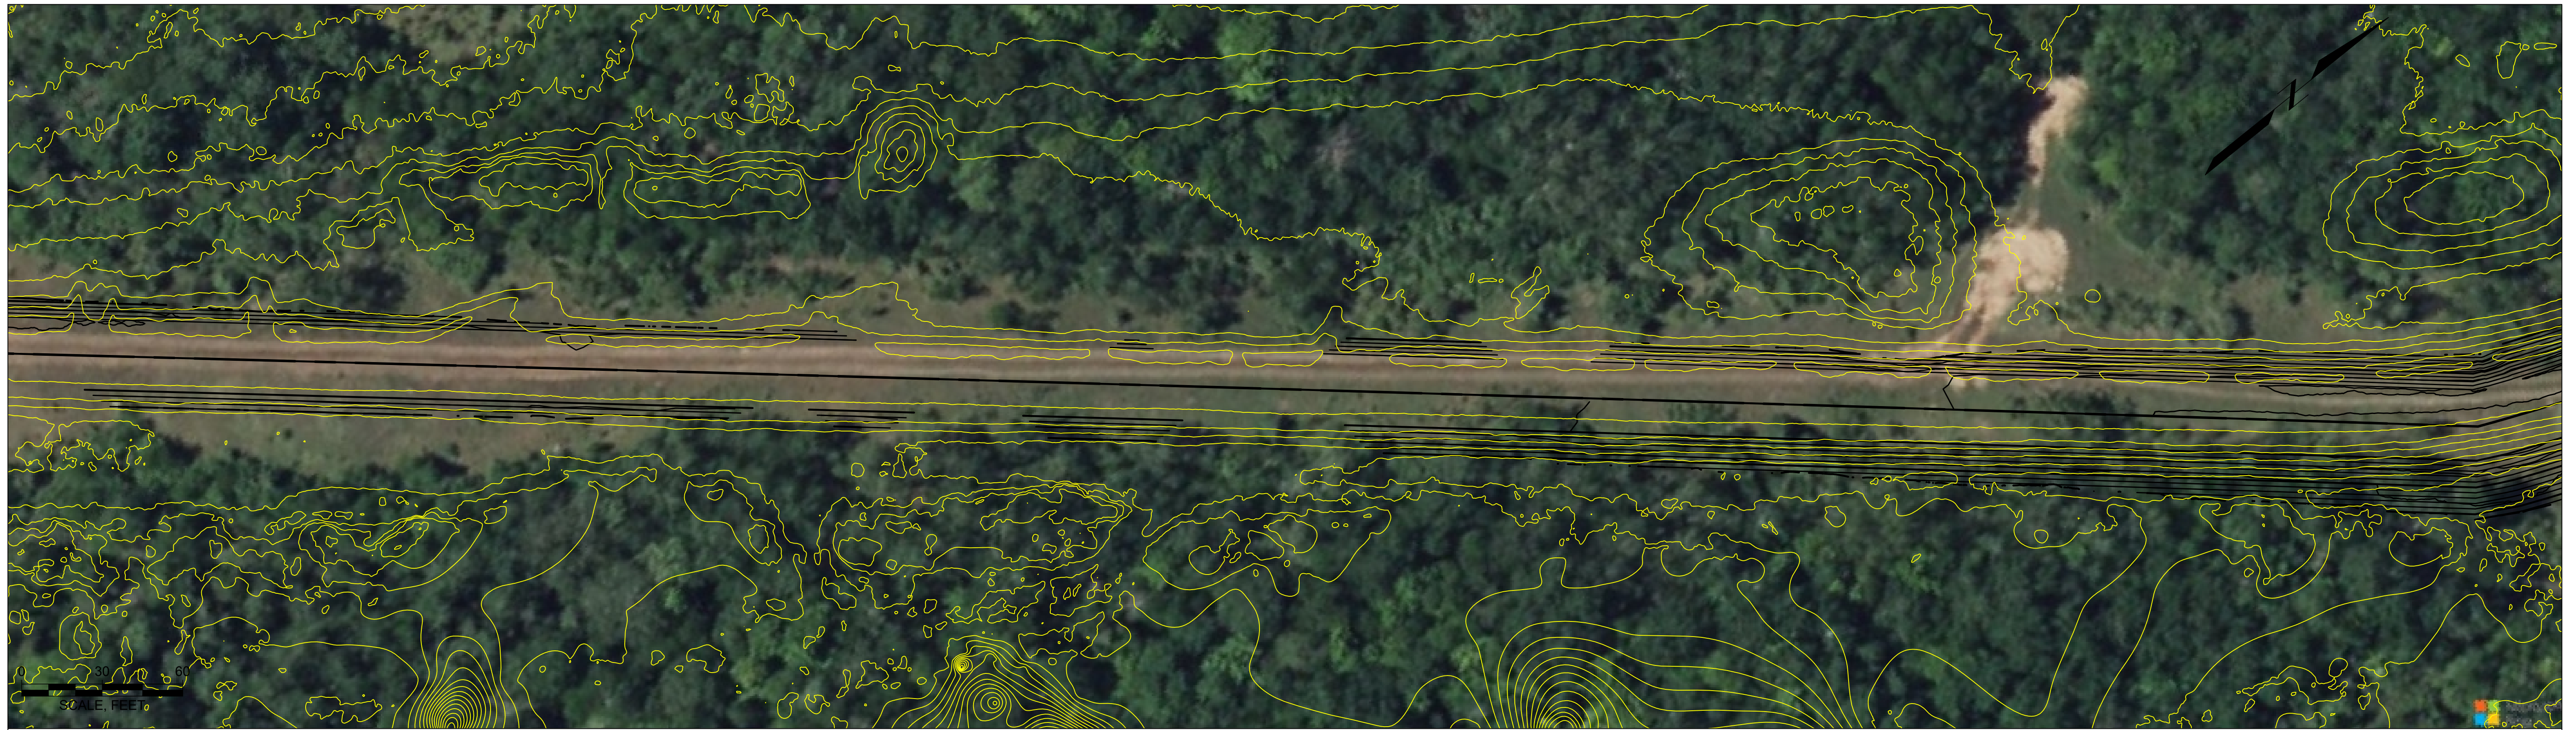

HORIZONTAL SCALE, FEET
0 30 60




VERTICAL SCALE, FEET
NO VERTICAL EXAGGERATION
0 30 60

ELEVATIONS ARE REFERENCED TO NORTH AMERICAN VERTICAL DATUM 1988

AERIAL IMAGE FROM PRIOR TO CONSTRUCTION AND IS NOT REPRESENTATIVE OF FINAL PROFILES OR CONDITIONS

Attention: 0 1" If this scale bar does not measure 1" then drawing is not original scale.	<i>Designed:</i> BJB
	<i>Drawn:</i> BJB
	<i>Checked:</i> JPB
	<i>Approved:</i> JPB
	<i>P.E. No.:</i> 40594



	<i>GEI Project:</i> 2300038

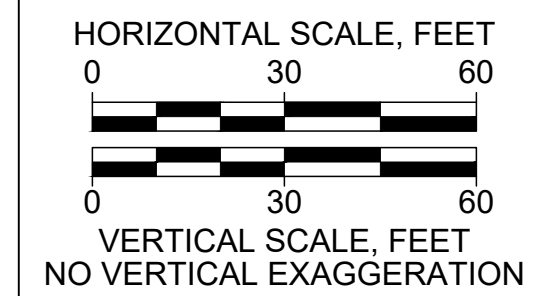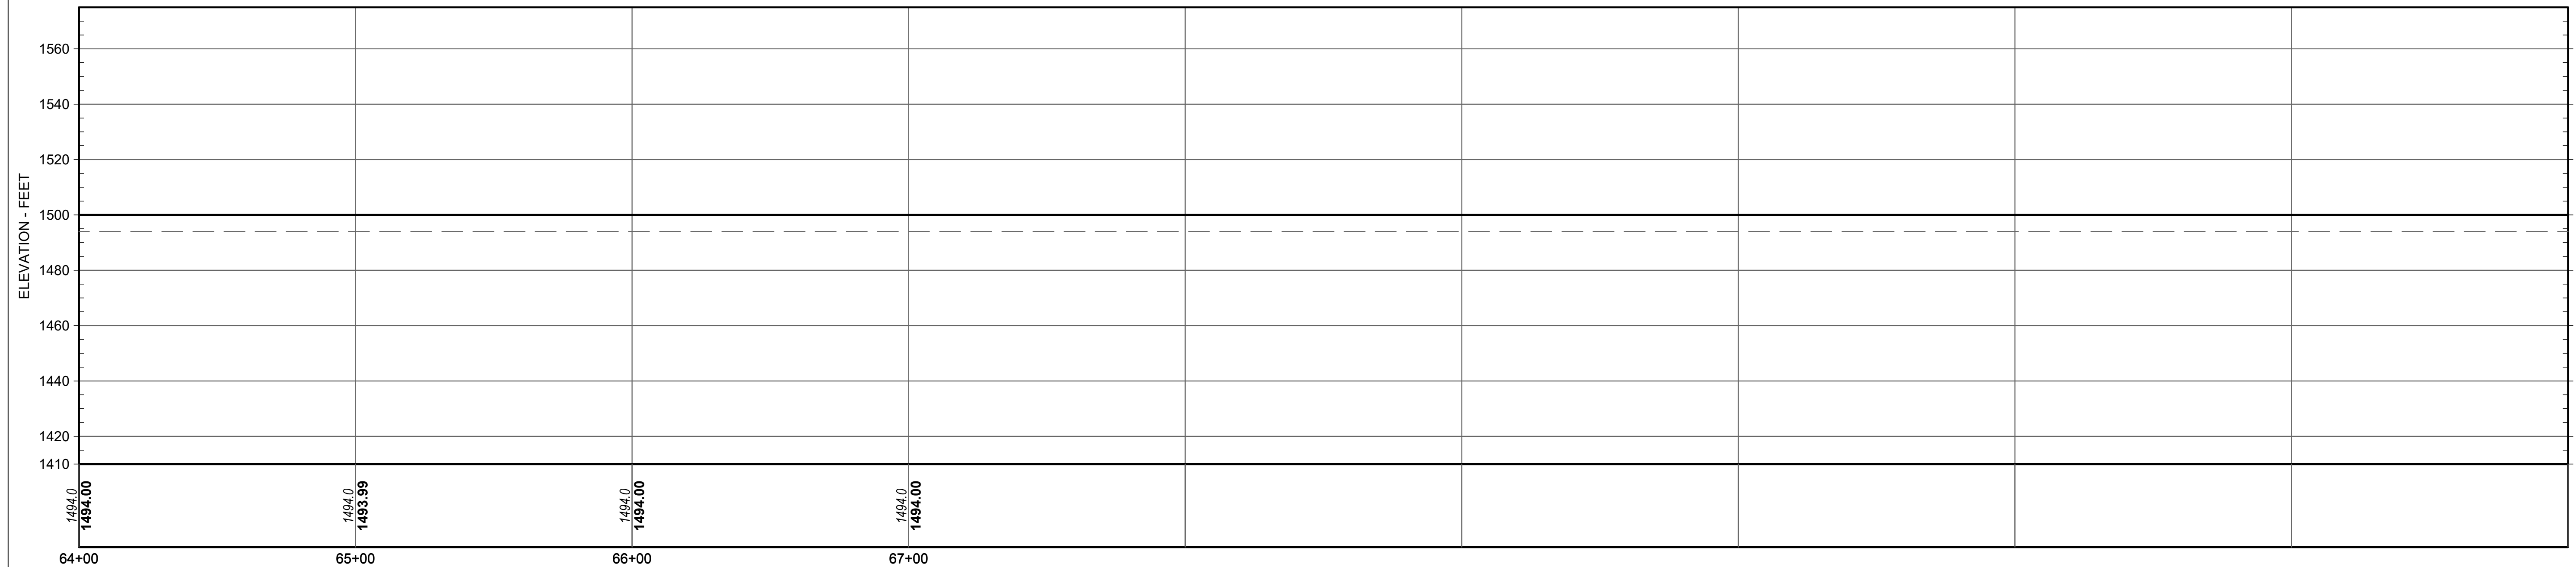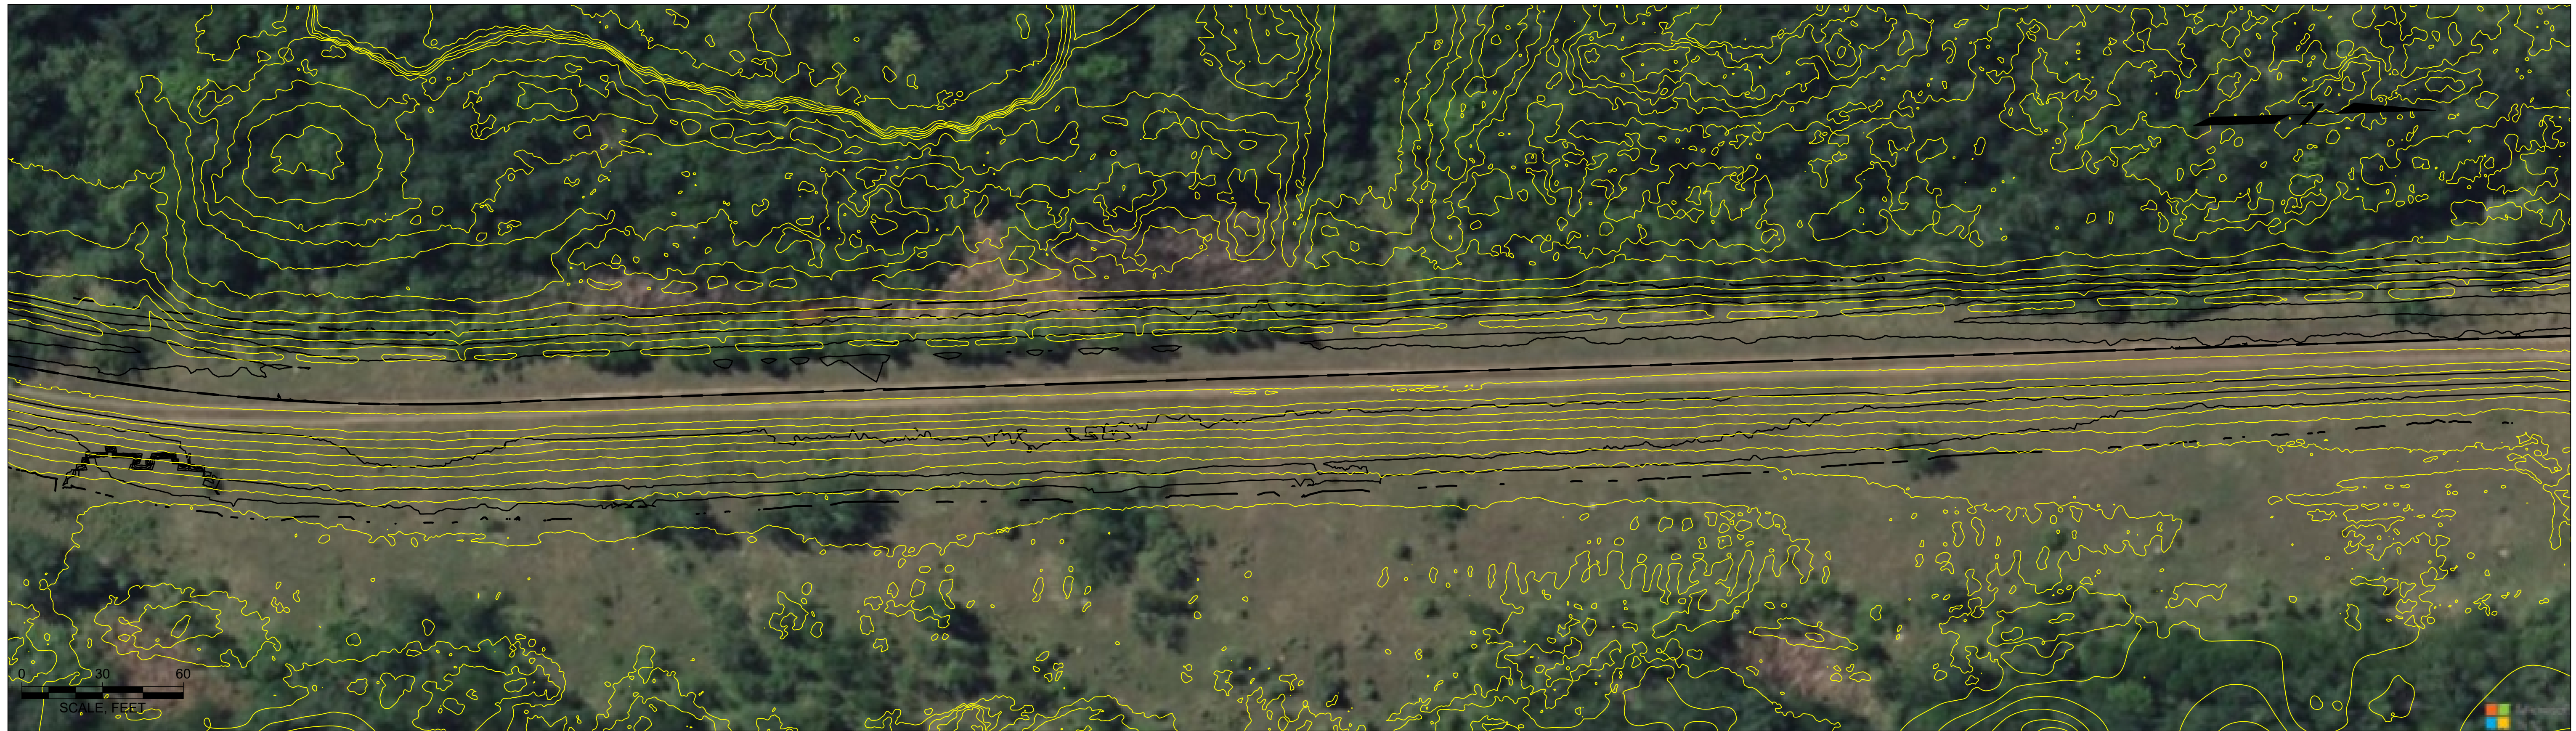

ELEVATIONS ARE REFERENCED TO NORTH AMERICAN VERTICAL DATUM 1988
 AERIAL IMAGE FROM PRIOR TO CONSTRUCTION AND IS NOT REPRESENTATIVE OF FINAL PROFILES OR CONDITIONS


Attention: If this scale bar does not measure 1" then drawing is not original scale.	Designed: BJJ
	Drawn: BJJ
	Checked: JPB
	Approved: JPB
	P.E. No: 40594
GEI Project 2300038	



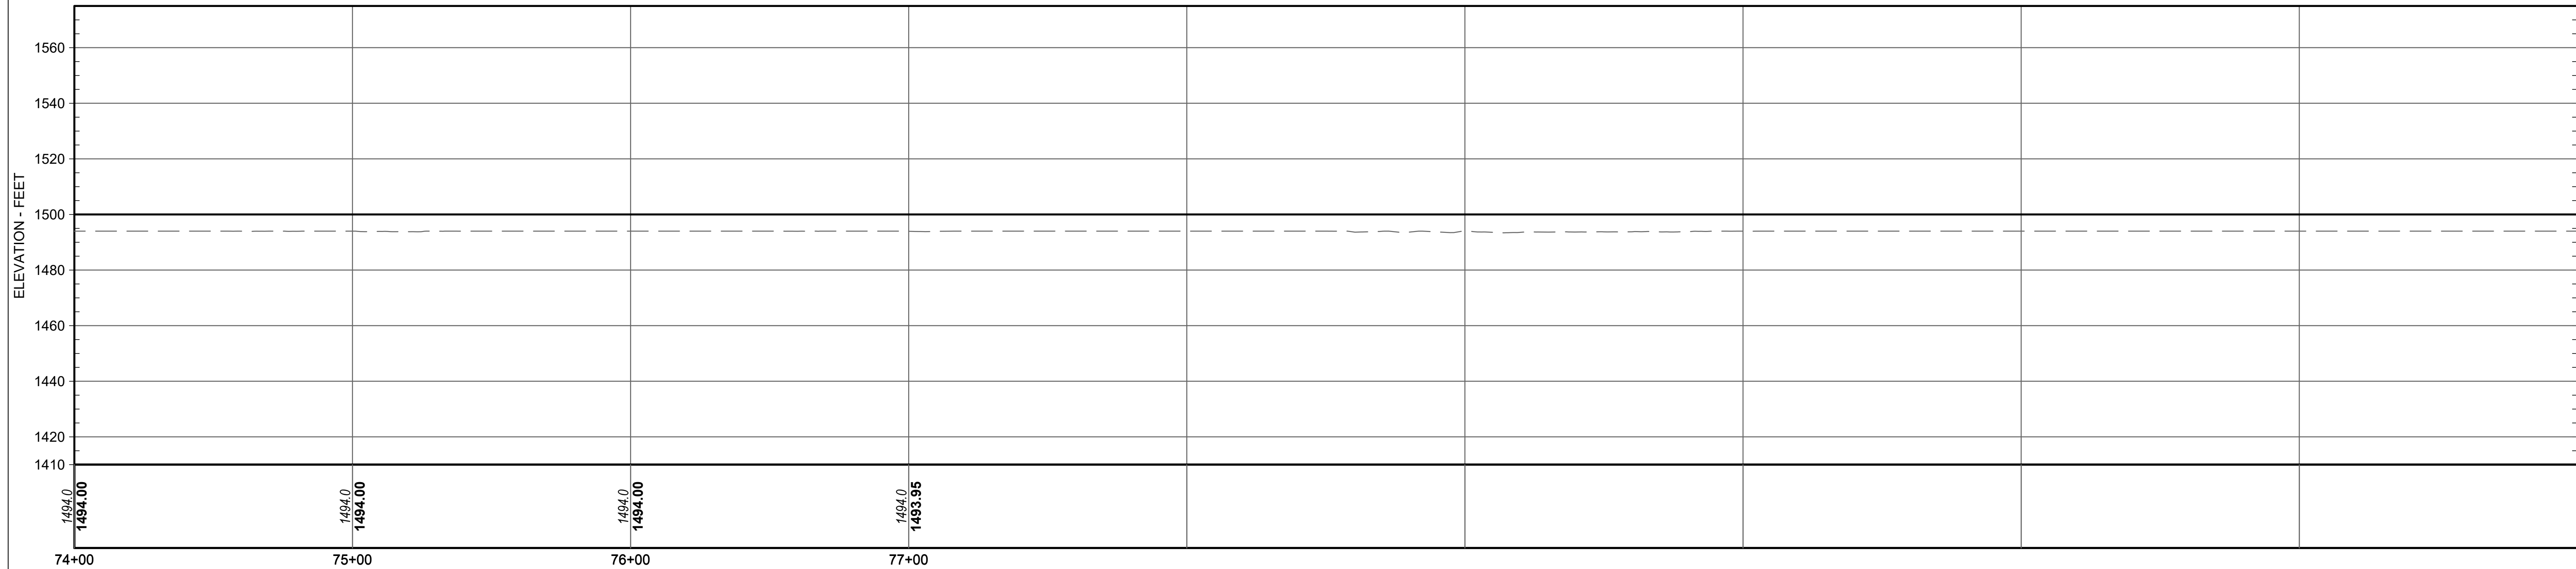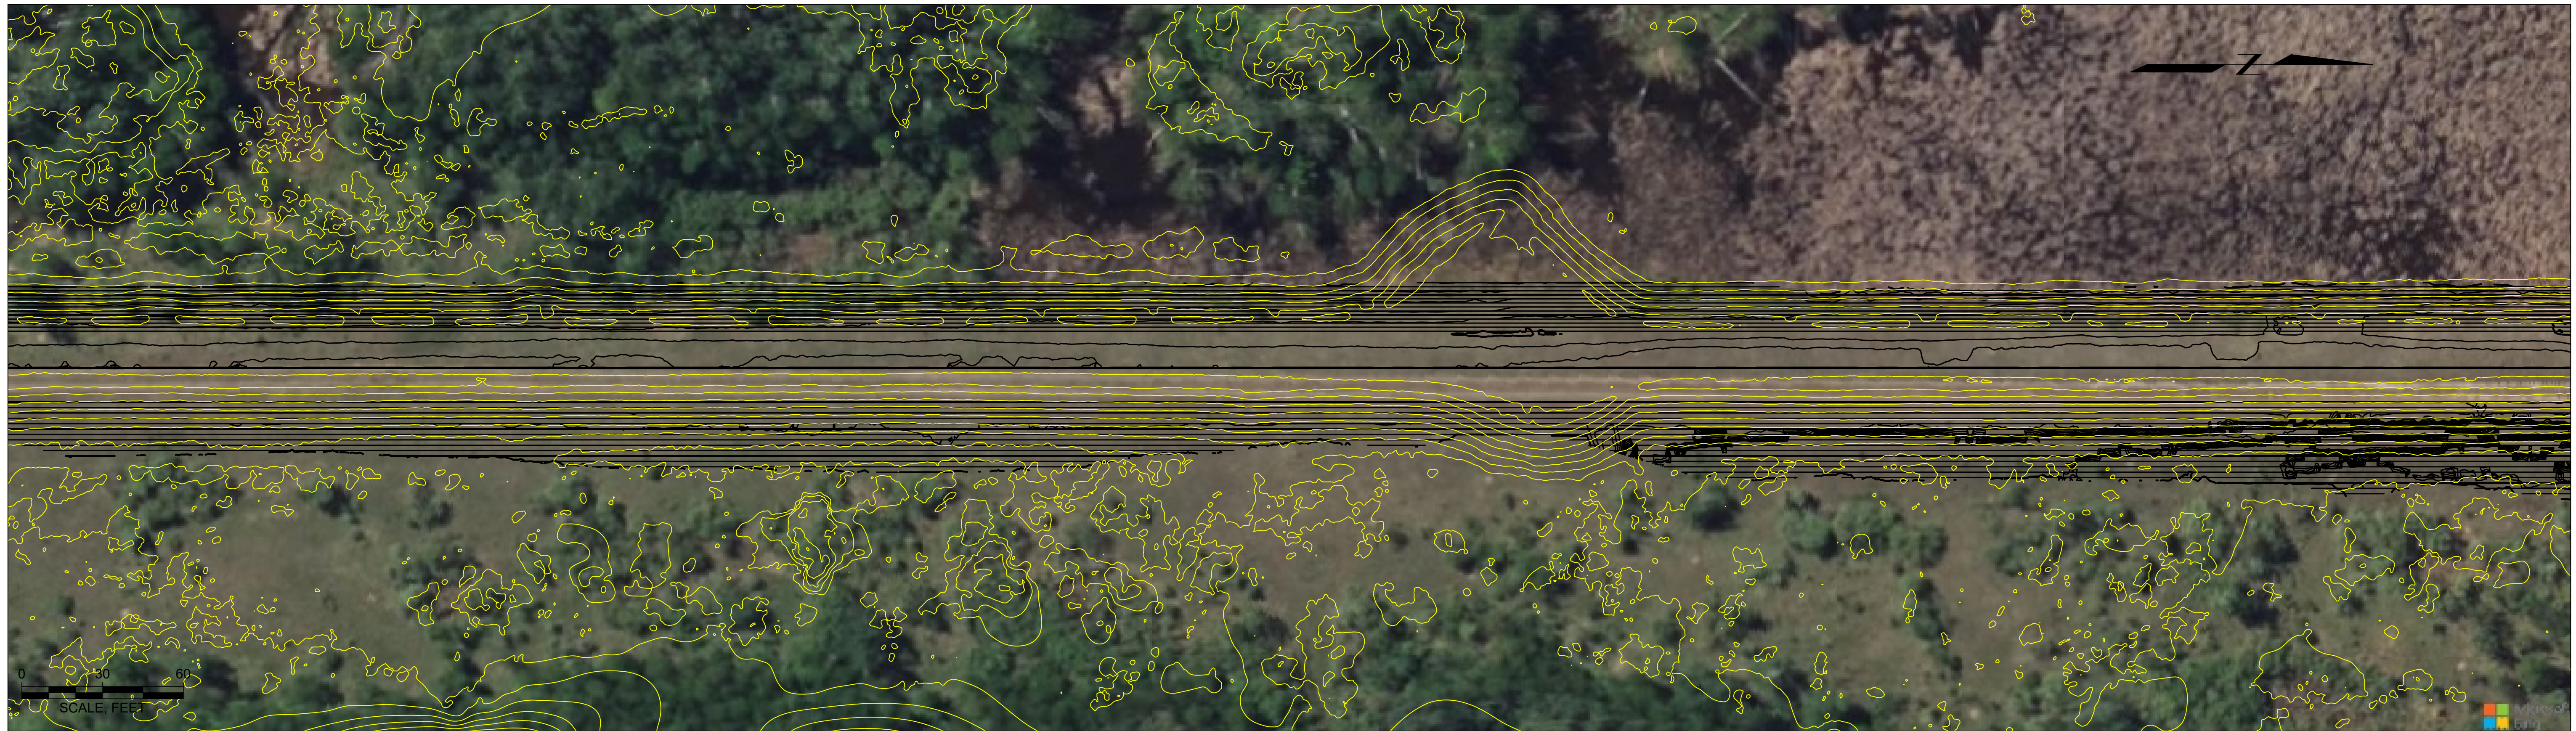




HORIZONTAL SCALE, FEET
 0 30 60
 VERTICAL SCALE, FEET
 NO VERTICAL EXAGGERATION

ELEVATIONS ARE REFERENCED TO NORTH AMERICAN VERTICAL DATUM 1988
 AERIAL IMAGE FROM PRIOR TO CONSTRUCTION AND IS NOT REPRESENTATIVE OF FINAL PROFILES OR CONDITIONS

Attention:  If this scale bar does not measure 1" then drawing is not original scale.	Designed: BJJ
	Drawn: BJJ
	Checked: JPB
	Approved: JPB
	P.E. No: 40594
GEI Project 2300038	



8/8/2024 1:35:00 PM C:\Users\hufes3295\OneDrive - GEI Consultants, Inc\Desktop\Kendalr_2024\2024 External East\2024 External East (8).dwg

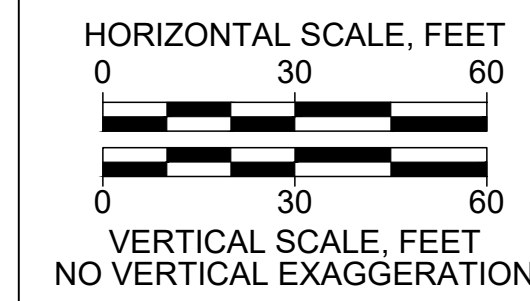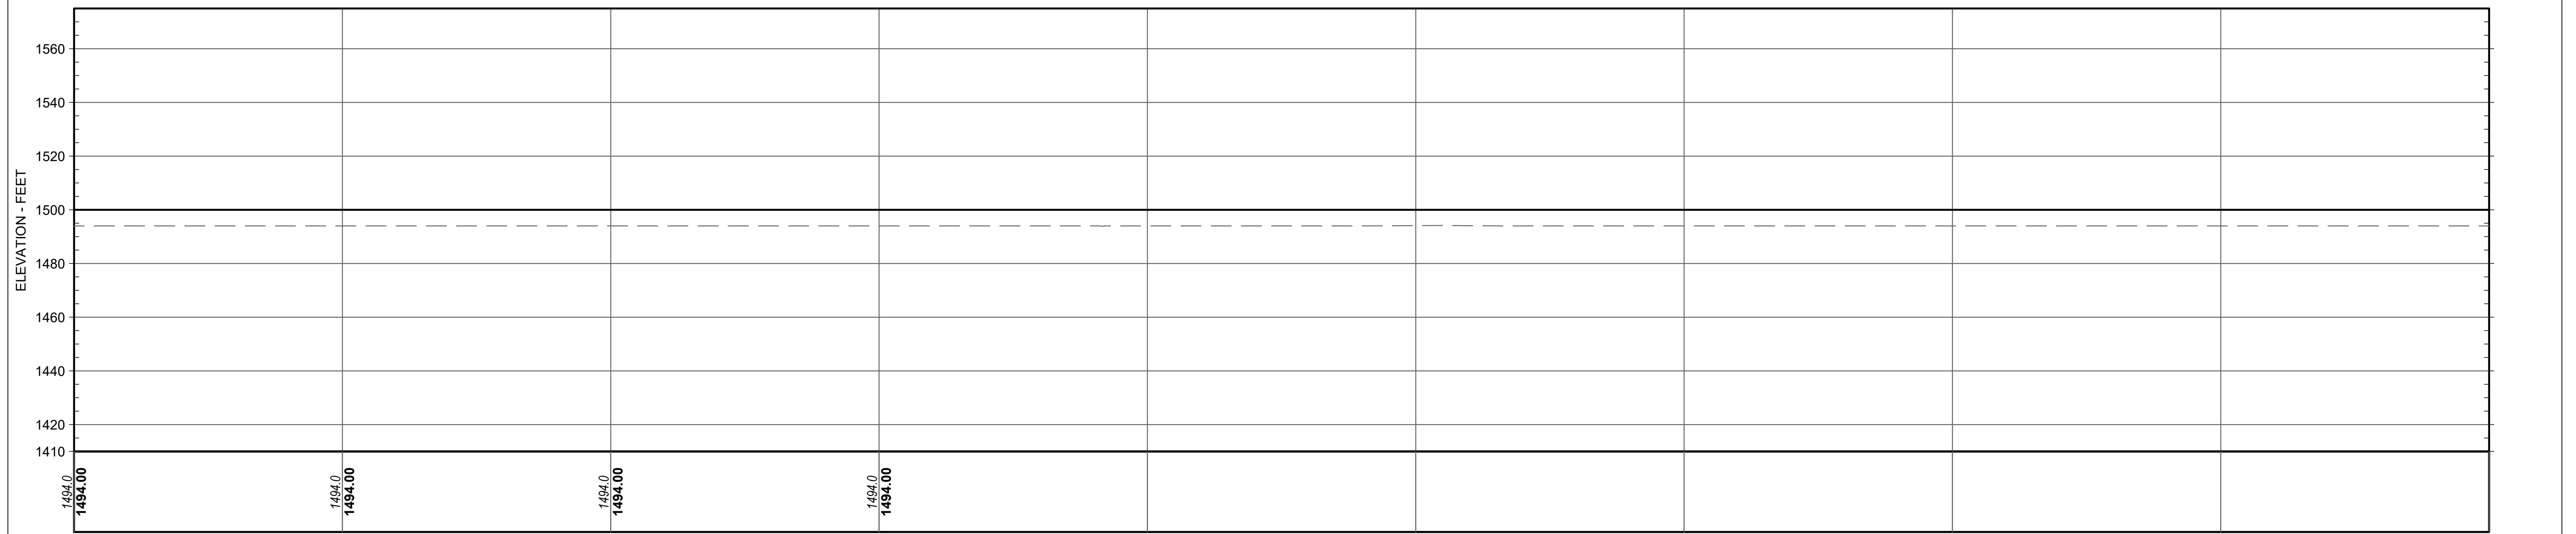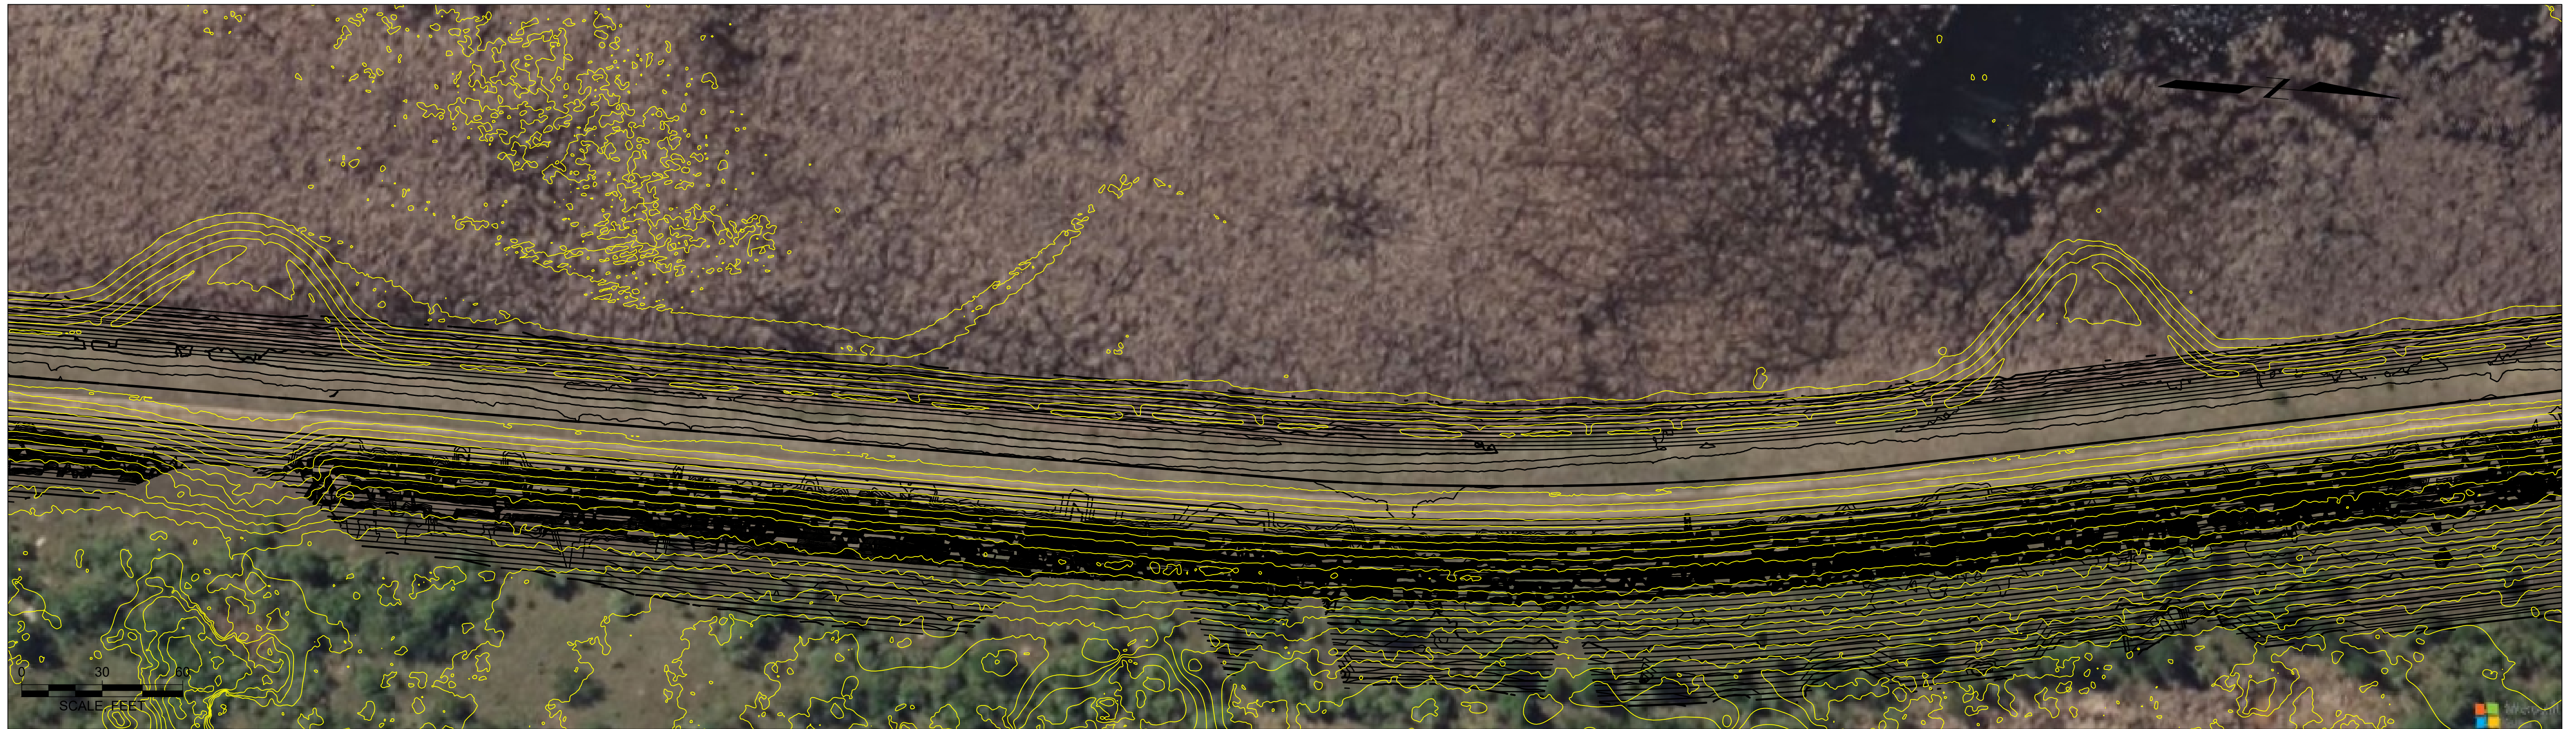

ELEVATIONS ARE REFERENCED TO NORTH AMERICAN VERTICAL DATUM 1988

AERIAL IMAGE FROM PRIOR TO CONSTRUCTION AND IS NOT REPRESENTATIVE OF FINAL PROFILES OR CONDITIONS



Attention:

If this scale bar does not measure 1" then drawing is not original scale.

<i>Designed:</i>	BJF
<i>Drawn:</i>	BJF
<i>Checked:</i>	JPB
<i>Approved:</i>	JPB
<i>P.E. No.:</i>	40594
<i>GEI Project:</i>	2300038






8/8/2024 1:35:00 PM C:\Users\burke\389\OneDrive - GEI Consultants, Inc\Desktop\Kerlar_2024\2024 External East\2024 External East (9).dwg

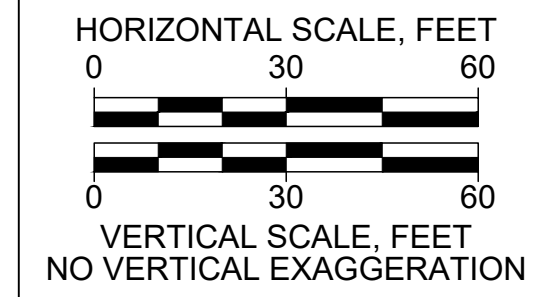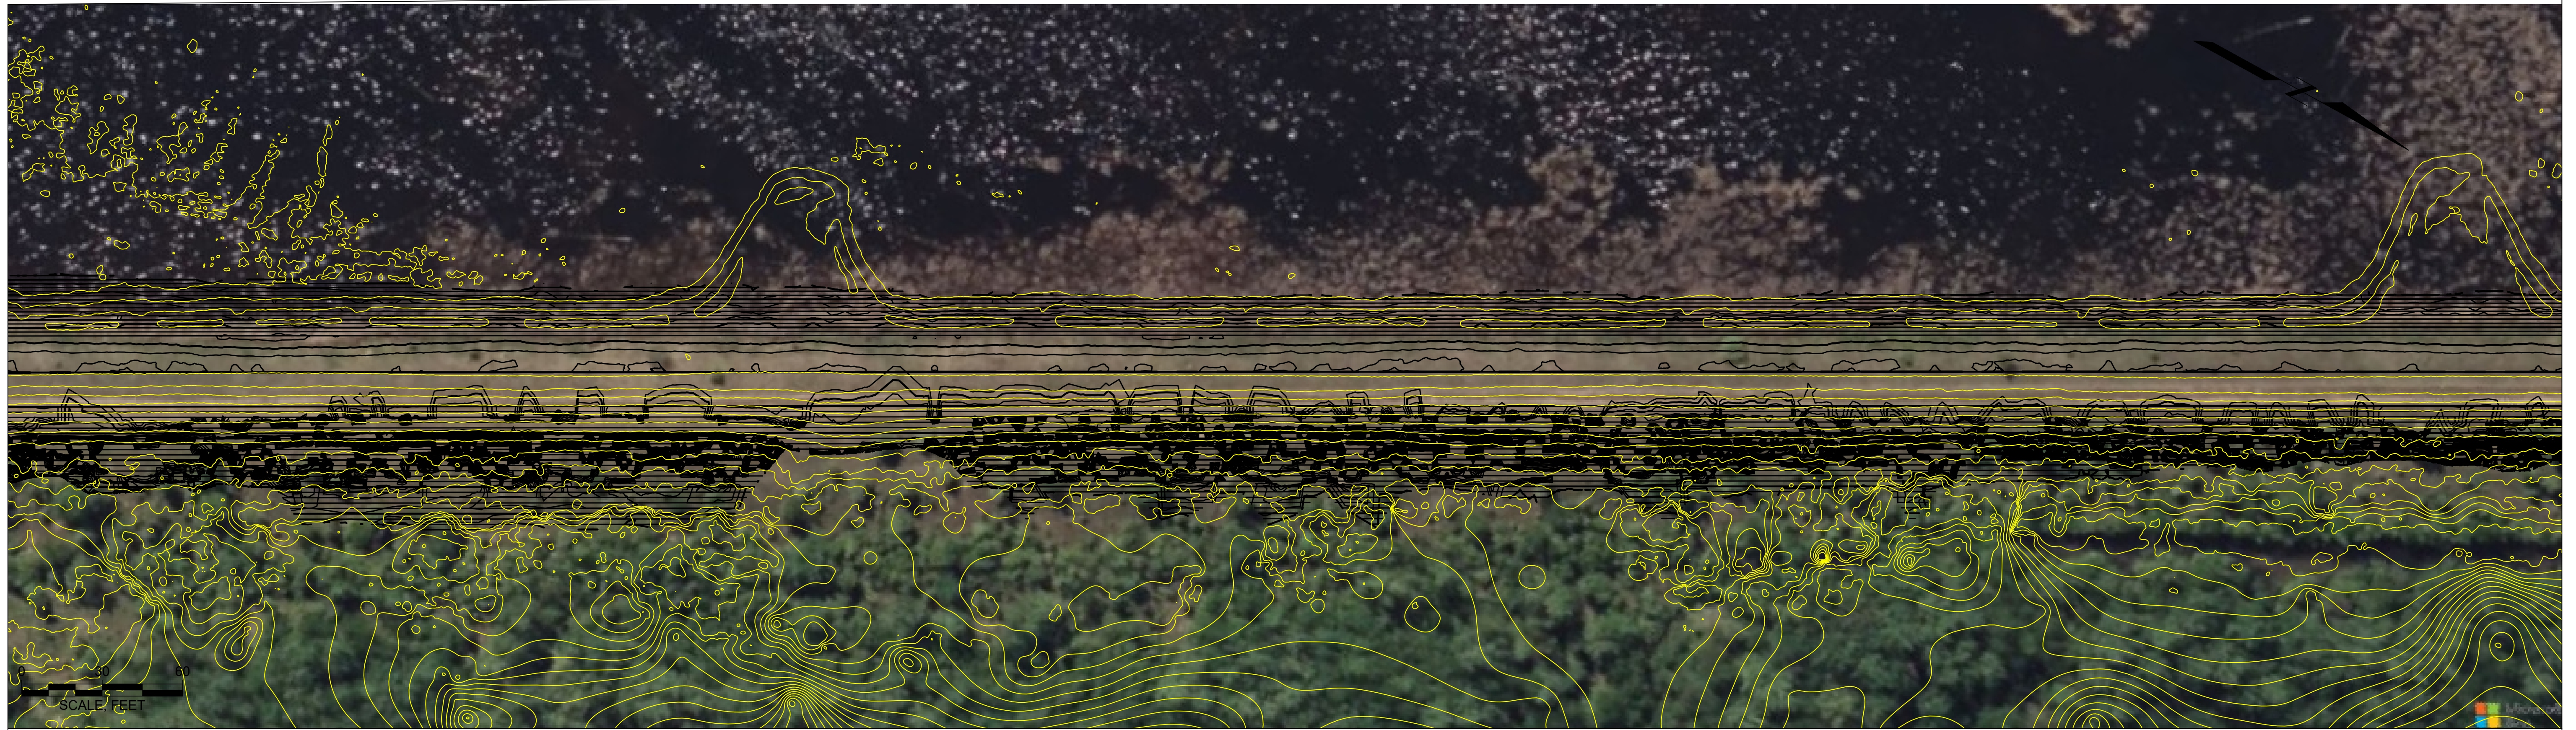

ELEVATIONS ARE REFERENCED TO NORTH AMERICAN VERTICAL DATUM 1988

AERIAL IMAGE FROM PRIOR TO CONSTRUCTION AND IS NOT REPRESENTATIVE OF FINAL PROFILES OR CONDITIONS




Attention: If this scale bar does not measure 1" then drawing is not original scale.	<i>Designed:</i> BJB
	<i>Drawn:</i> BJB
	<i>Checked:</i> JPB
	<i>Approved:</i> JPB
	<i>P.E. No:</i> 40594
<i>GEI Project</i> 2300038	

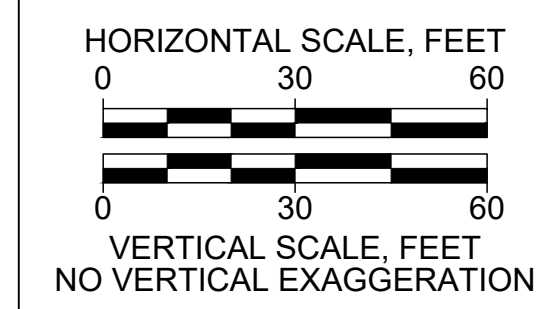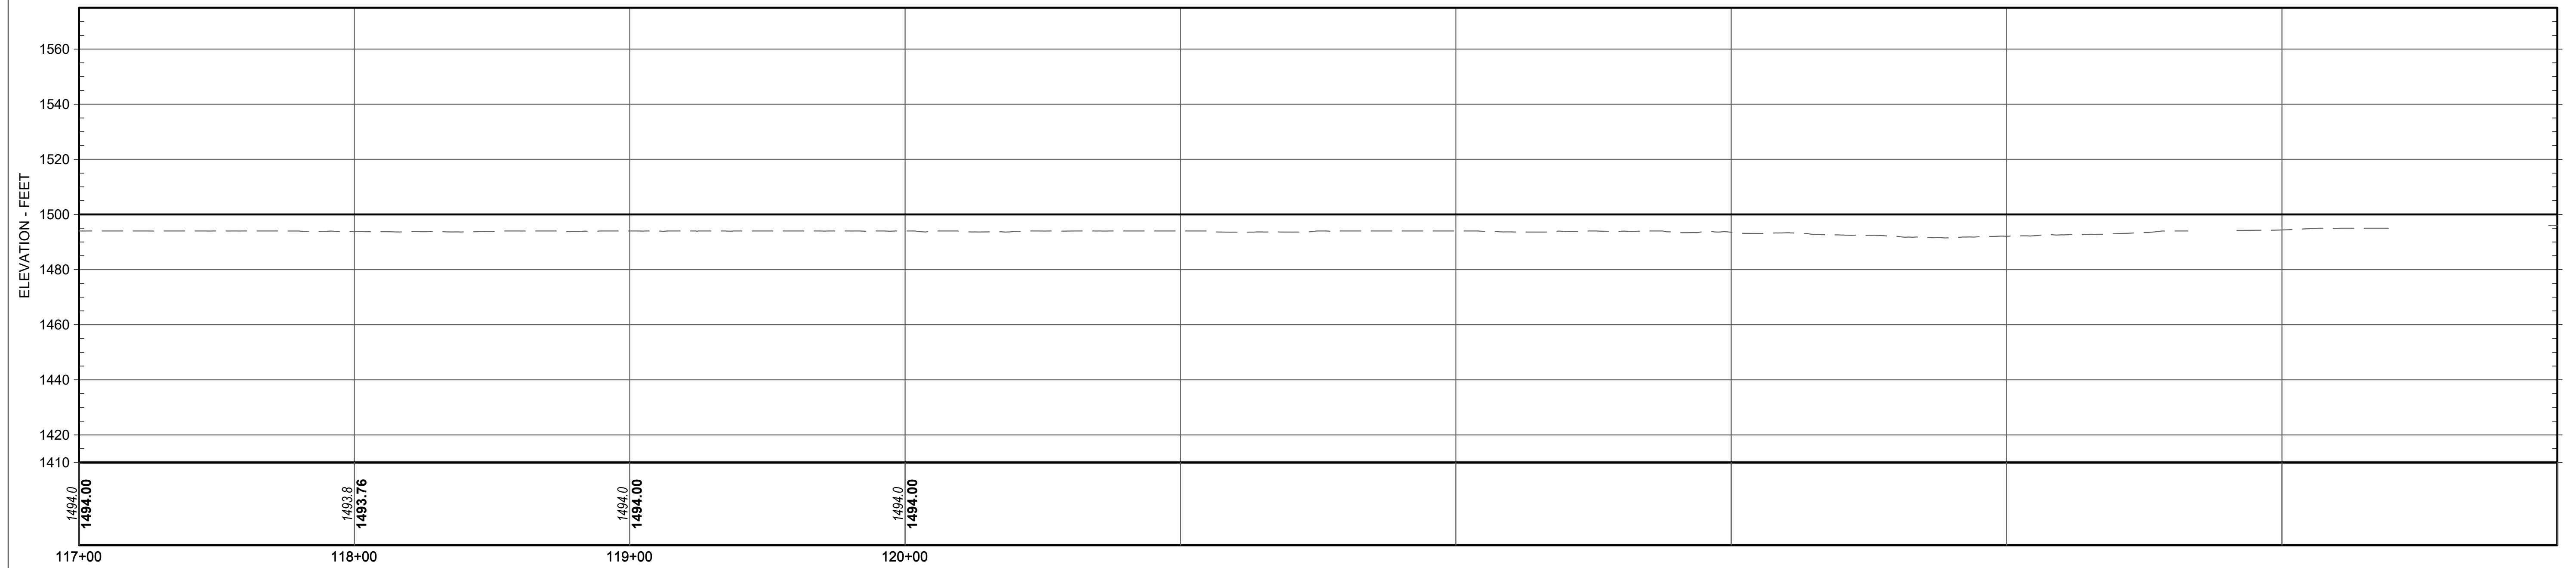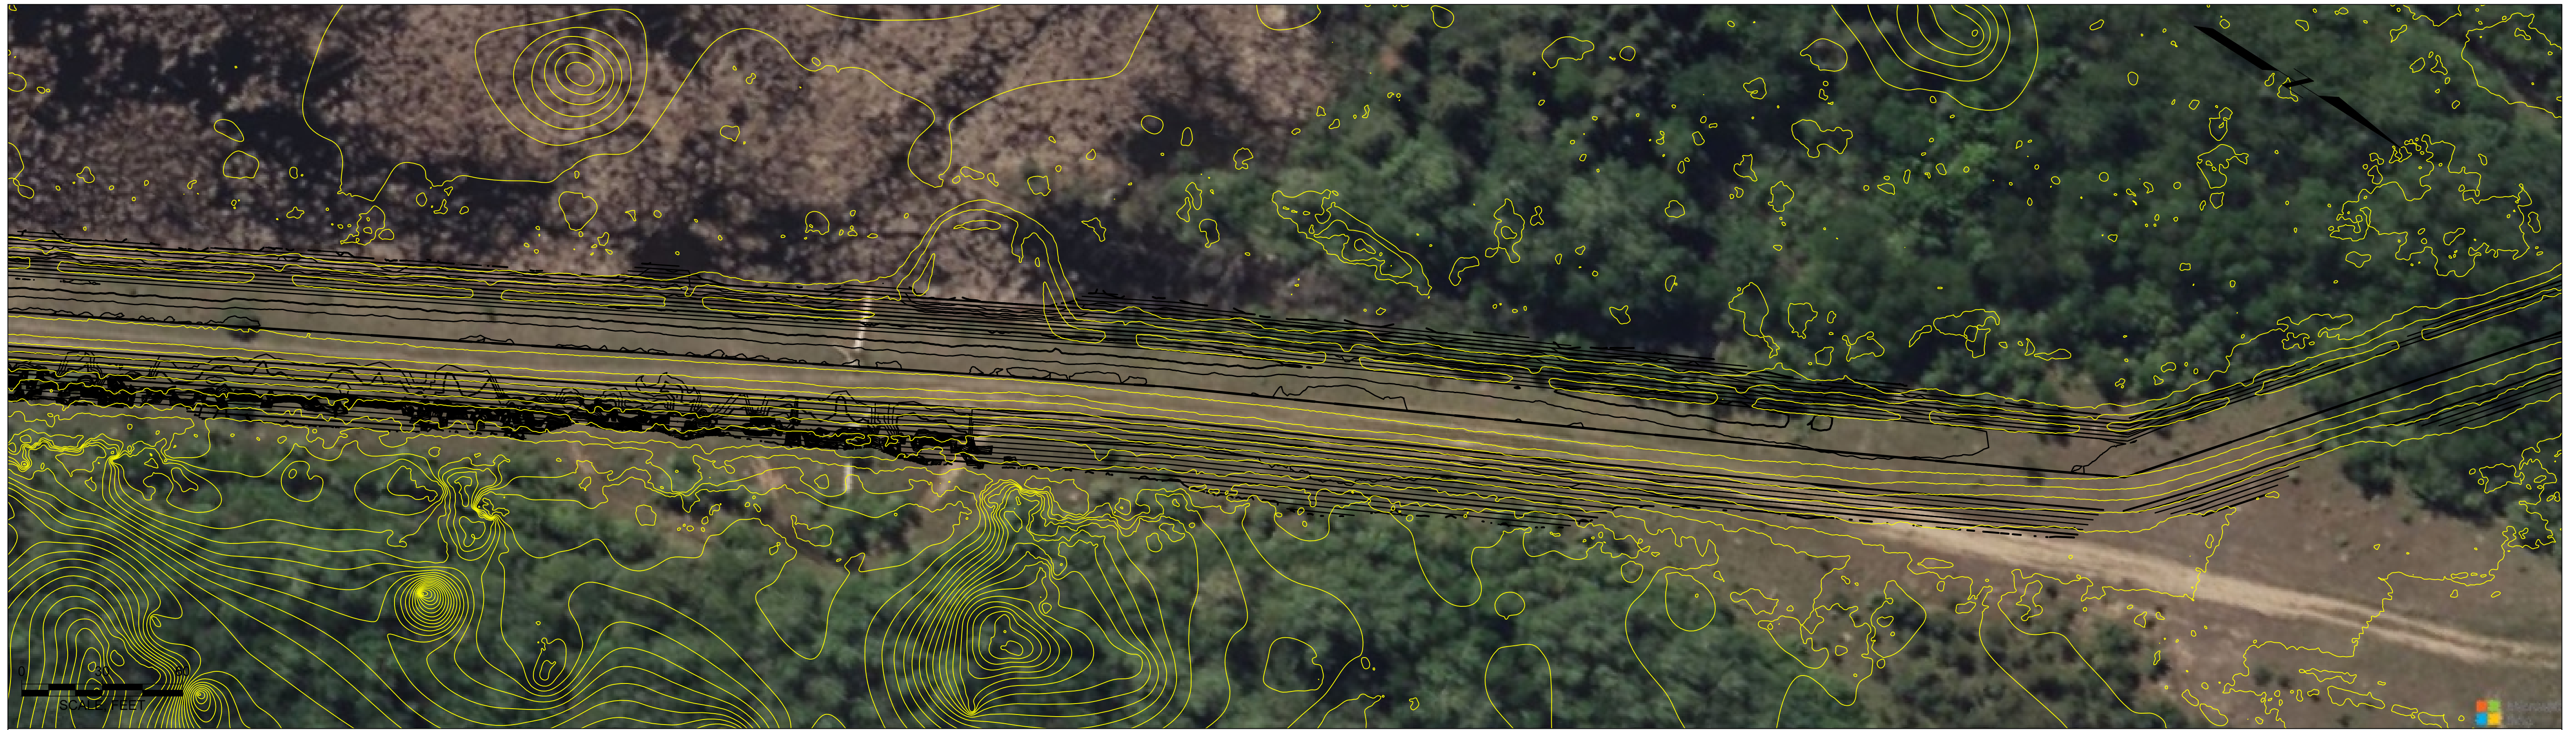

ELEVATIONS ARE REFERENCED TO NORTH AMERICAN VERTICAL DATUM 1988

AERIAL IMAGE FROM PRIOR TO CONSTRUCTION AND IS NOT REPRESENTATIVE OF FINAL PROFILES OR CONDITIONS

Attention: If this scale bar does not measure 1" then drawing is not original scale.	Designed: BJJ
	Drawn: BJJ
	Checked: JPB
	Approved: JPB
	P.E. No: 40594
GEI Project 2300038	

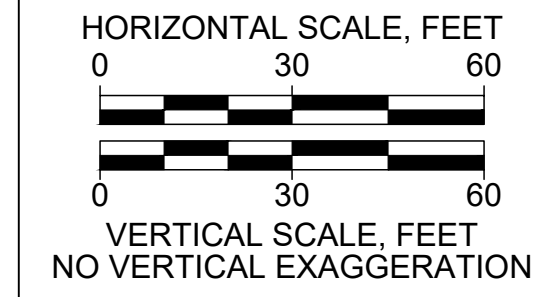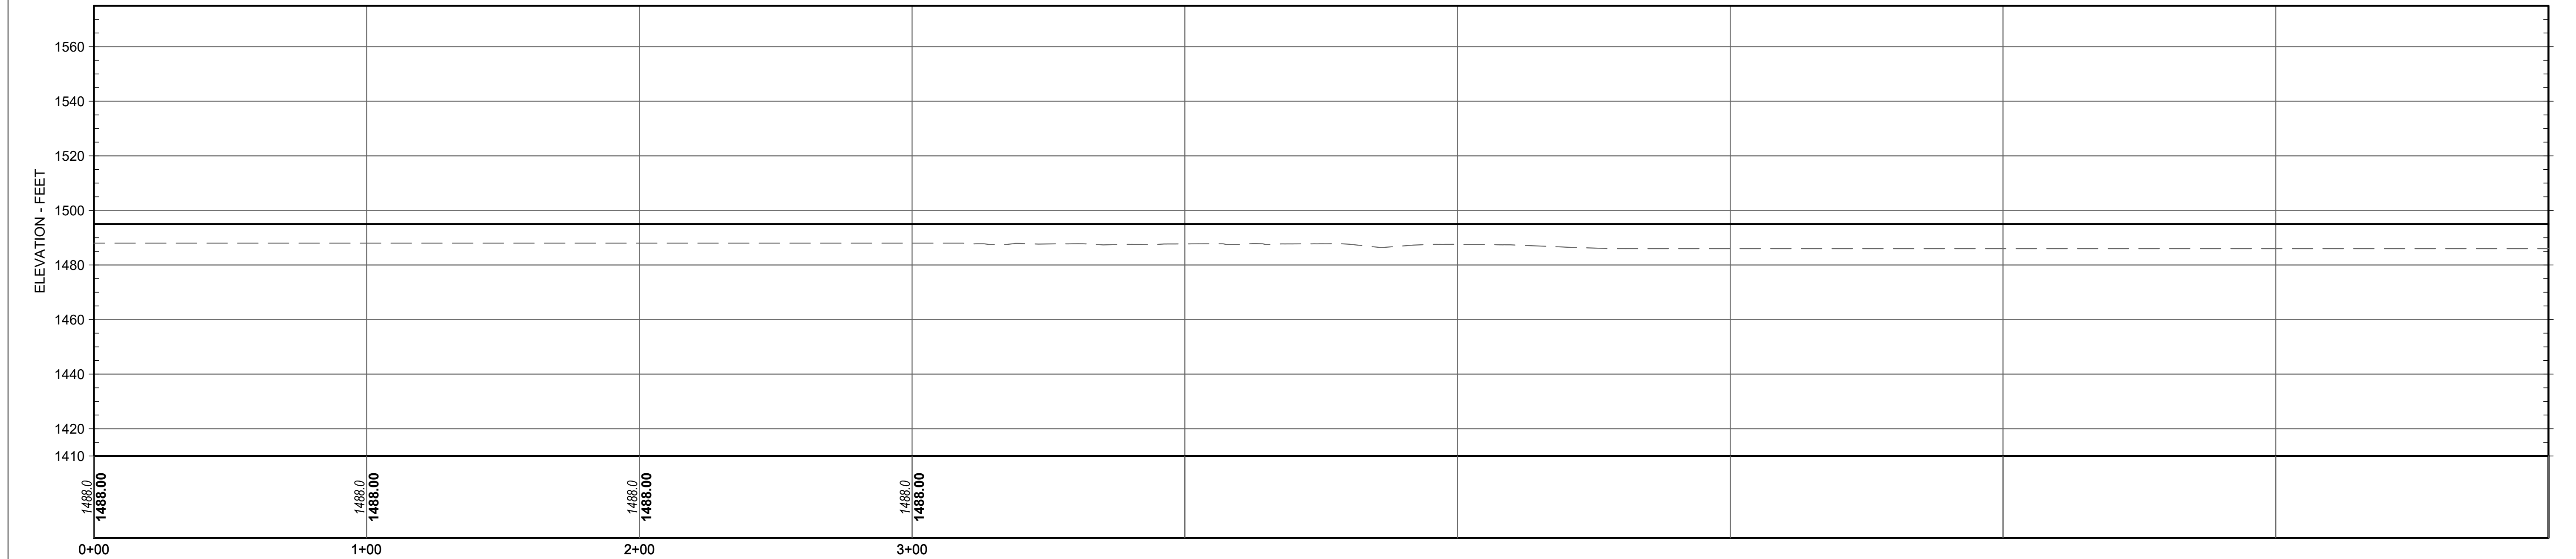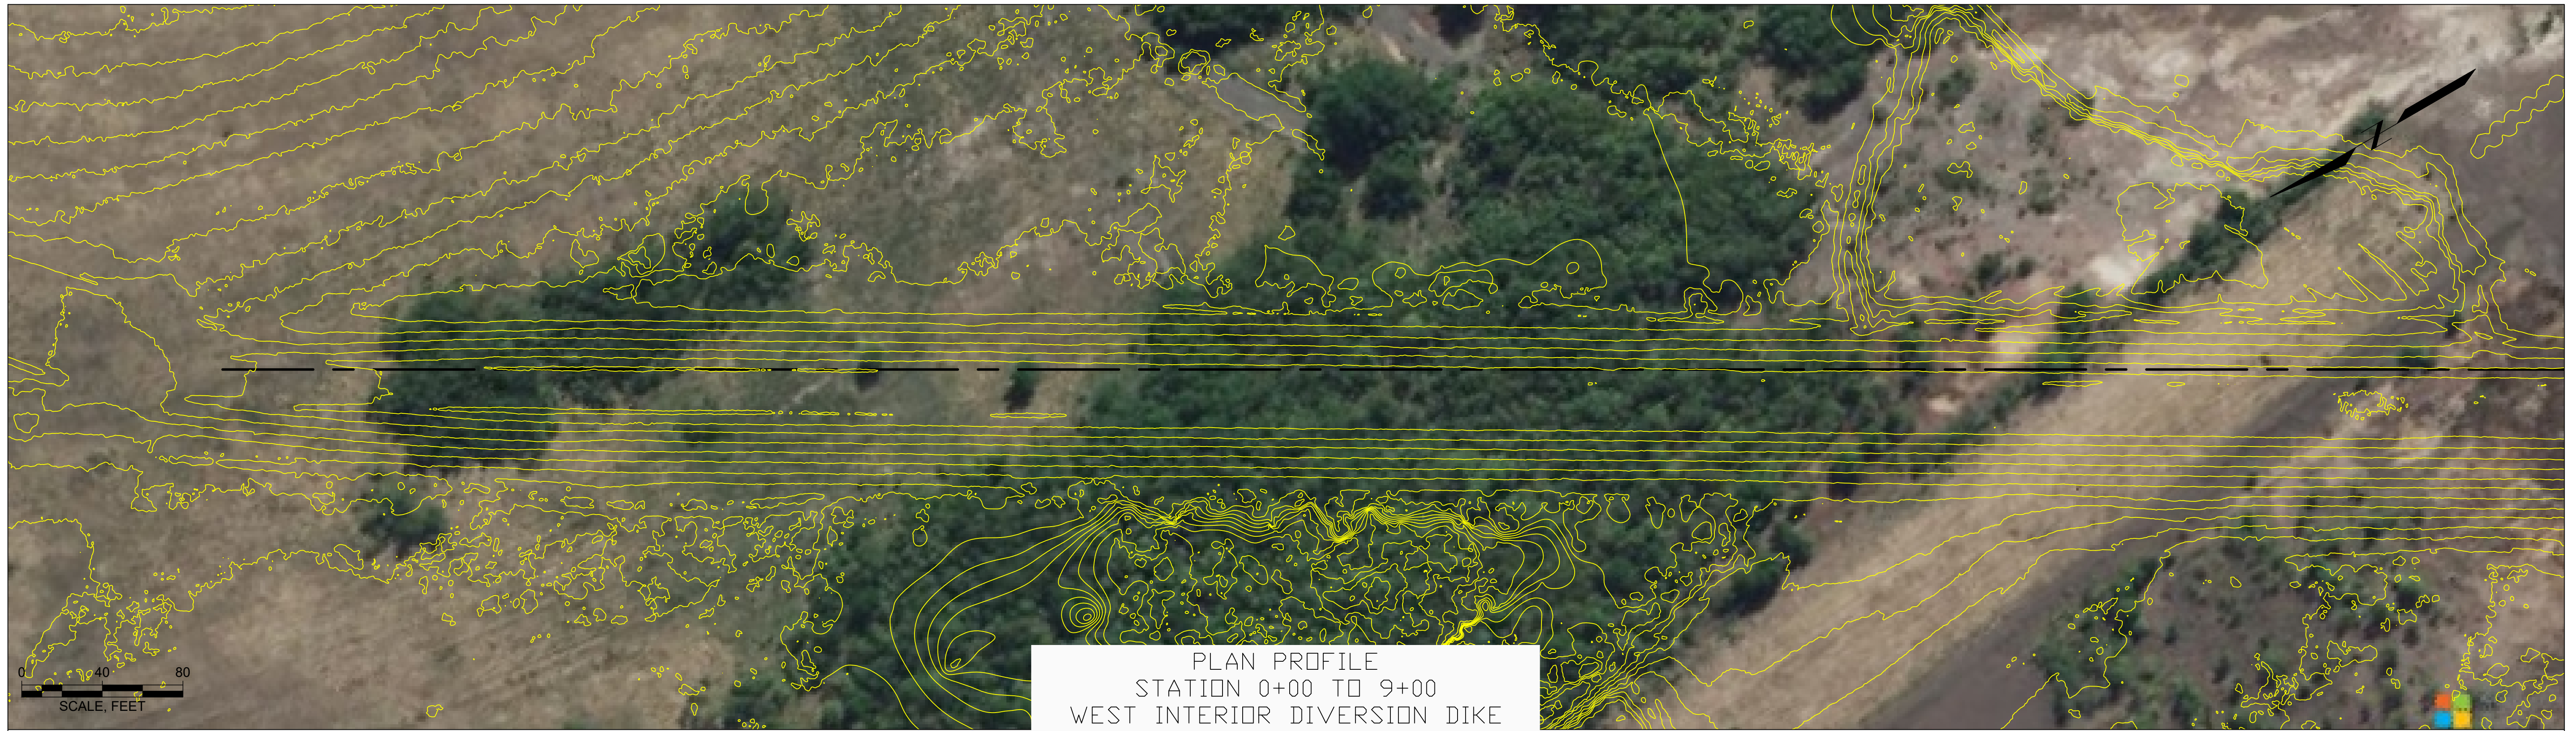


ELEVATIONS ARE REFERENCED TO NORTH AMERICAN VERTICAL DATUM 1988



AERIAL IMAGE FROM PRIOR TO CONSTRUCTION AND IS NOT REPRESENTATIVE OF FINAL PROFILES OR CONDITIONS

<p>Attention:</p> <p>If this scale bar does not measure 1" then drawing is not original scale.</p>	<i>Designed:</i> BJB
	<i>Drawn:</i> BJB
	<i>Checked:</i> JPB
	<i>Approved:</i> JPB
	<i>P.E. No:</i> 40594
<i>GEI Project</i> 2200074	



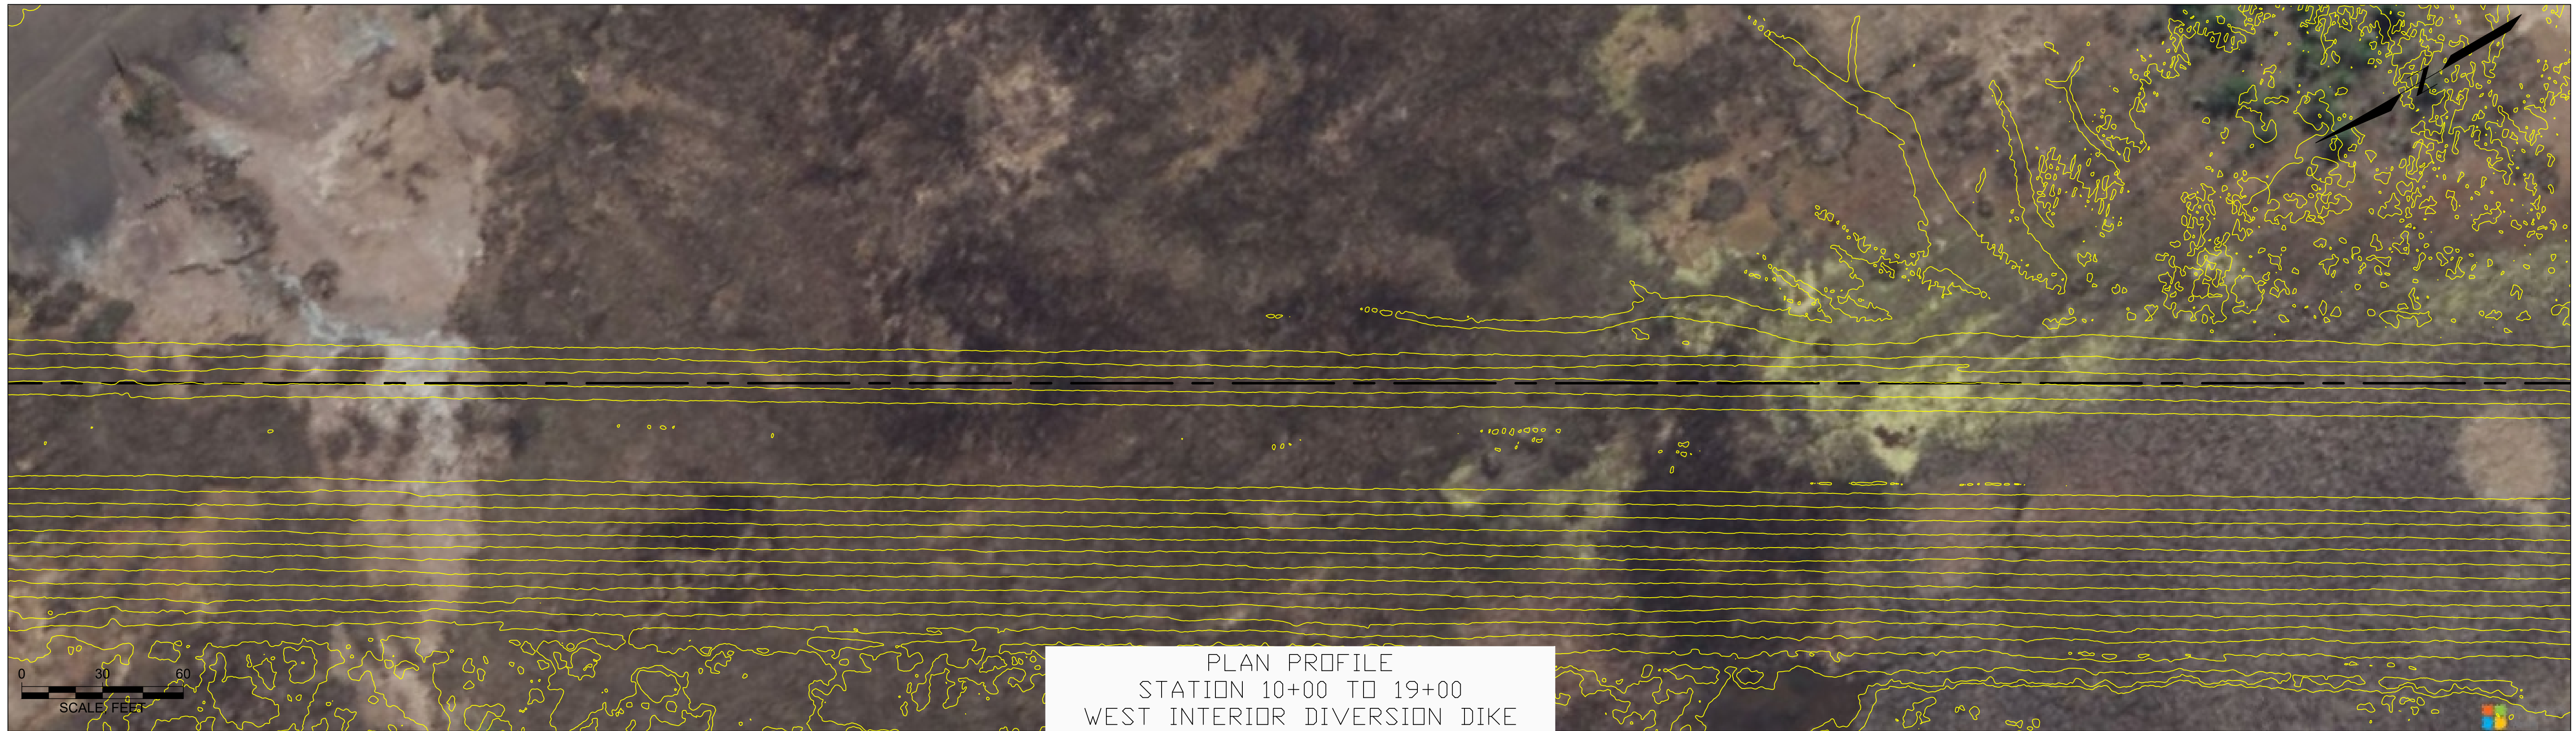

PLAN PROFILE
STATION 10+00 TO 19+00
WEST INTERIOR DIVERSION DIKE

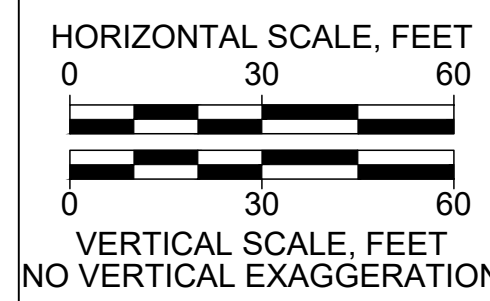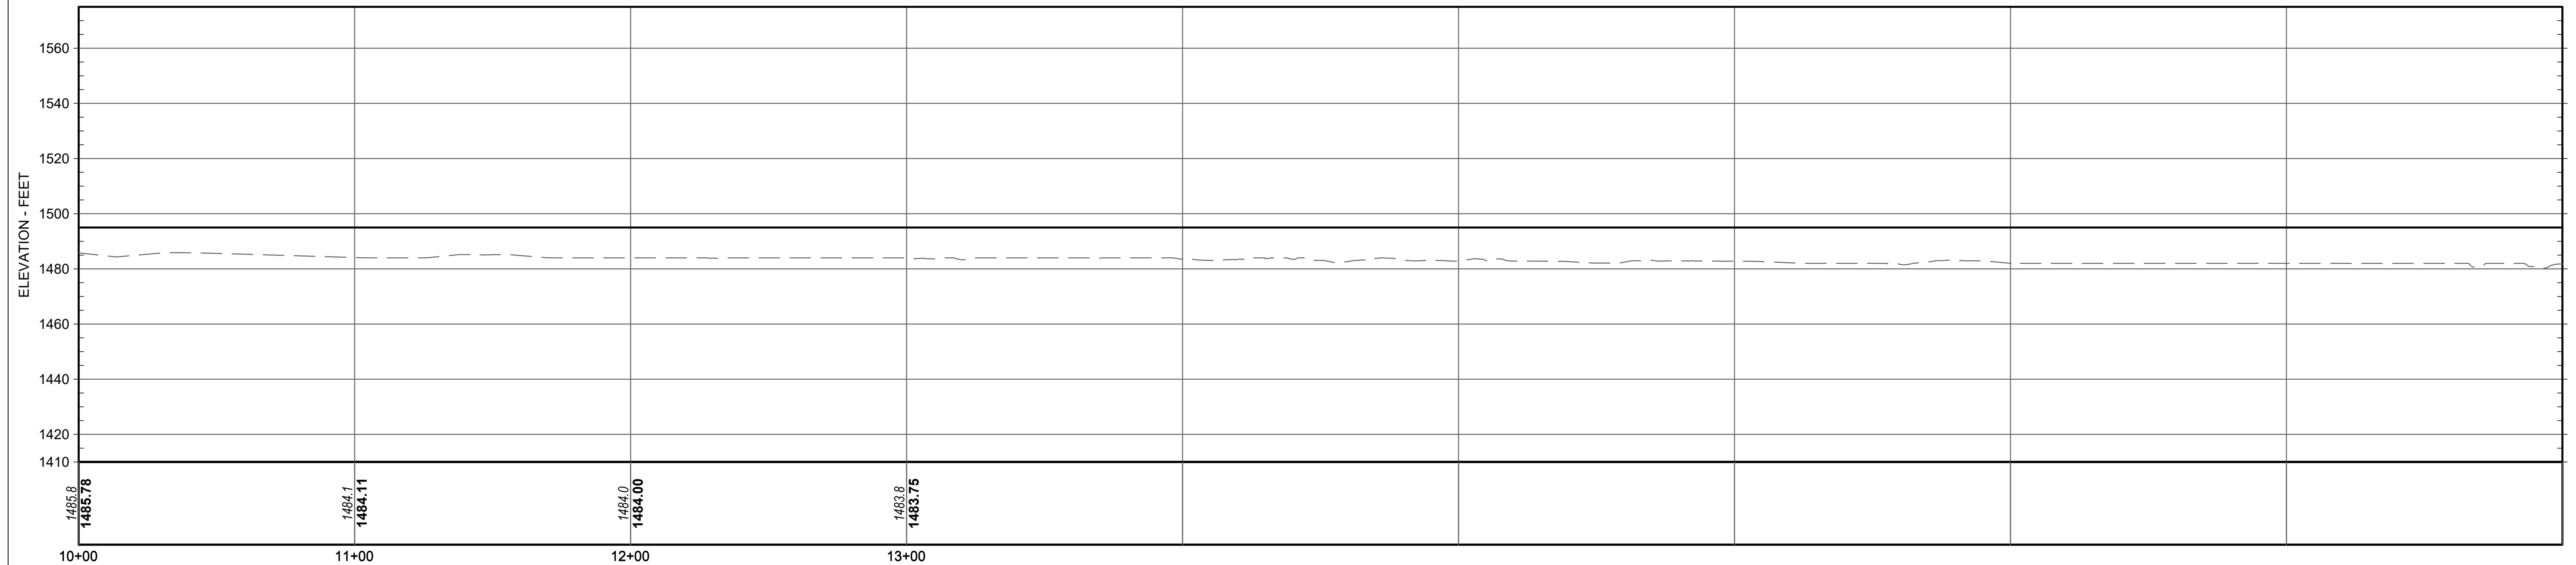

ELEVATIONS ARE REFERENCED TO NORTH
AMERICAN VERTICAL DATUM 1988

AERIAL IMAGE FROM PRIOR TO CONSTRUCTION AND IS
NOT REPRESENTATIVE OF FINAL PROFILES OR CONDITIONS

<p>Attention:</p> <p>If this scale bar does not measure 1" then drawing is not original scale.</p>	Designed: BJB
	Drawn: BJB
	Checked: JPB
	Approved: JPB
	P.E. No: 40594
GEI Project 2300038	



PROFILE VIEW
STATION 10+00 TO 19+00
WEST INTERIOR DIVERSION DIKE




ELEVATIONS ARE REFERENCED TO NORTH AMERICAN VERTICAL DATUM 1988



AERIAL IMAGE FROM PRIOR TO CONSTRUCTION AND IS NOT REPRESENTATIVE OF FINAL PROFILES OR CONDITIONS

Attention: If this scale bar does not measure 1" then drawing is not original scale.	Designed: BJF
	Drawn: BJF
	Checked: JPB
	Approved: JPB
	P.E. No: 40594
GEI Project 2200074	

8/8/2024 1:17:00 PM C:\Users\hbfac325\OneDrive - GEI Consultants, Inc\Desktop\Kearz 2024\West Internal Dwg-2024\FG - West Interior Division Dwg - (1) - (3).dwg

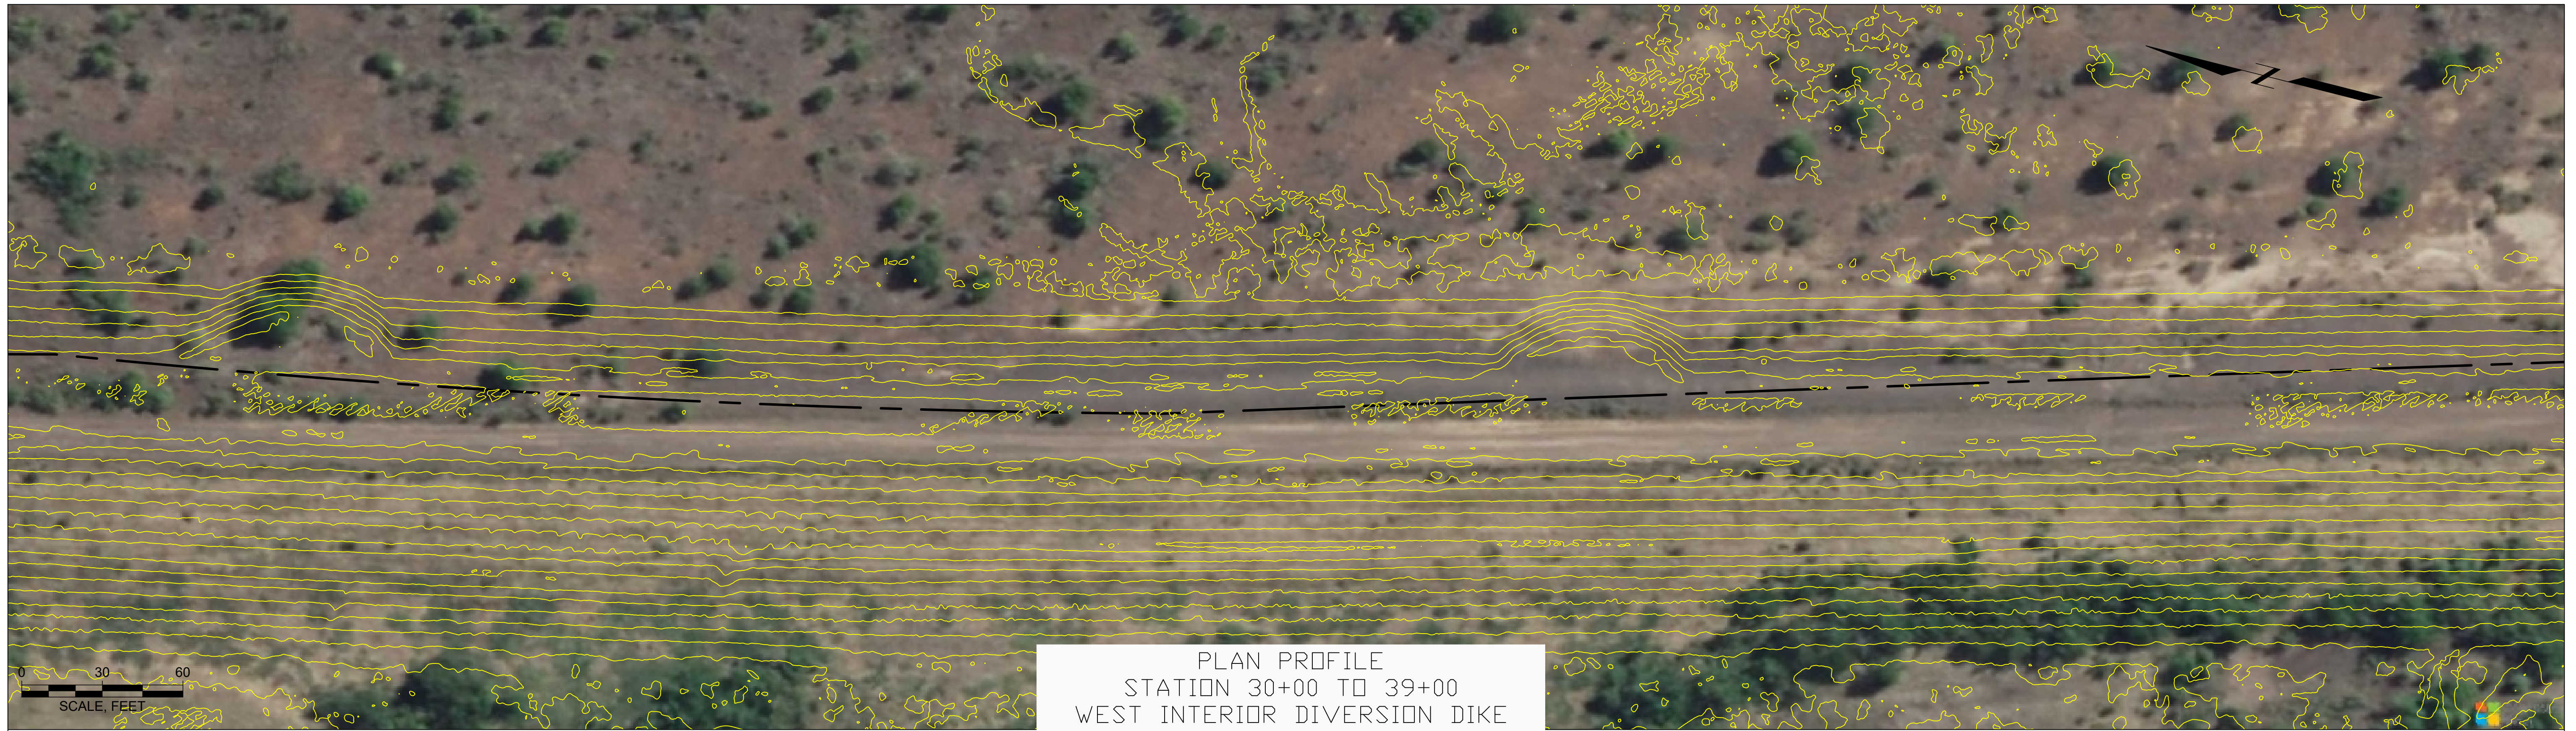


PLAN PROFILE
 STATION 30+00 TO 39+00
 WEST INTERIOR DIVERSION DIKE

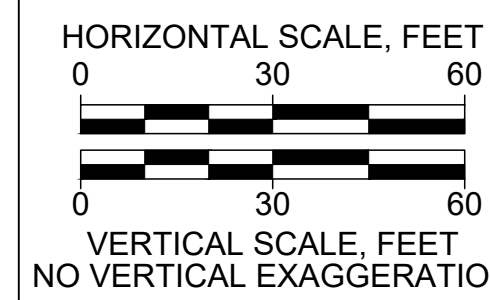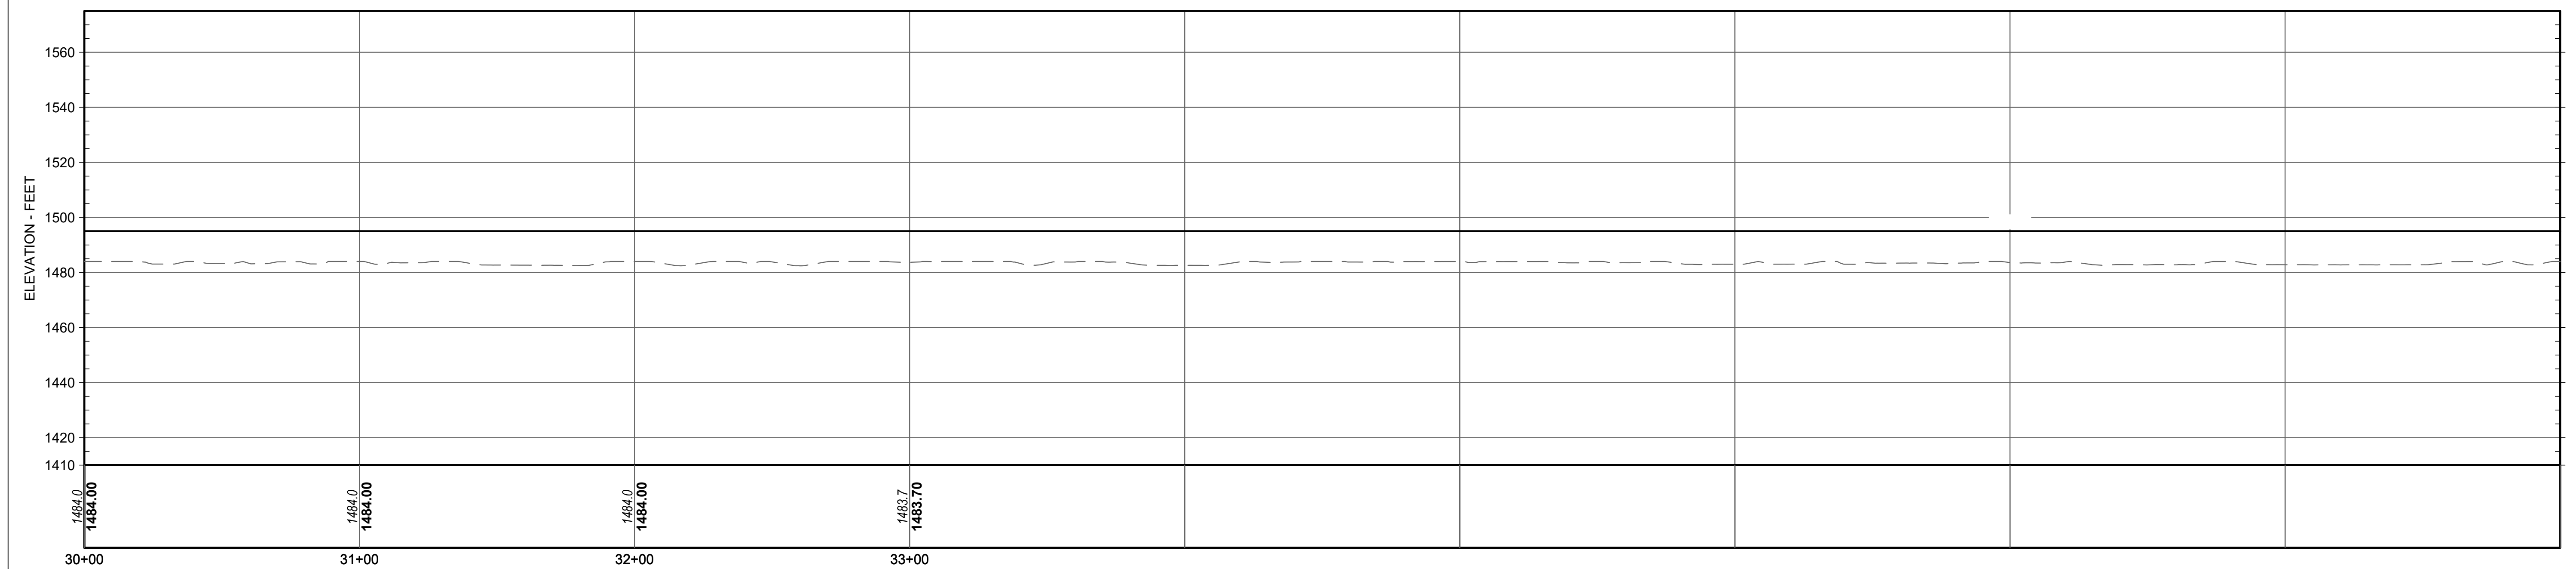



PROFILE VIEW
 STATION 30+00 TO 39+00
 WEST INTERIOR DIVERSION DIKE

ELEVATIONS ARE REFERENCED TO NORTH
 AMERICAN VERTICAL DATUM 1988

AERIAL IMAGE FROM PRIOR TO CONSTRUCTION AND IS
 NOT REPRESENTATIVE OF FINAL PROFILES OR CONDITIONS

Attention:  If this scale bar does not measure 1" then drawing is not original scale.	<i>Designed:</i> BJJ
	<i>Drawn:</i> BJJ
	<i>Checked:</i> JPB
	<i>Approved:</i> JPB
	<i>P.E. No.:</i> 40594
<i>GEI Project:</i> 2200074	



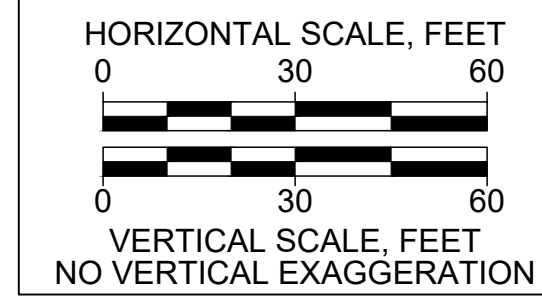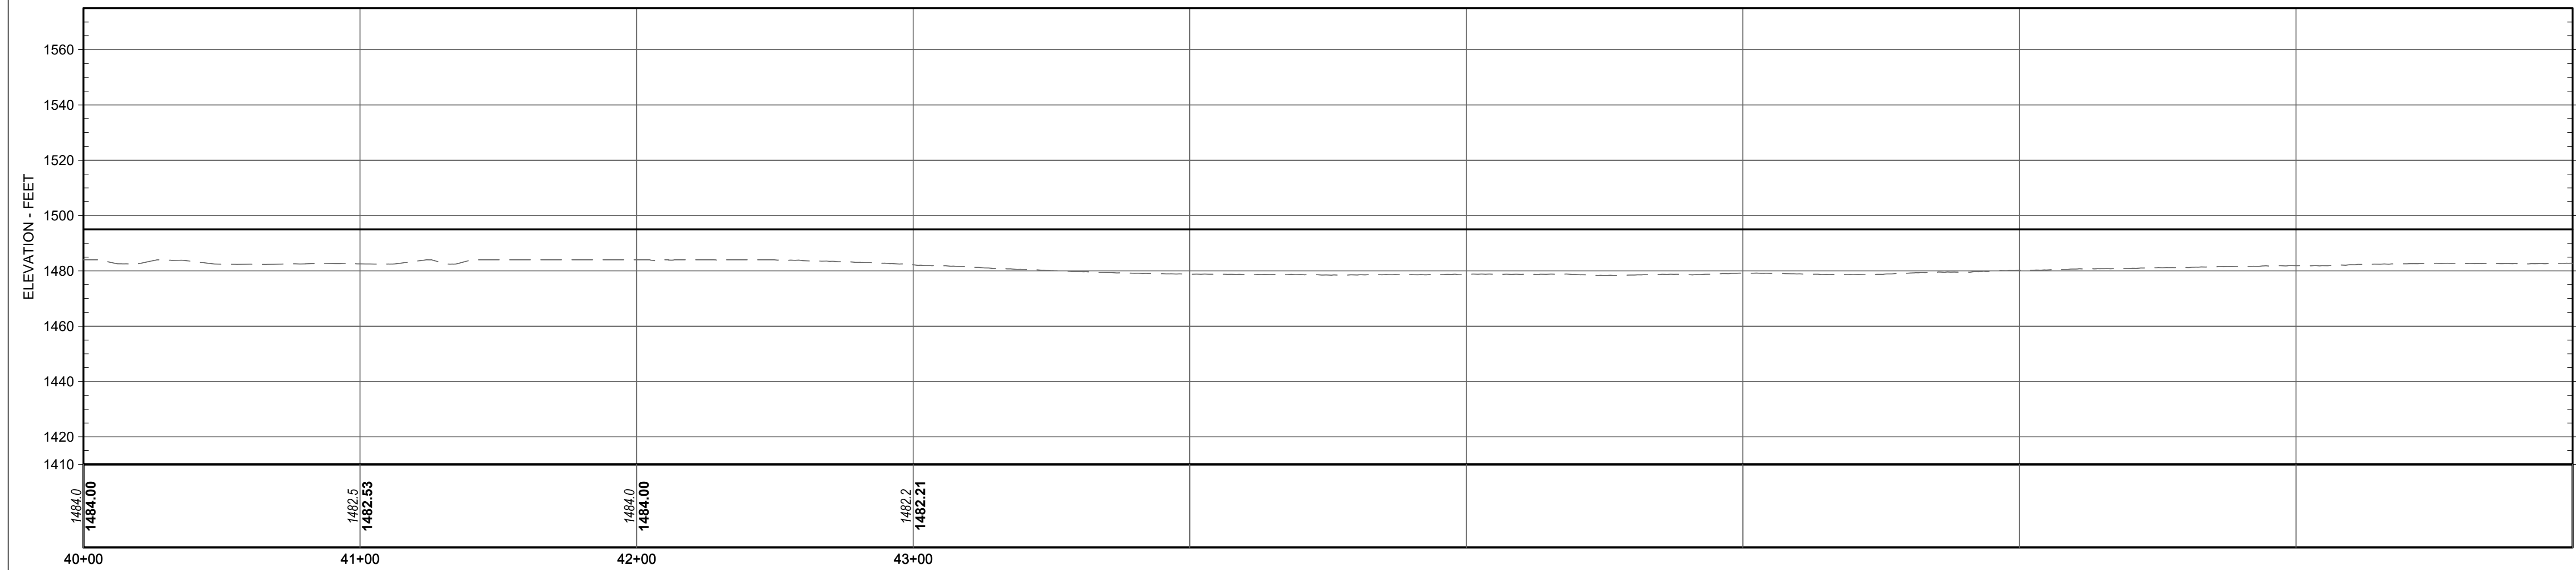

PROFILE VIEW
STATION 40+00 TO 49+00
WEST INTERIOR DIVERSION DIKE

ELEVATIONS ARE REFERENCED TO NORTH
AMERICAN VERTICAL DATUM 1988



AERIAL IMAGE FROM PRIOR TO CONSTRUCTION AND IS
NOT REPRESENTATIVE OF FINAL PROFILES OR CONDITIONS

<p>Attention:</p> <p>If this scale bar does not measure 1" then drawing is not original scale.</p>	Designed: BJB
	Drawn: BJB
	Checked: JPB
	Approved: JPB
	P.E. No: 40594
GEI Project 2200074	





PLAN PROFILE
STATION 50+00 TO 59+00
WEST INTERIOR DIVERSION DIKE

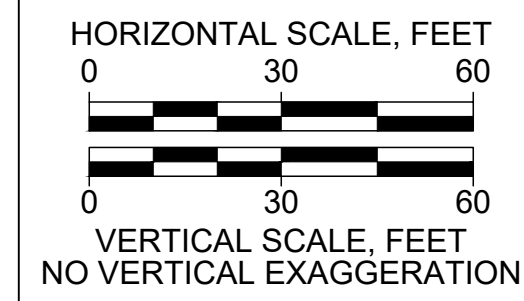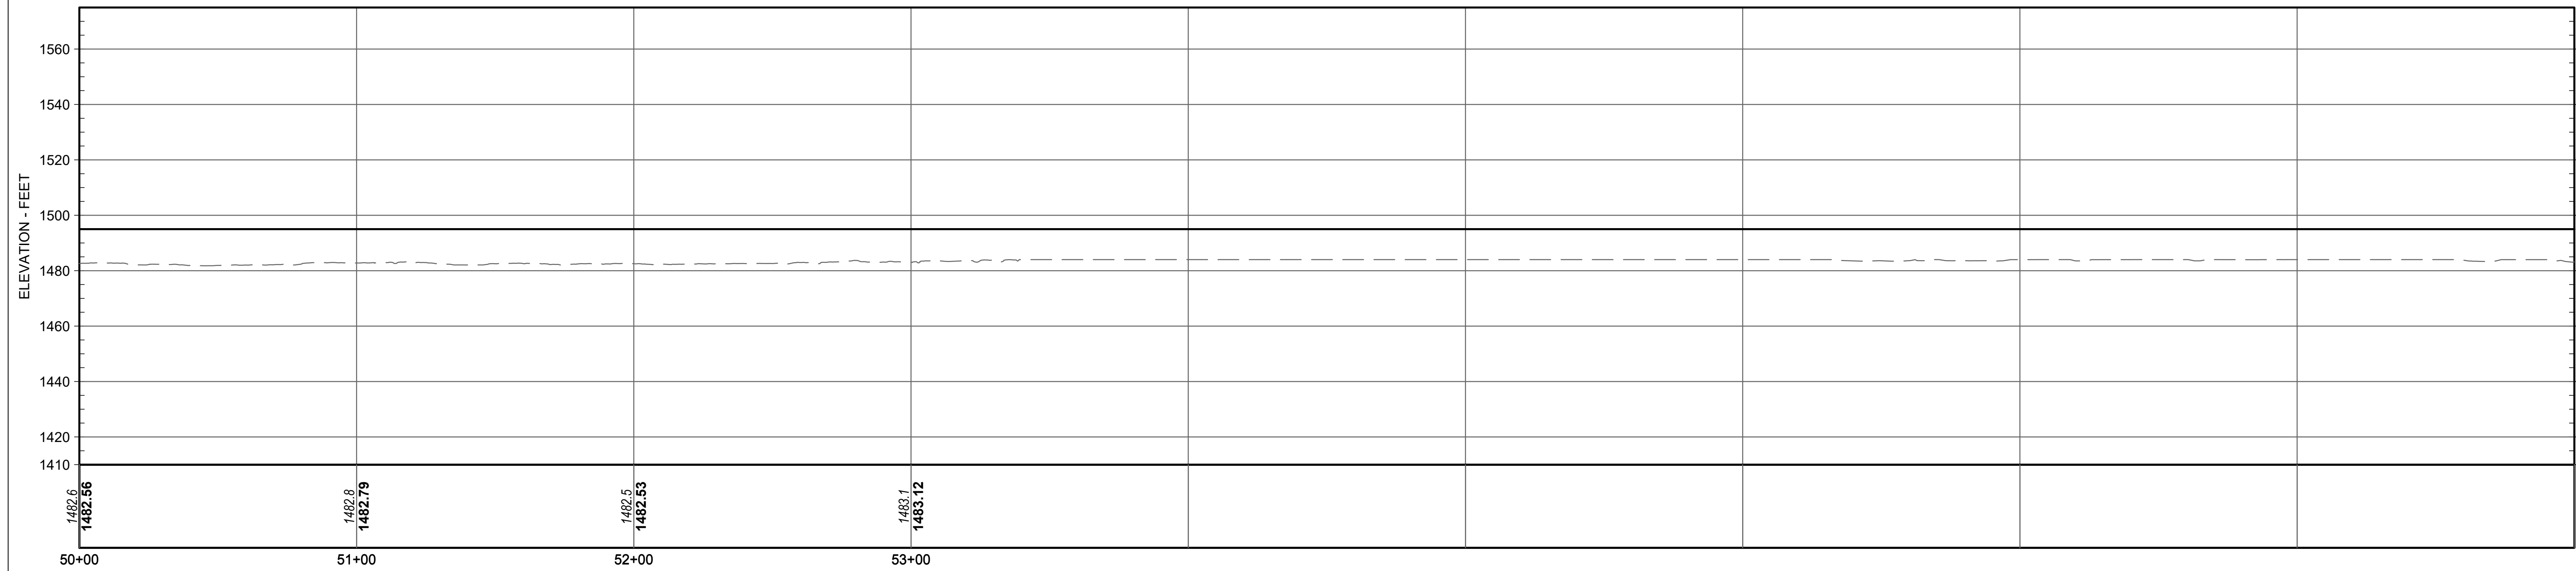

PROFILE VIEW
STATION 50+00 TO 59+00
WEST INTERIOR DIVERSION DIKE

ELEVATIONS ARE REFERENCED TO NORTH
AMERICAN VERTICAL DATUM 1988



AERIAL IMAGE FROM PRIOR TO CONSTRUCTION AND IS
NOT REPRESENTATIVE OF FINAL PROFILES OR CONDITIONS

<p>Attention:</p> <p>If this scale bar does not measure 1" then drawing is not original scale.</p>	<i>Designed:</i> BJJ
	<i>Drawn:</i> BJJ
	<i>Checked:</i> JPB
	<i>Approved:</i> JPB
	<i>P.E. No:</i> 40594
	<i>GEI Project:</i> 2200074






PLAN PROFILE
 STATION 60+00 TO 69+00
 WEST INTERIOR DIVERSION DIKE

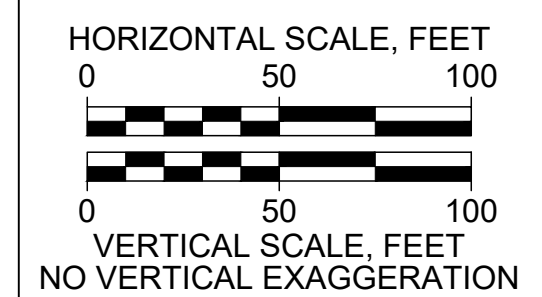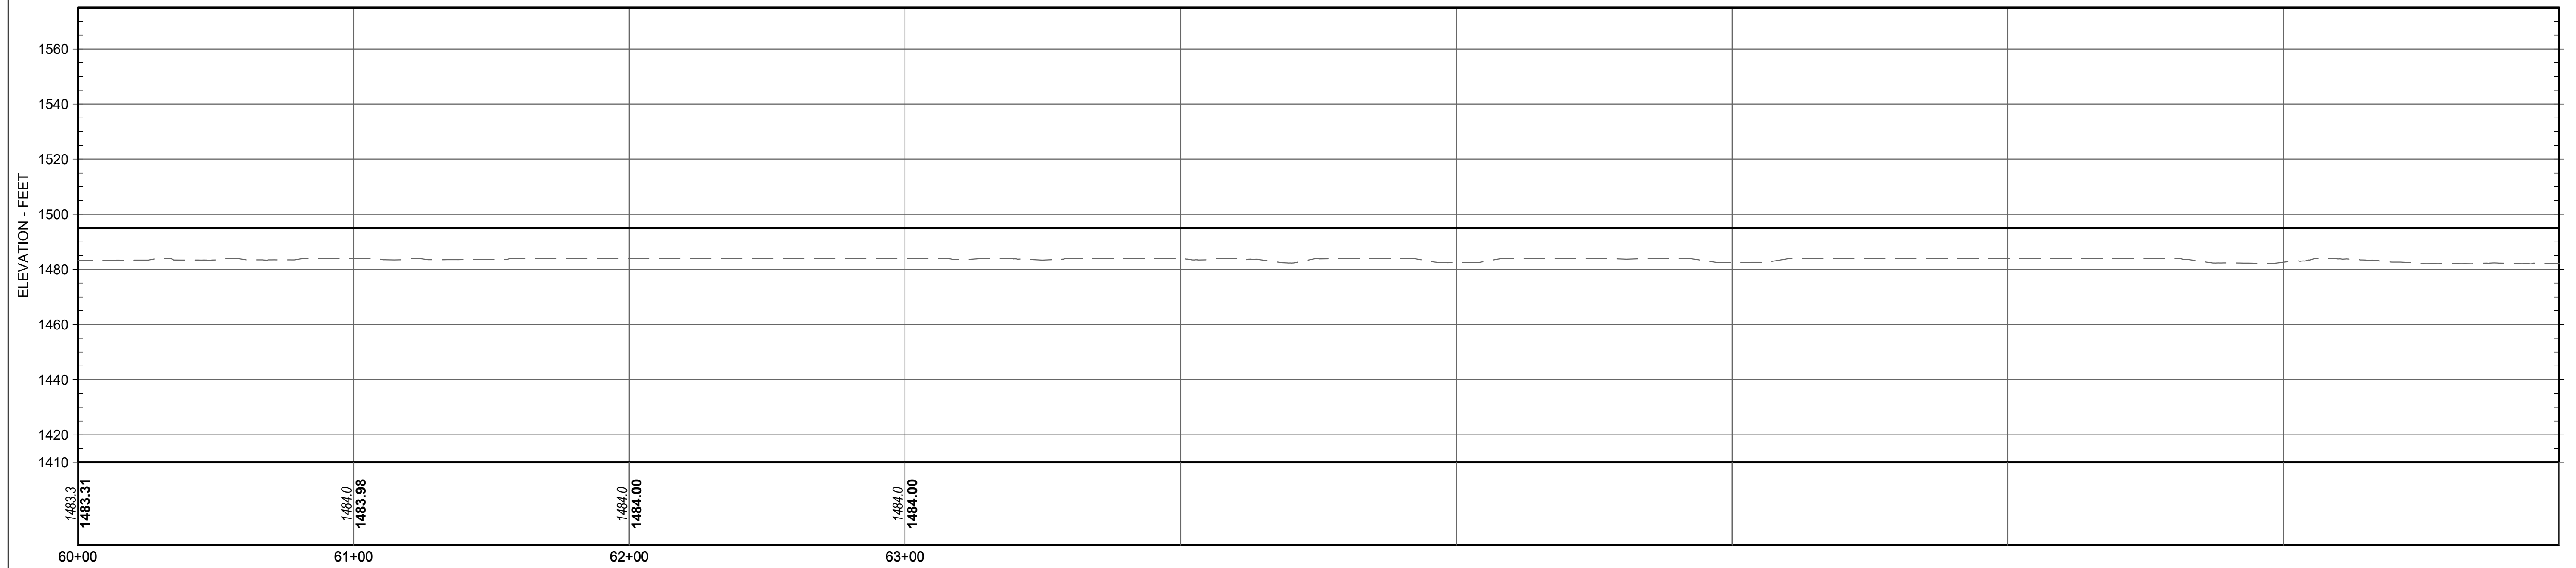


PROFILE VIEW
 STATION 60+00 TO 69+00
 WEST INTERIOR DIVERSION DIKE

ELEVATIONS ARE REFERENCED TO NORTH AMERICAN VERTICAL DATUM 1988
 AERIAL IMAGE FROM PRIOR TO CONSTRUCTION AND IS NOT REPRESENTATIVE OF FINAL PROFILES OR CONDITIONS


Attention:  If this scale bar does not measure 1" then drawing is not original scale.	Designed: BJF
	Drawn: BJF
	Checked: JPB
	Approved: JPB
	P.E. No: 40594
GEI Project 2200074	




8/8/2024 1:20:00 PM C:\Users\hrf\OneDrive - GEI Consultants, Inc\Desktop\Keratz 2024\West Interior Dike-2024\FG - West Interior Diversion Dike - (1) - (7) .dwg

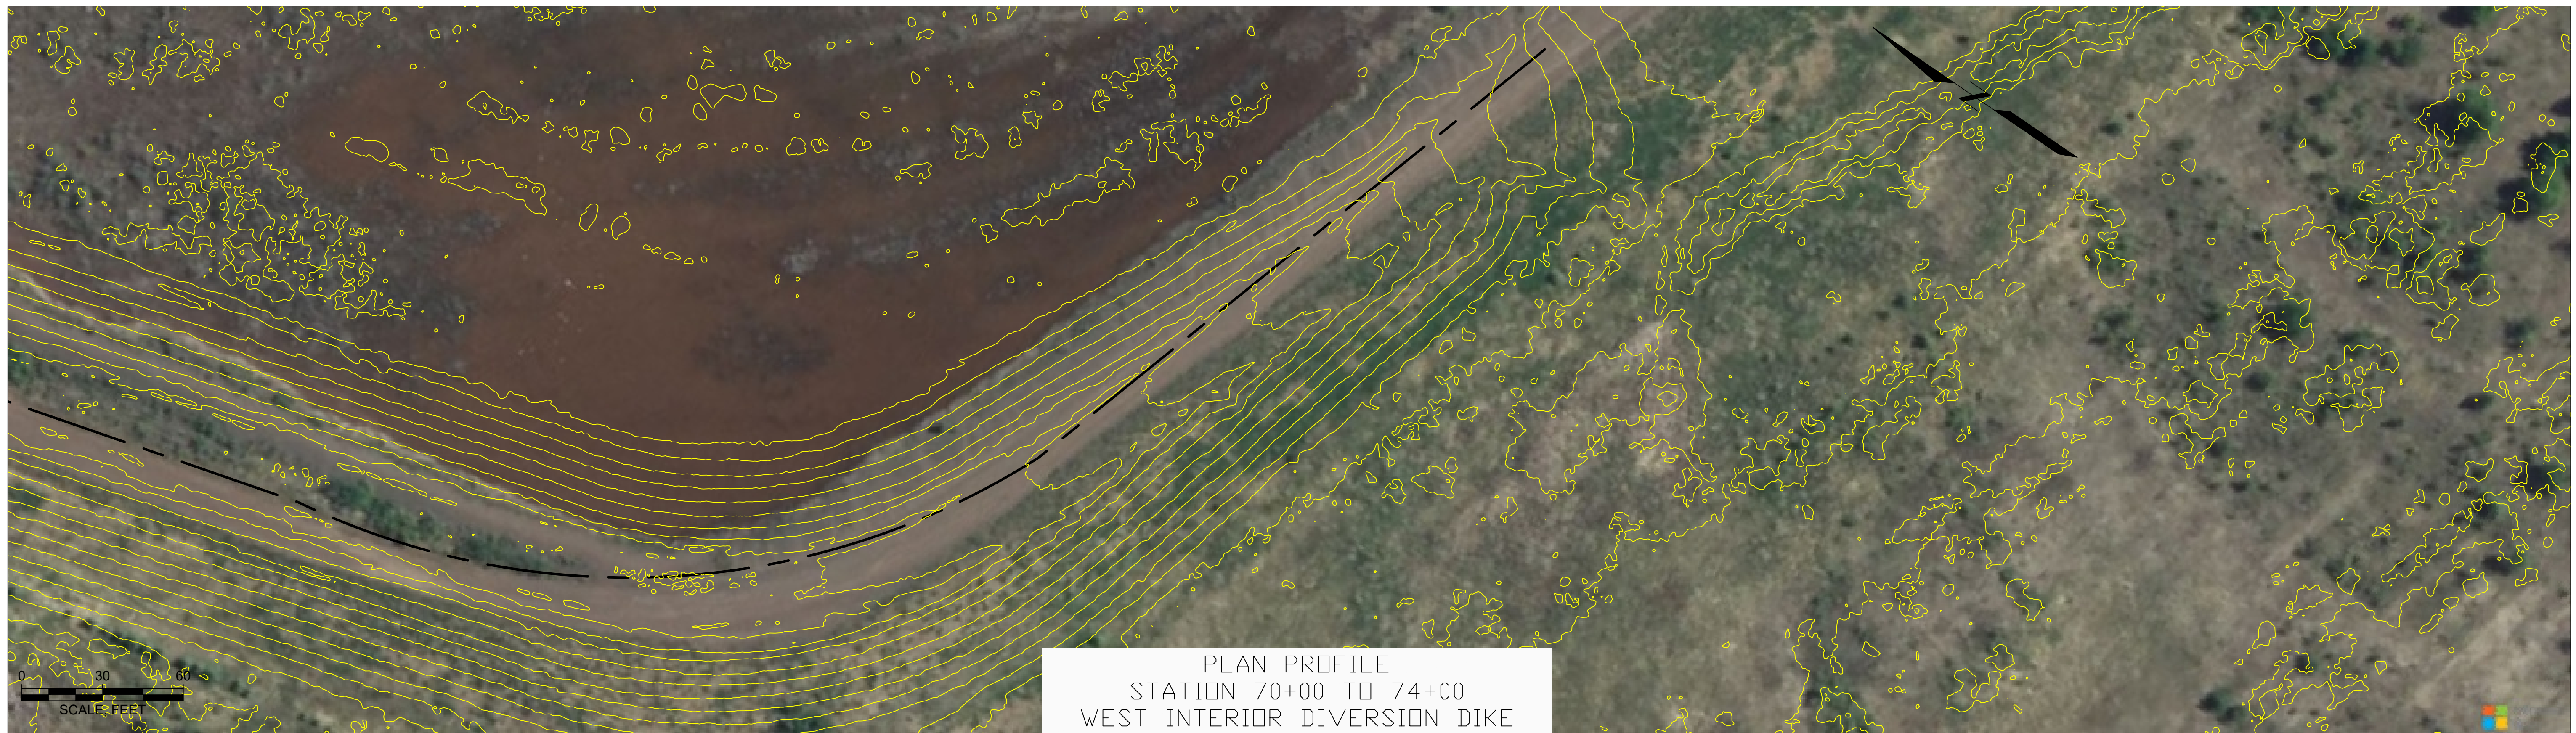

PLAN PROFILE
STATION 70+00 TO 74+00
WEST INTERIOR DIVERSION DIKE





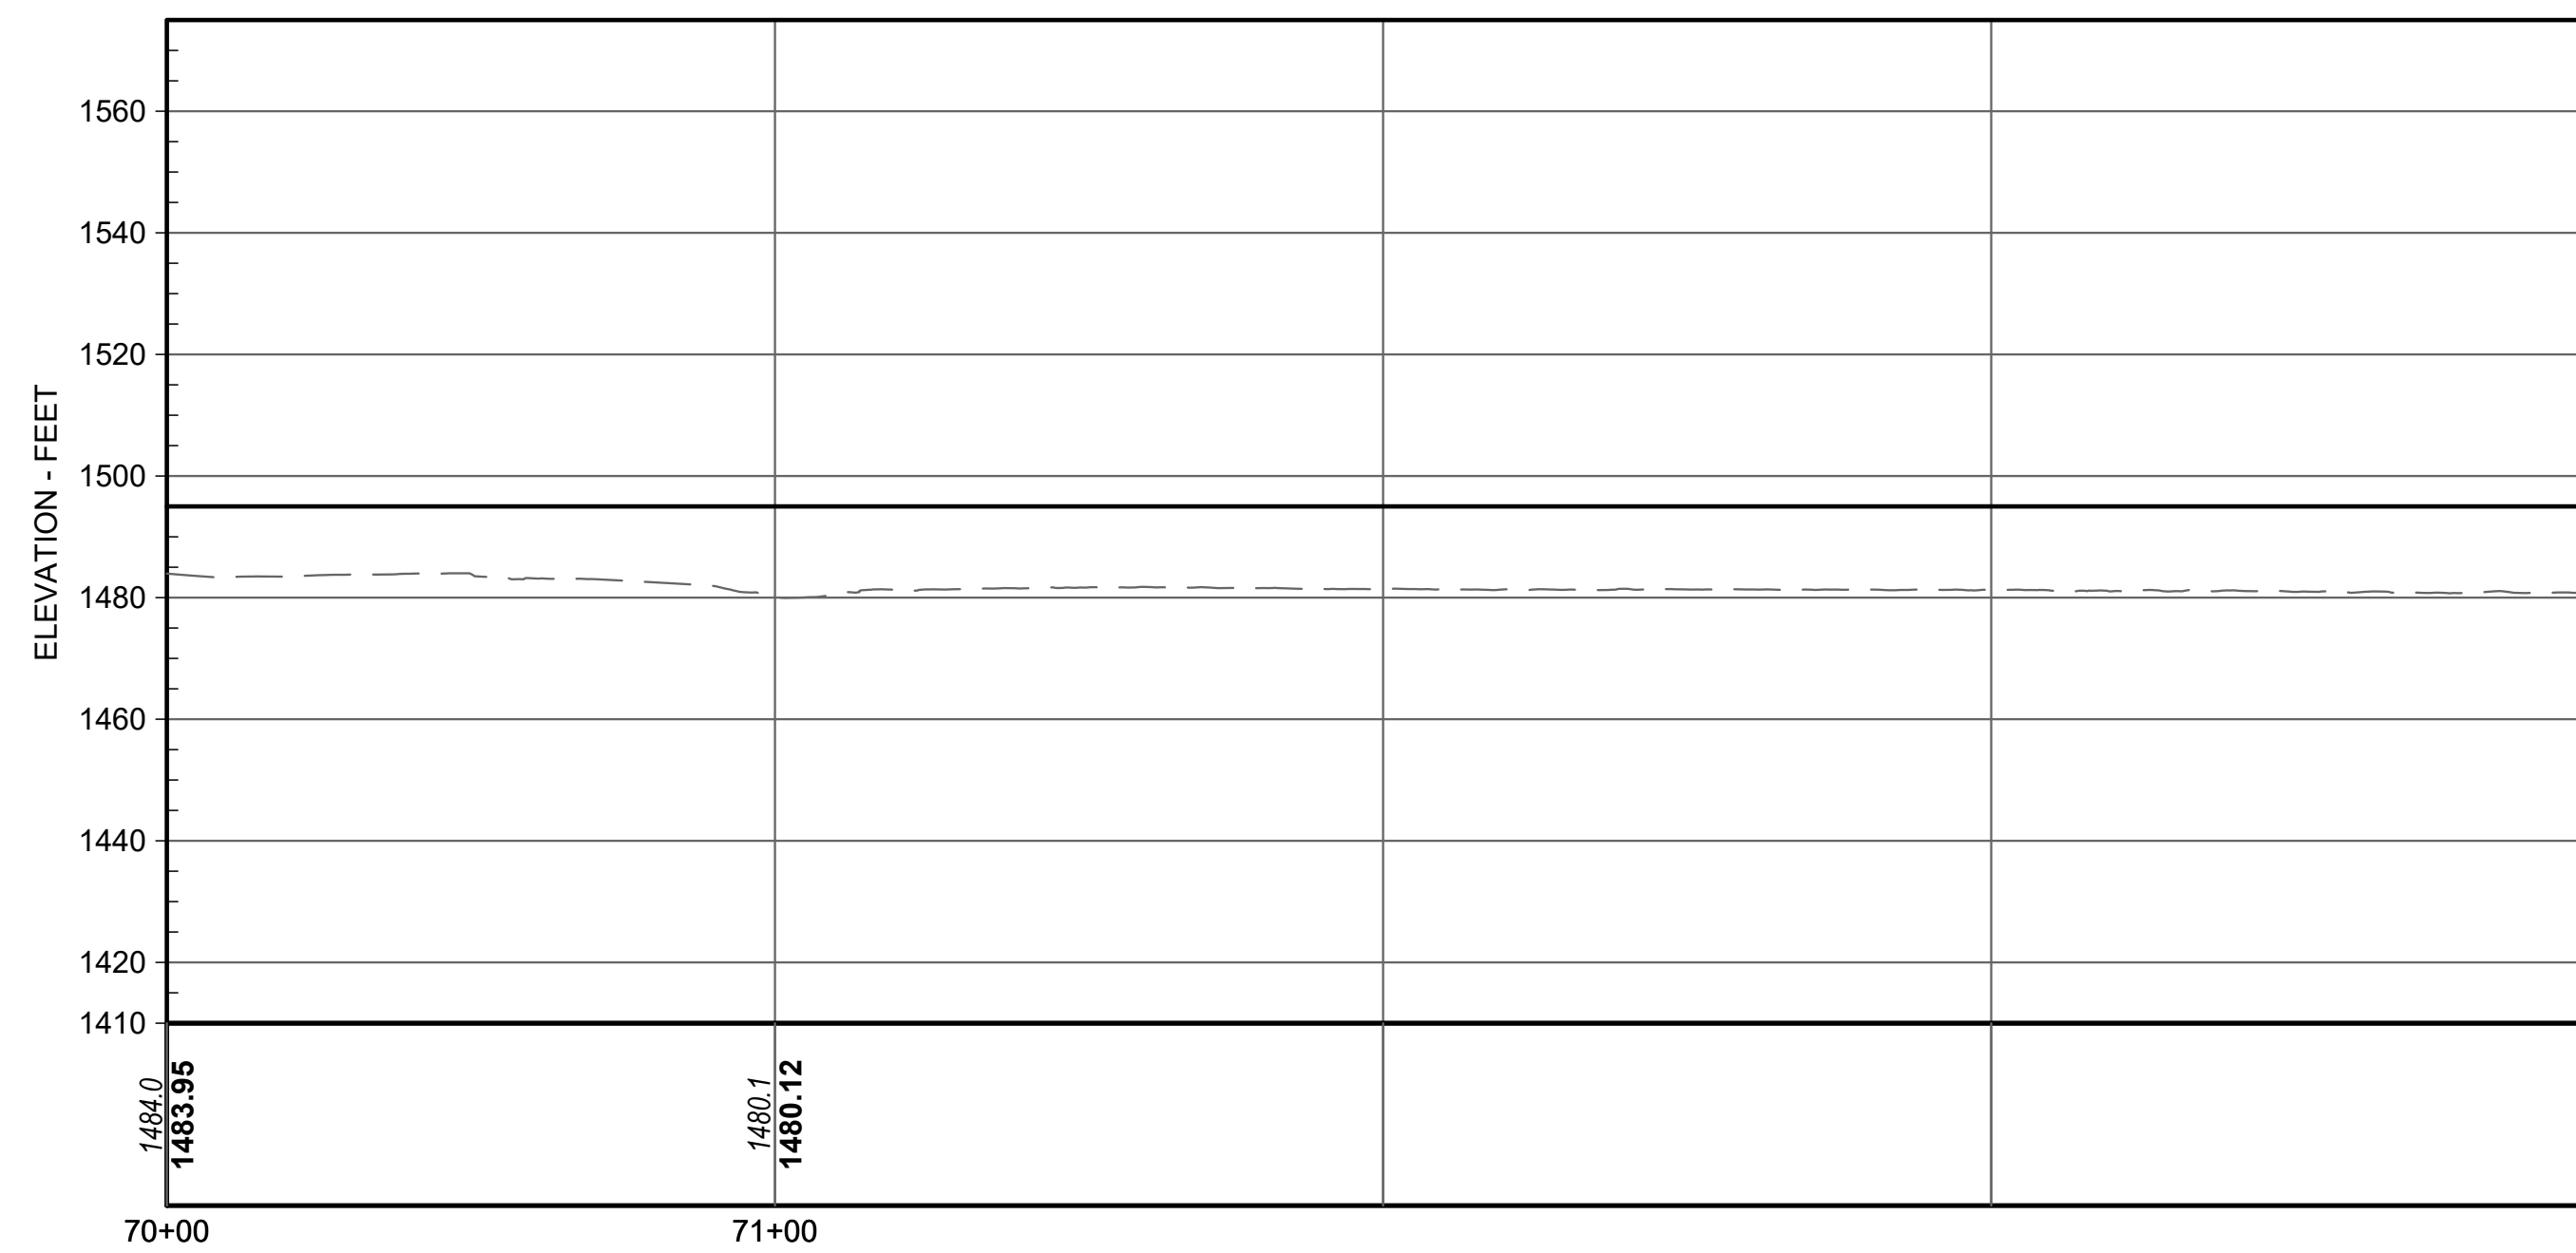


PROFILE VIEW
STATION 70+00 TO 74+00
WEST INTERIOR DIVERSION DIKE

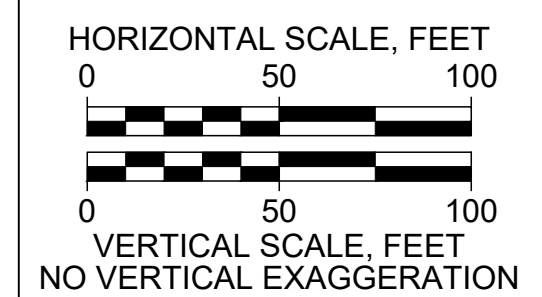

ELEVATIONS ARE REFERENCED TO NORTH AMERICAN VERTICAL DATUM 1988
AERIAL IMAGE FROM PRIOR TO CONSTRUCTION AND IS NOT REPRESENTATIVE OF FINAL PROFILES OR CONDITIONS

Attention: If this scale bar does not measure 1" then drawing is not original scale.	Designed: BJJ
	Drawn: BJJ
	Checked: JPB
	Approved: JPB
	P.E. No: 40594
GEI Project 2200074	

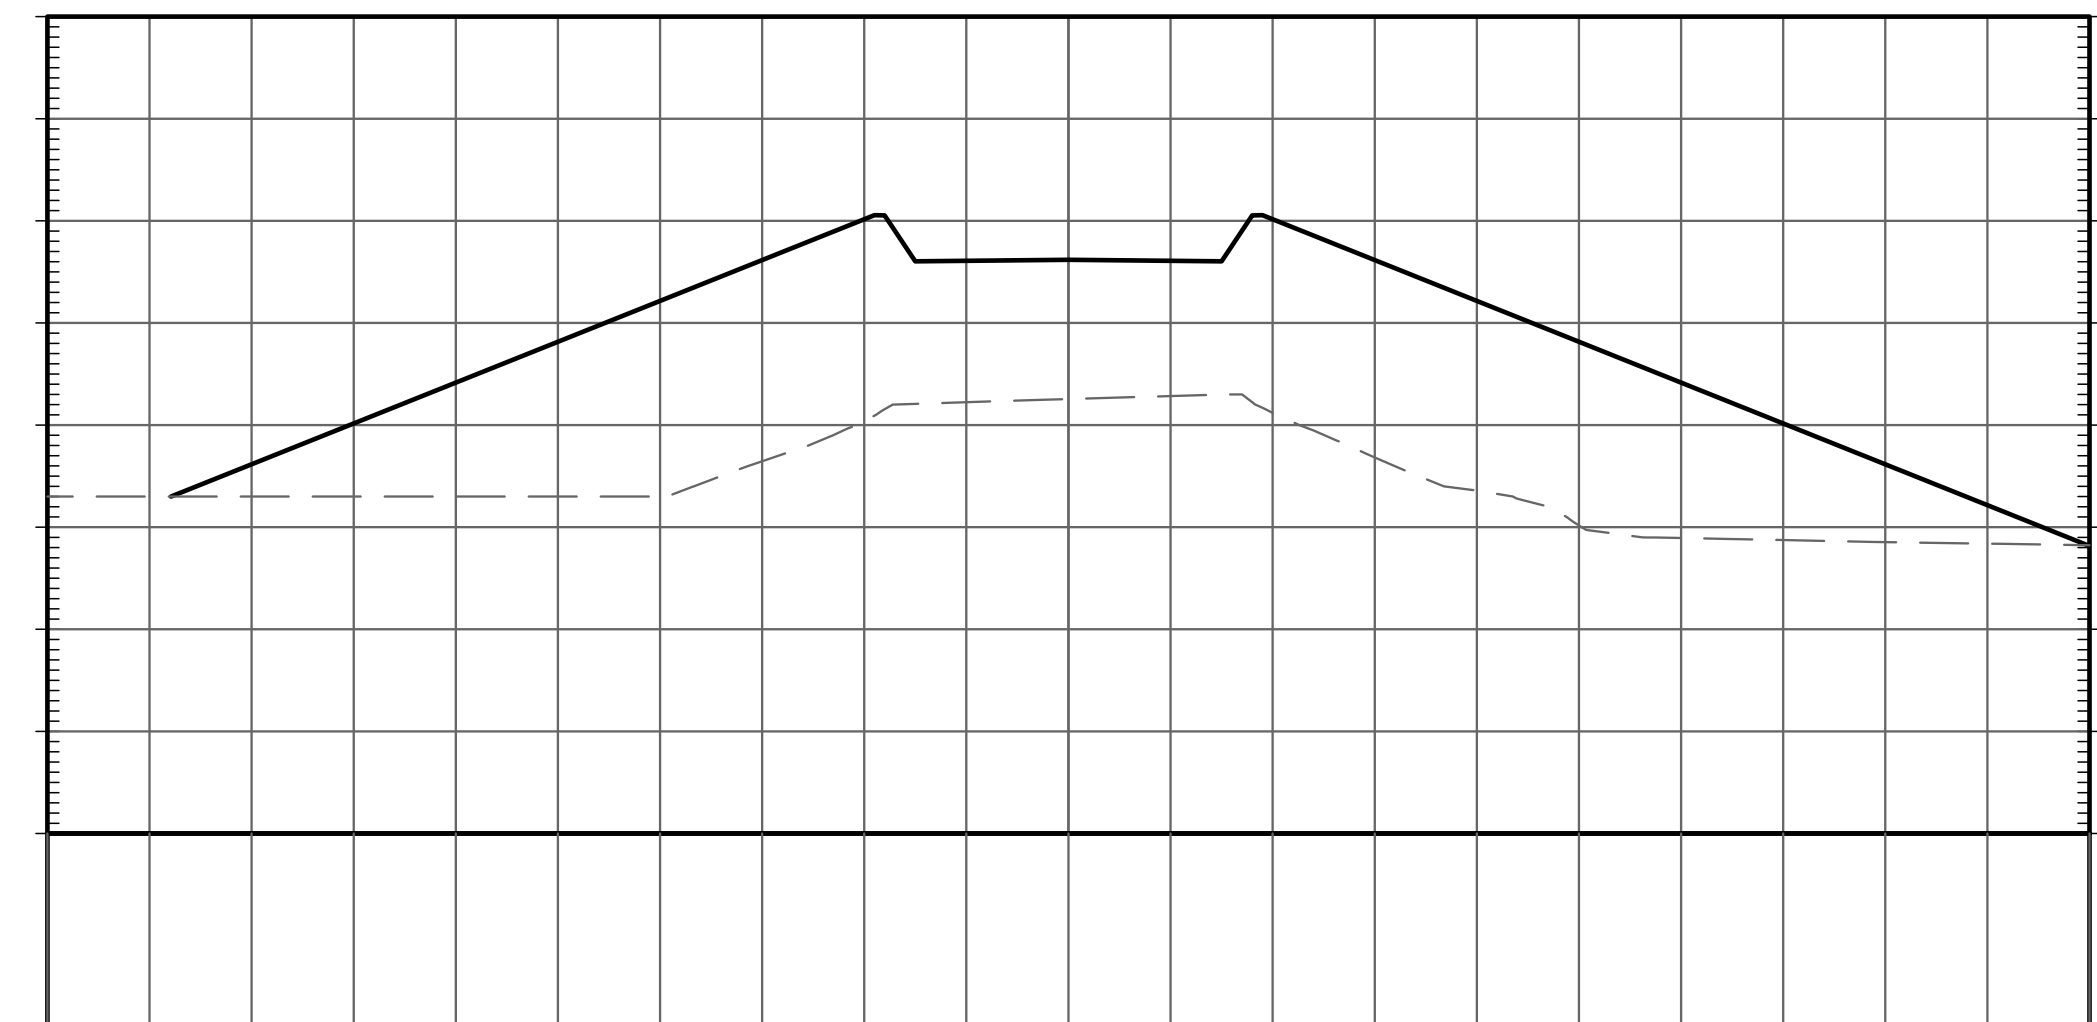
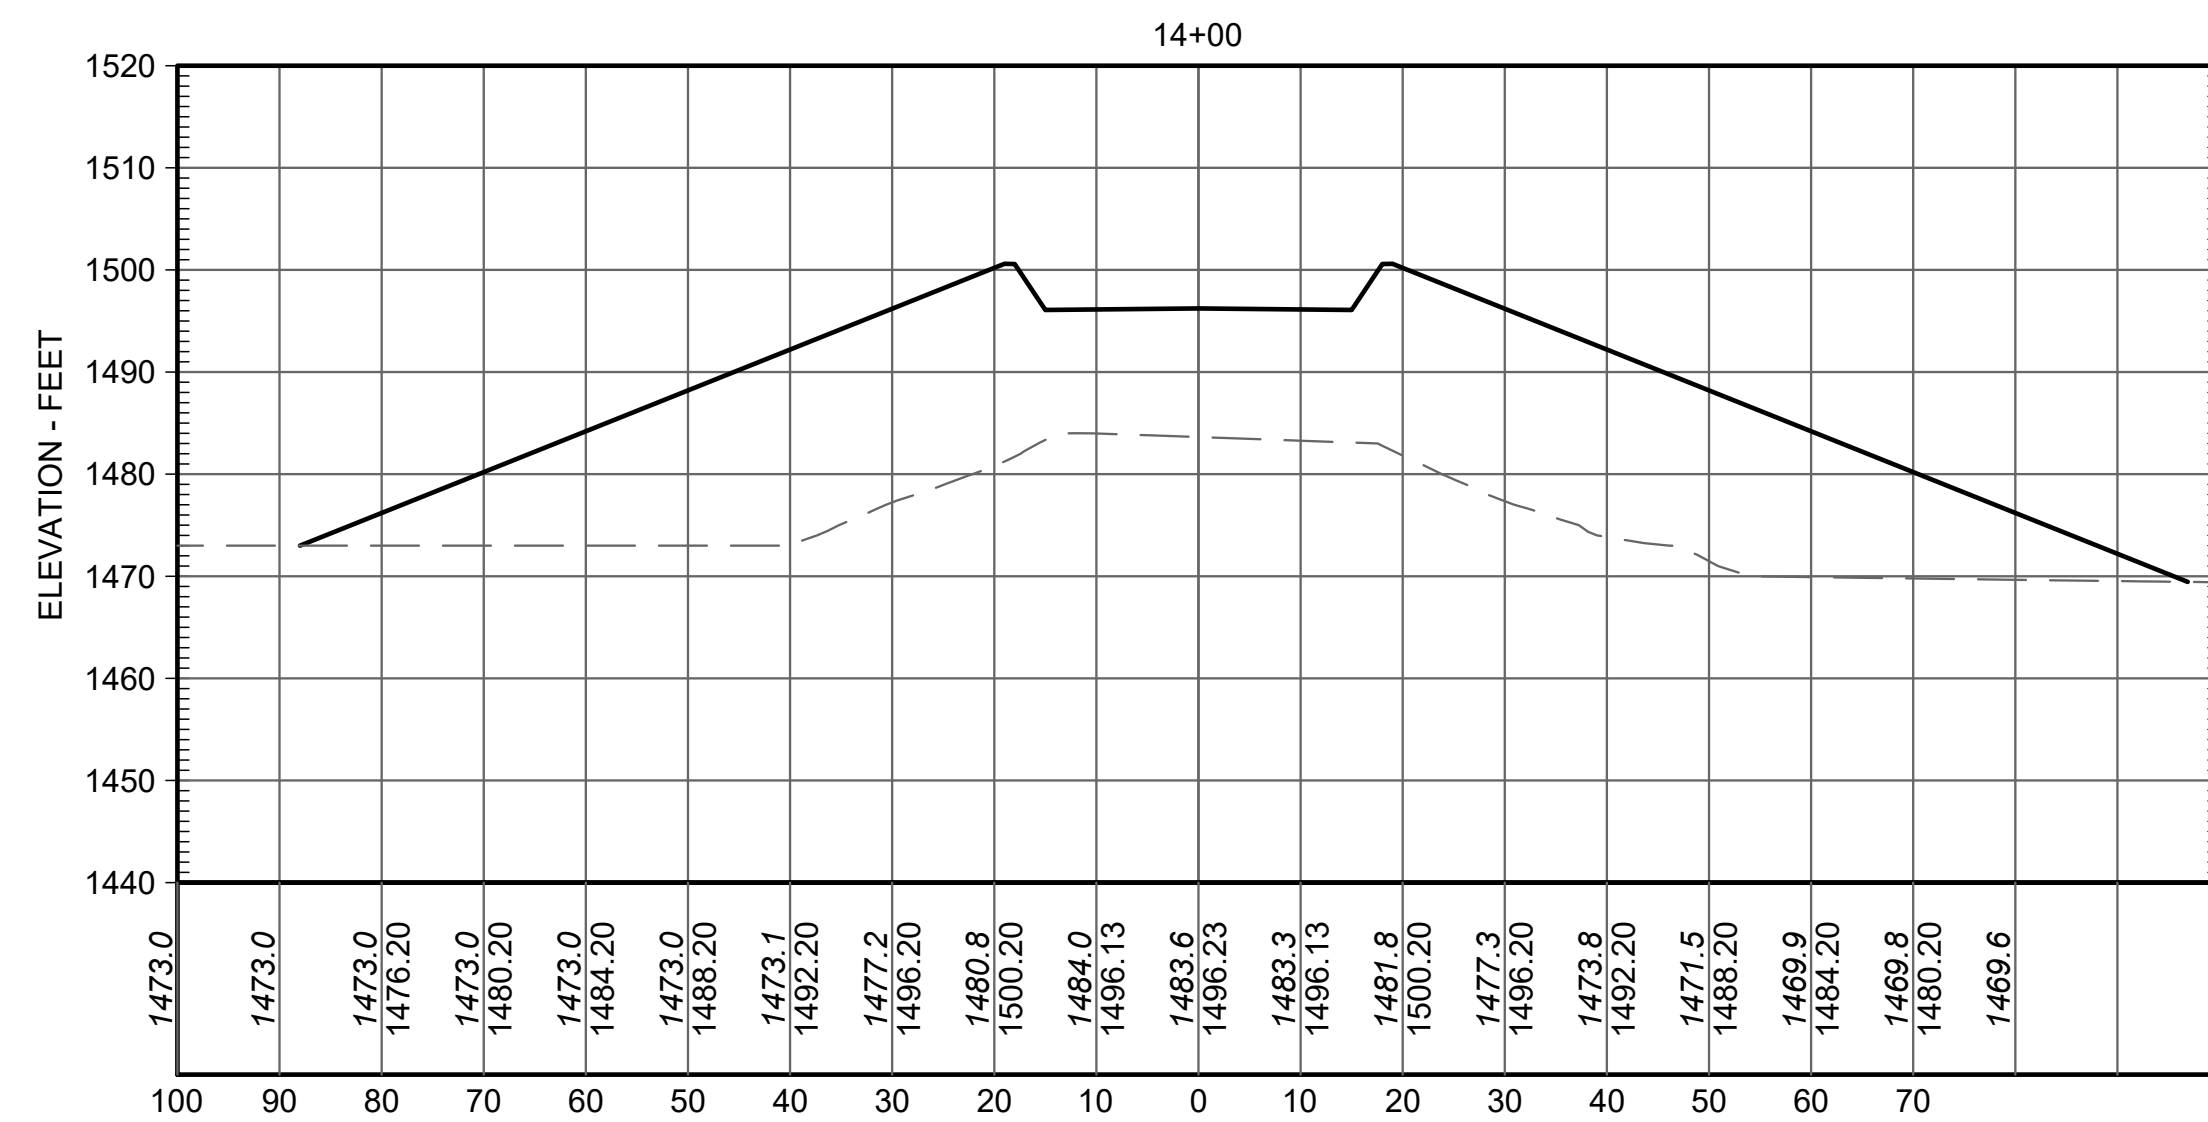
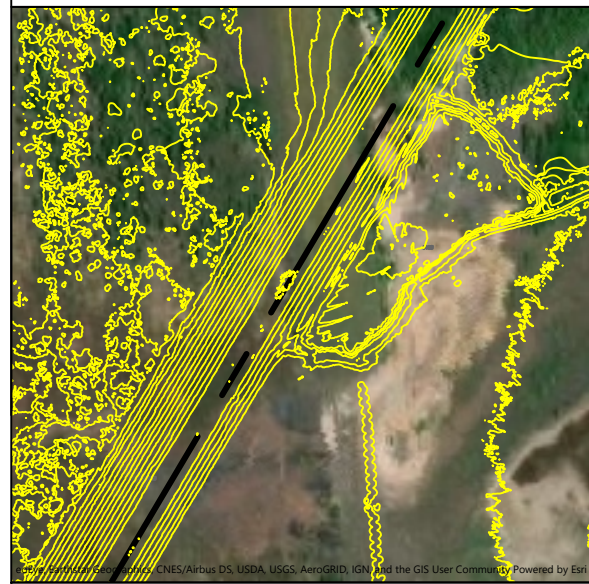
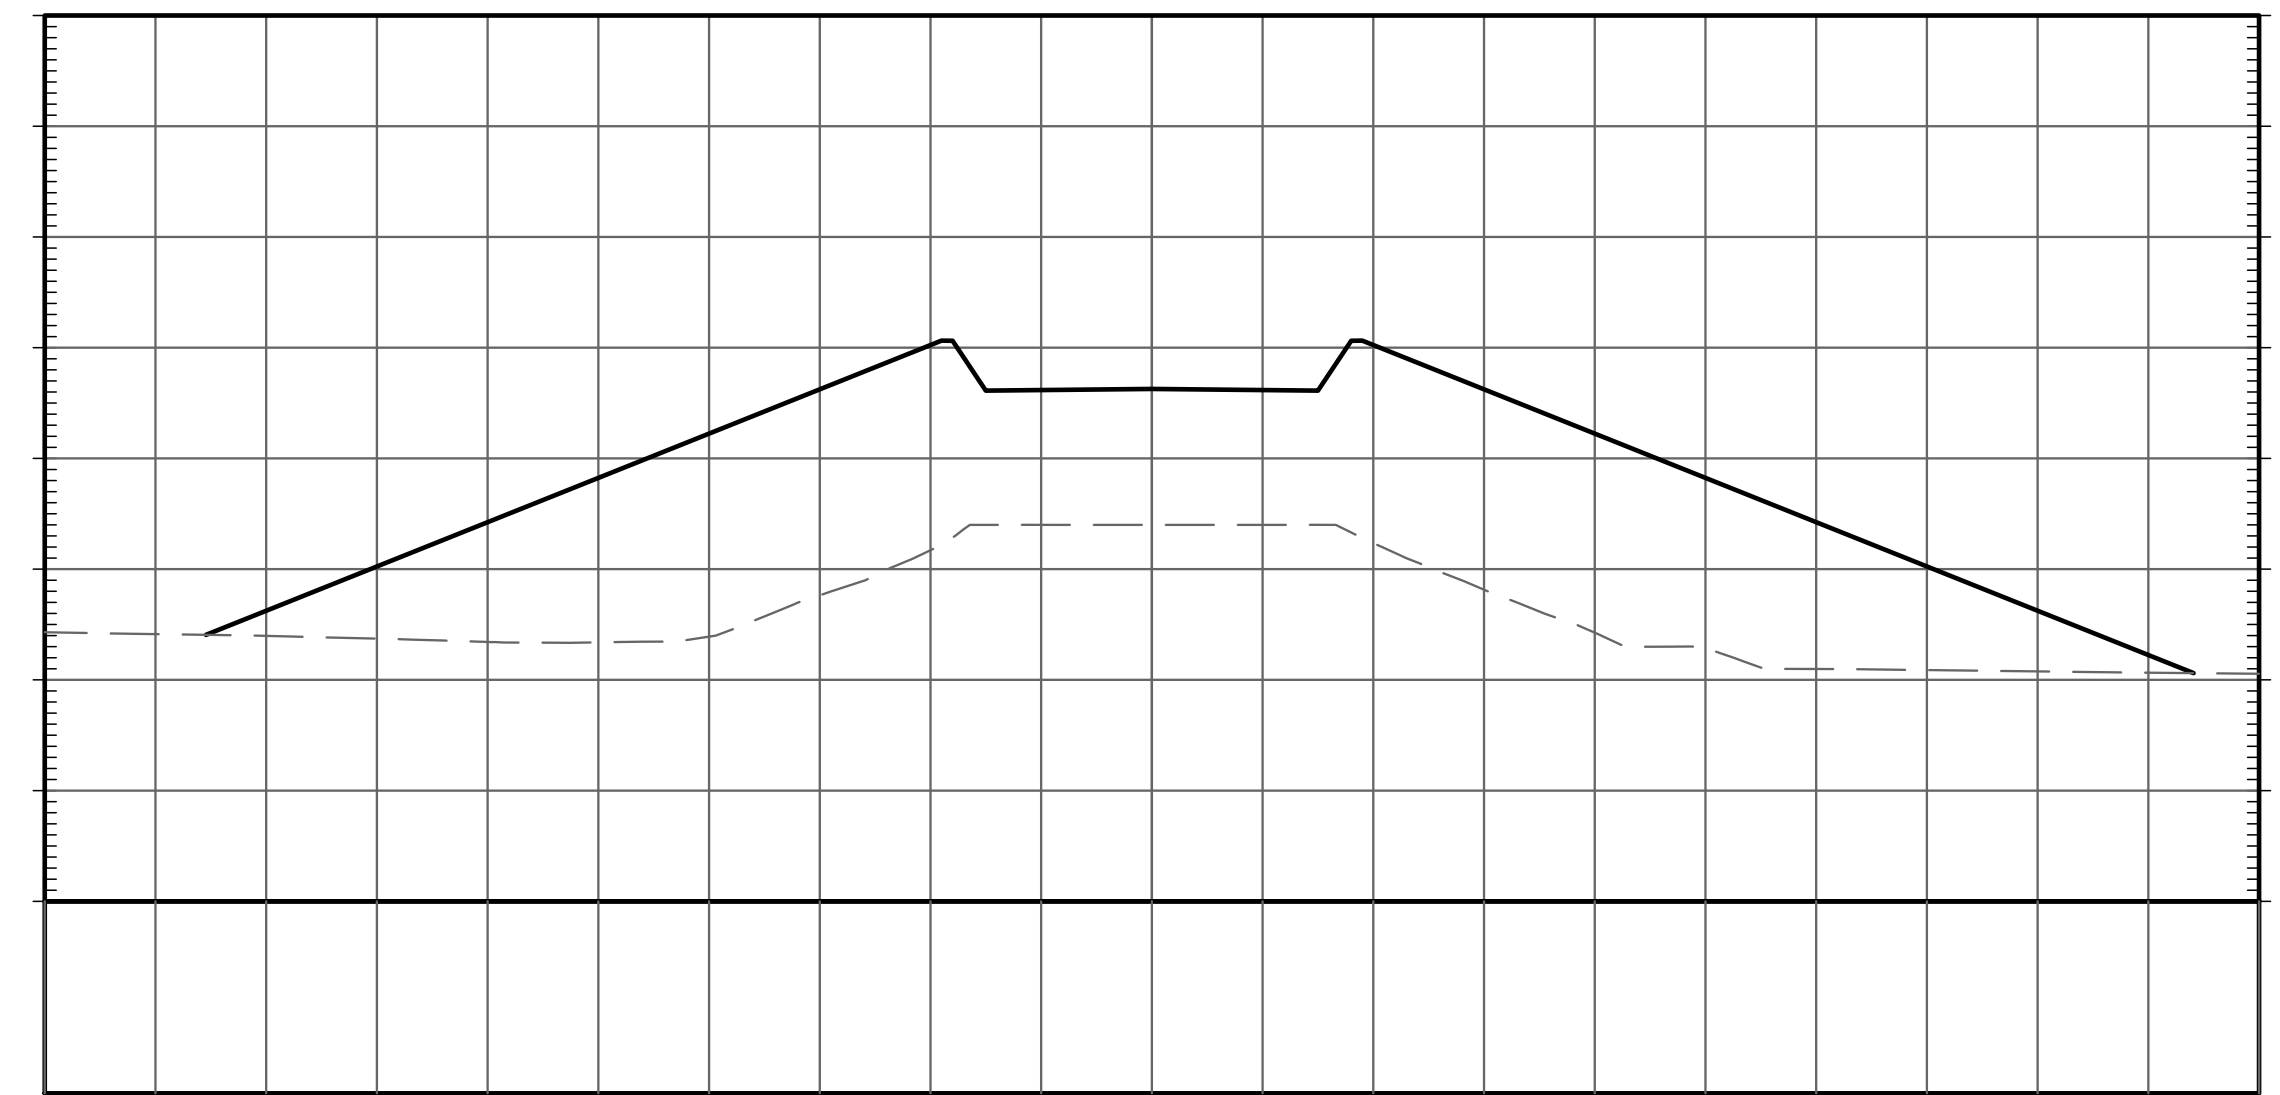
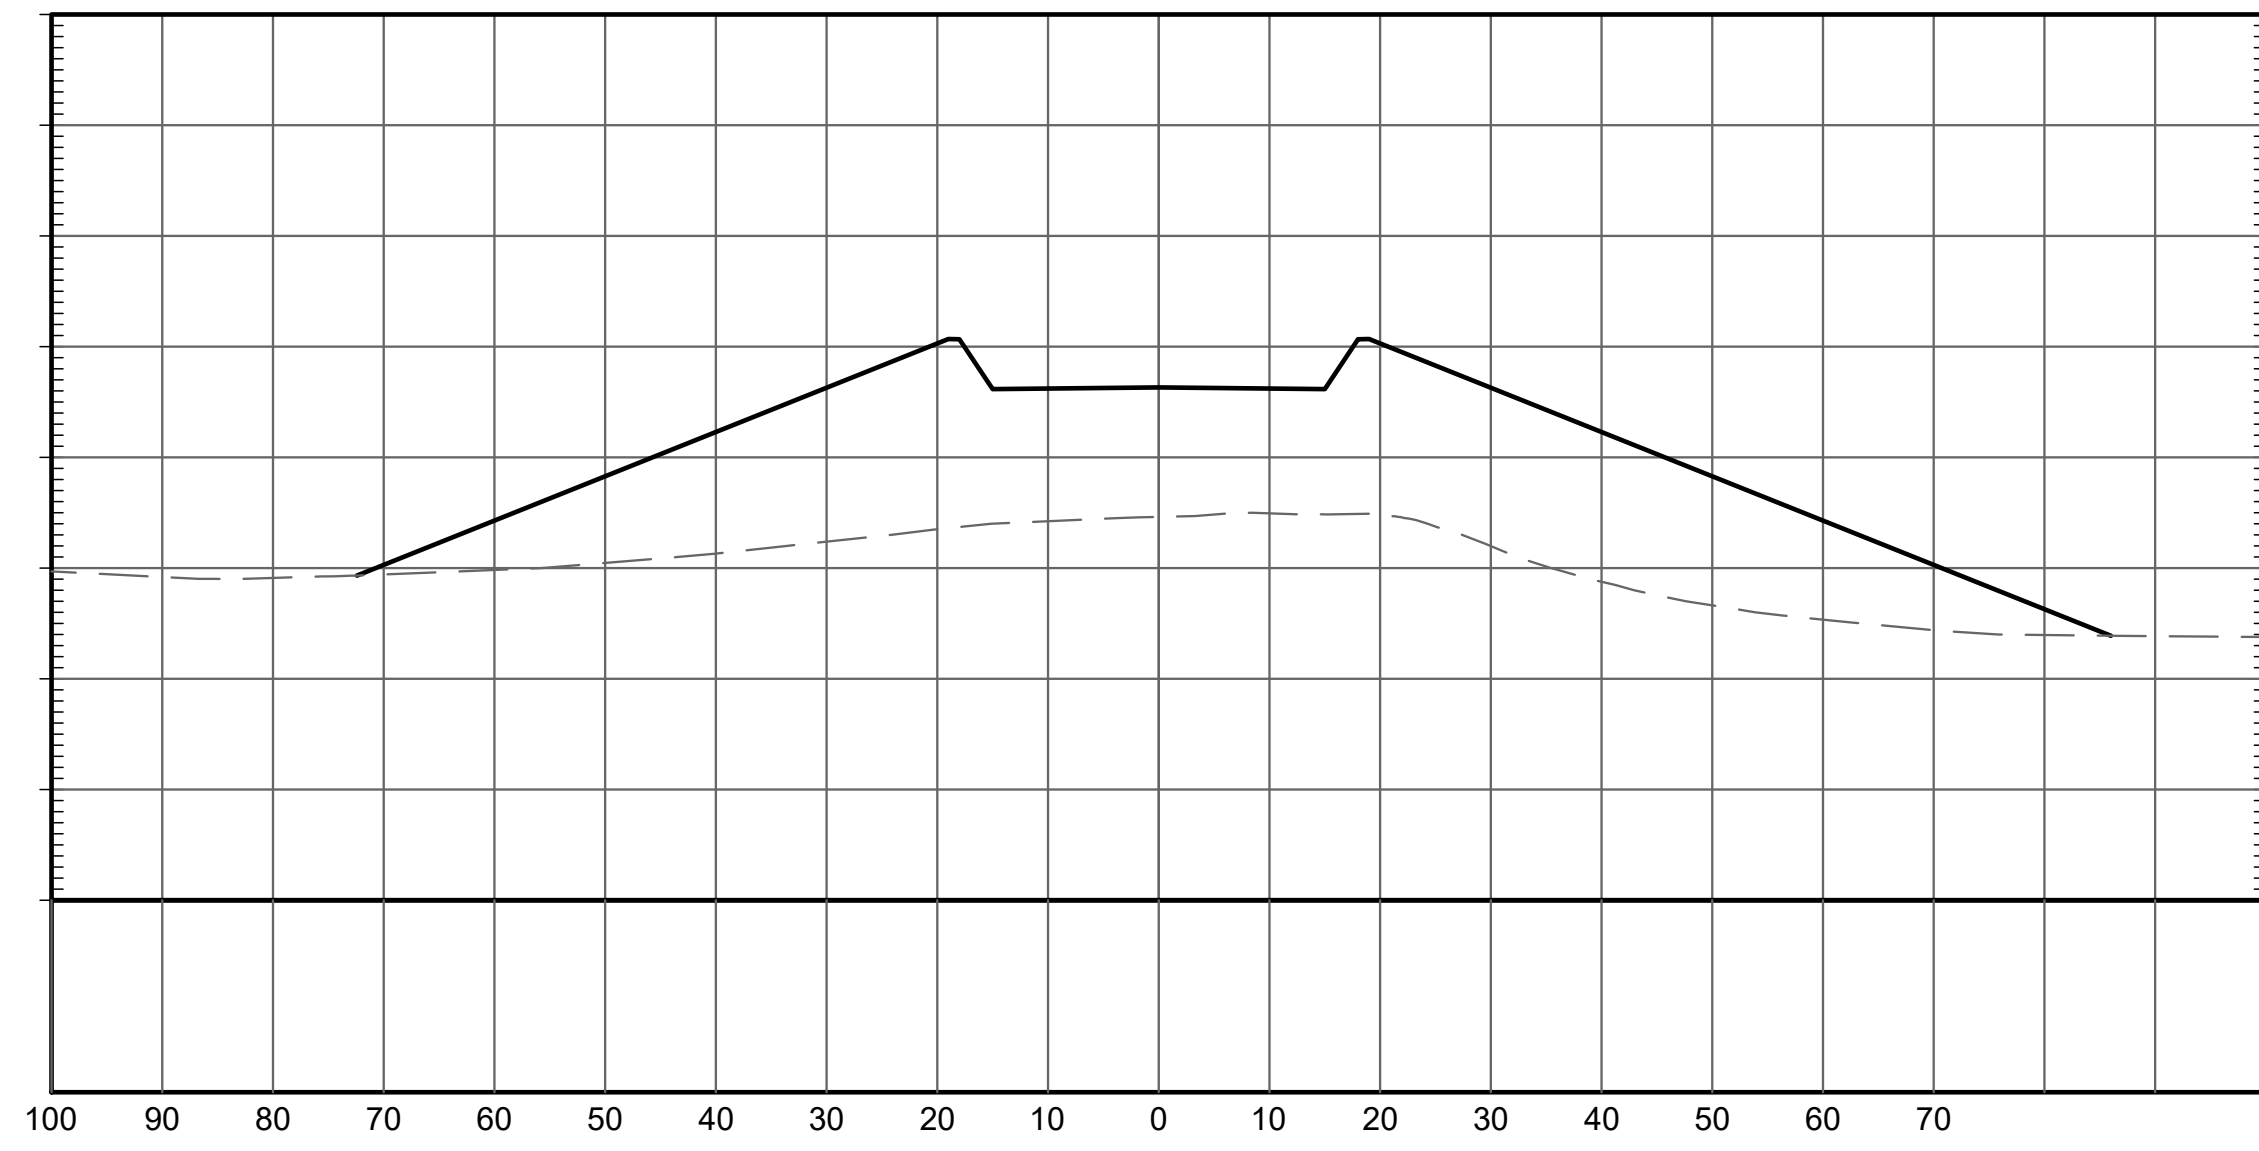


ELEVATIONS ARE REFERENCED TO NORTH AMERICAN VERTICAL DATUM 1988

AERIAL IMAGE FROM PRIOR TO CONSTRUCTION AND IS NOT REPRESENTATIVE OF FINAL PROFILES OR CONDITIONS

<p>Attention:</p> <p>If this scale bar does not measure 1" then drawing is not original scale.</p>	Designed: BJB
	Drawn: BJB
	Checked: JPB
	Approved: JPB
	P.E. No: 40594
GEI Project 2300038	



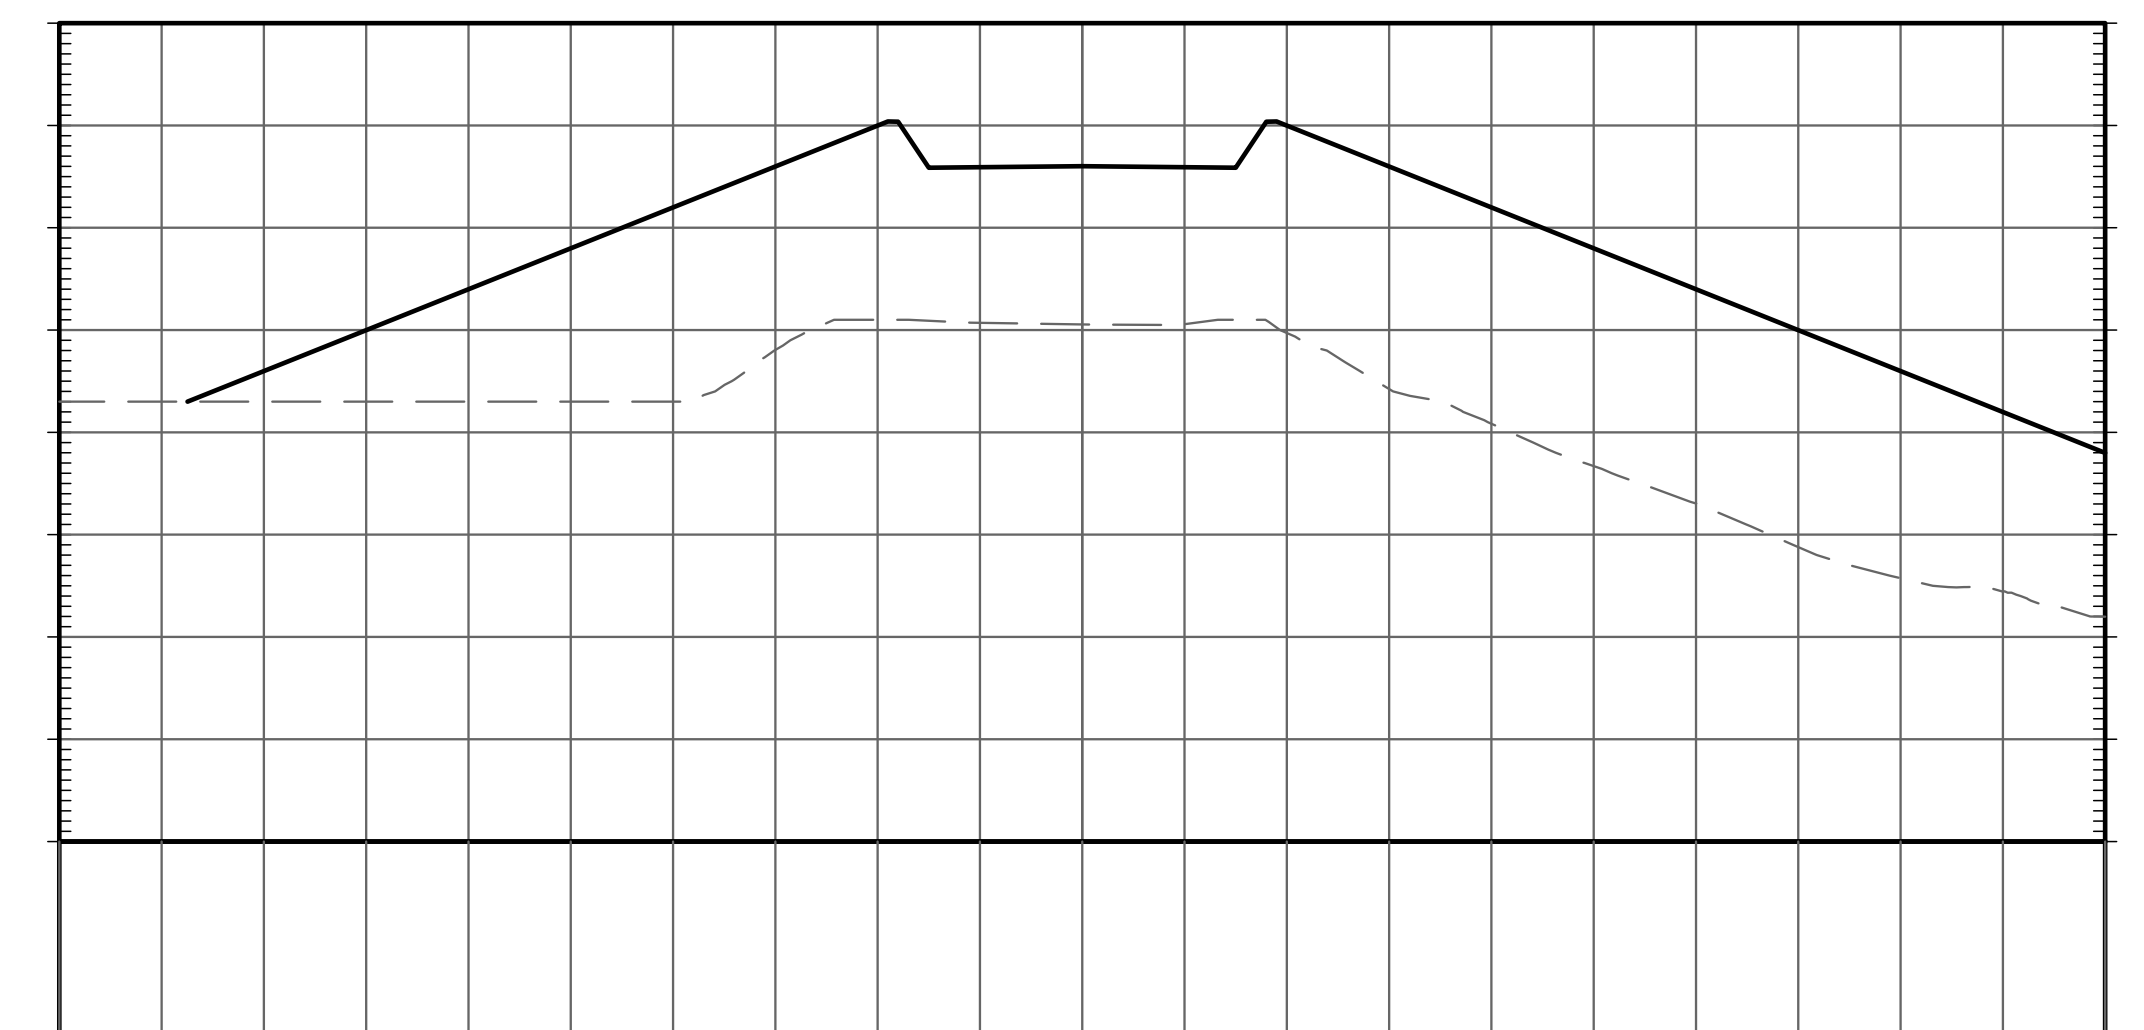
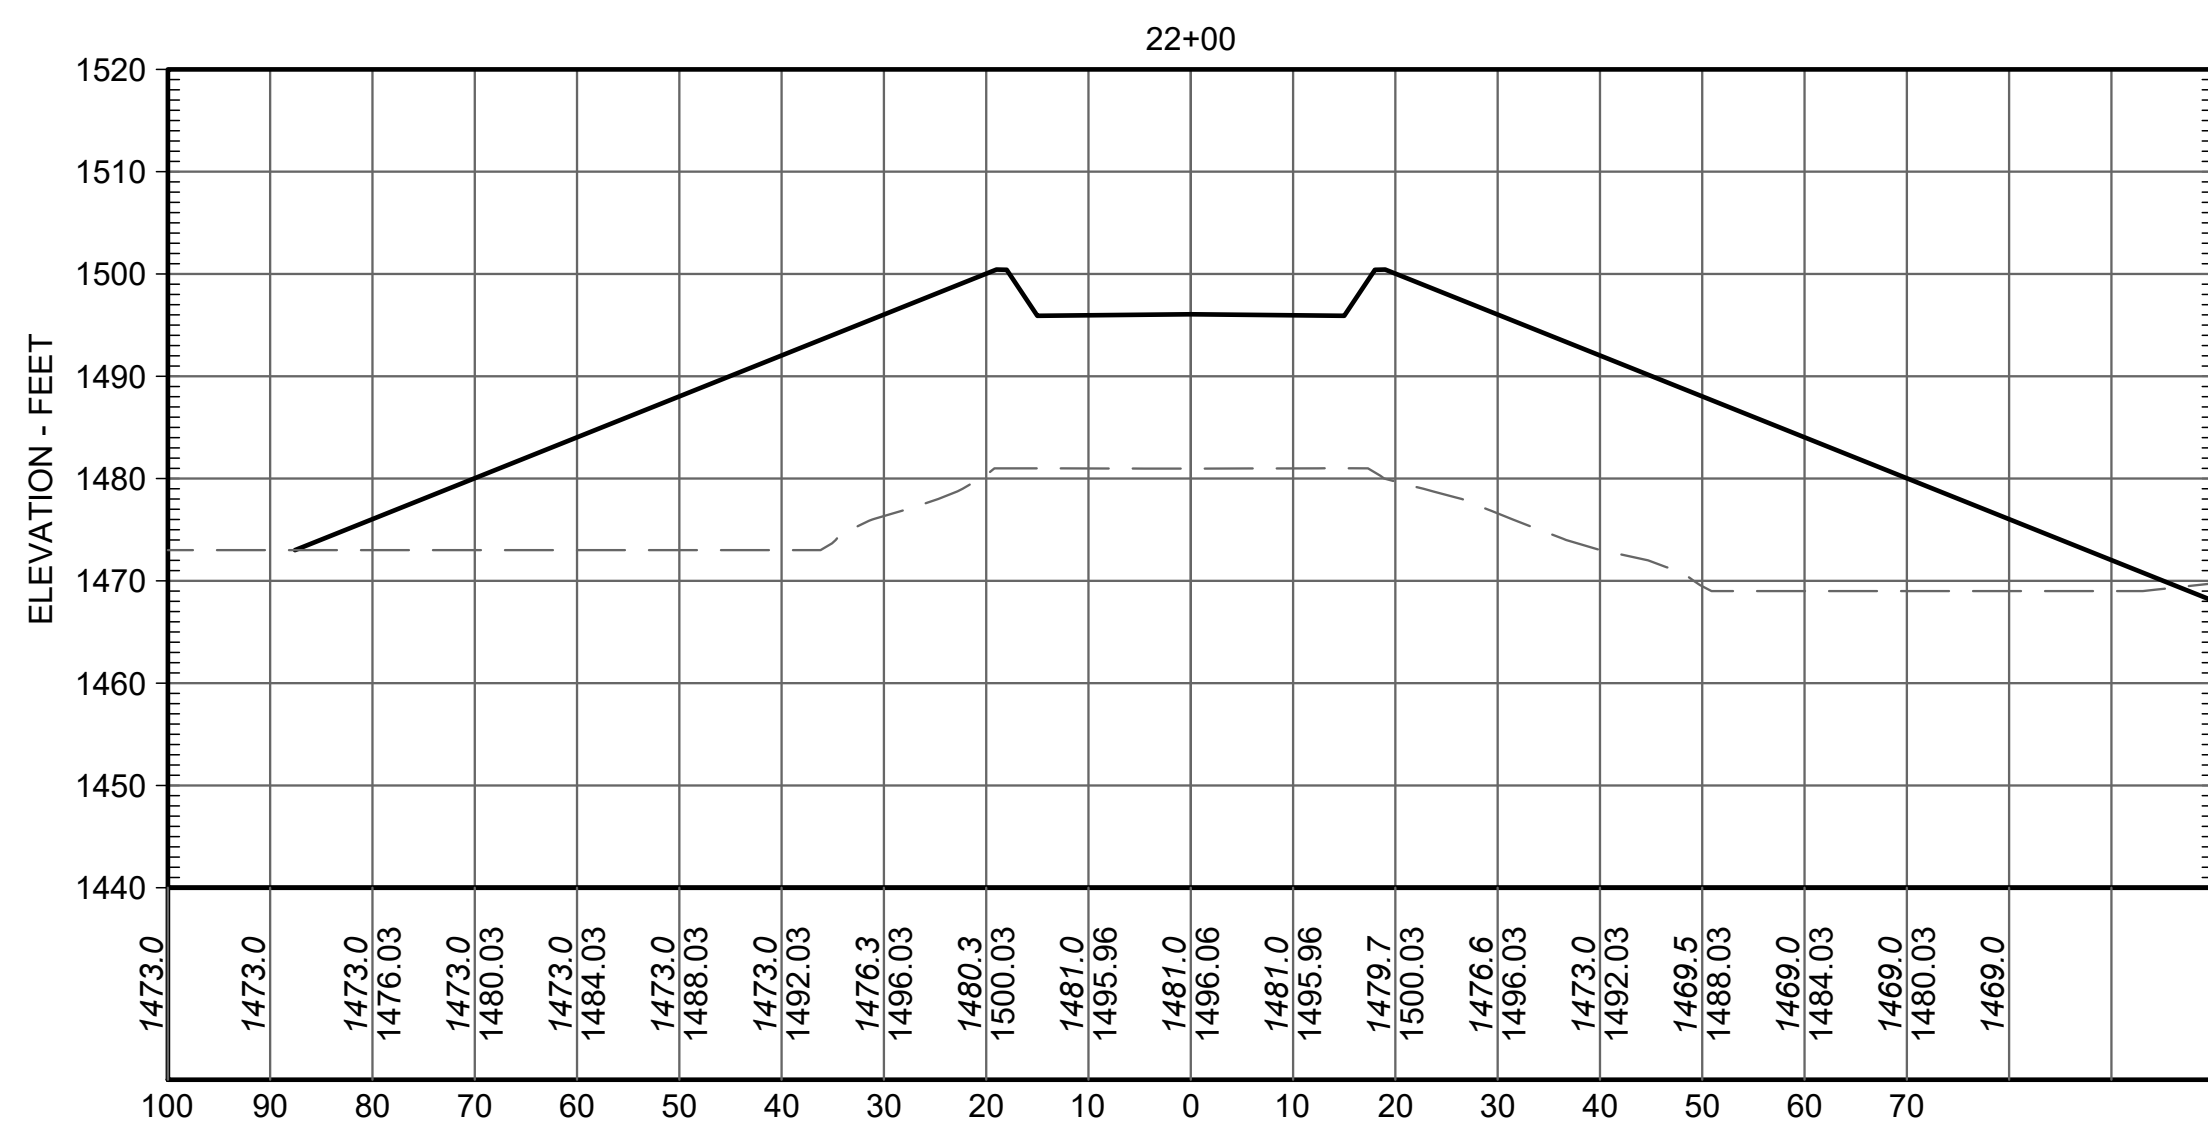
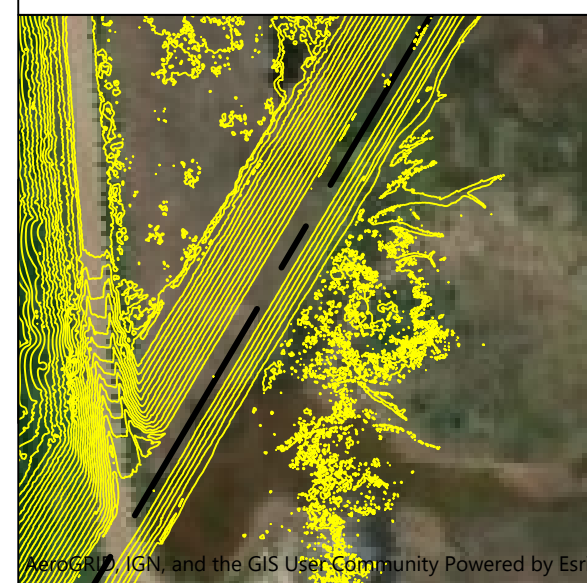
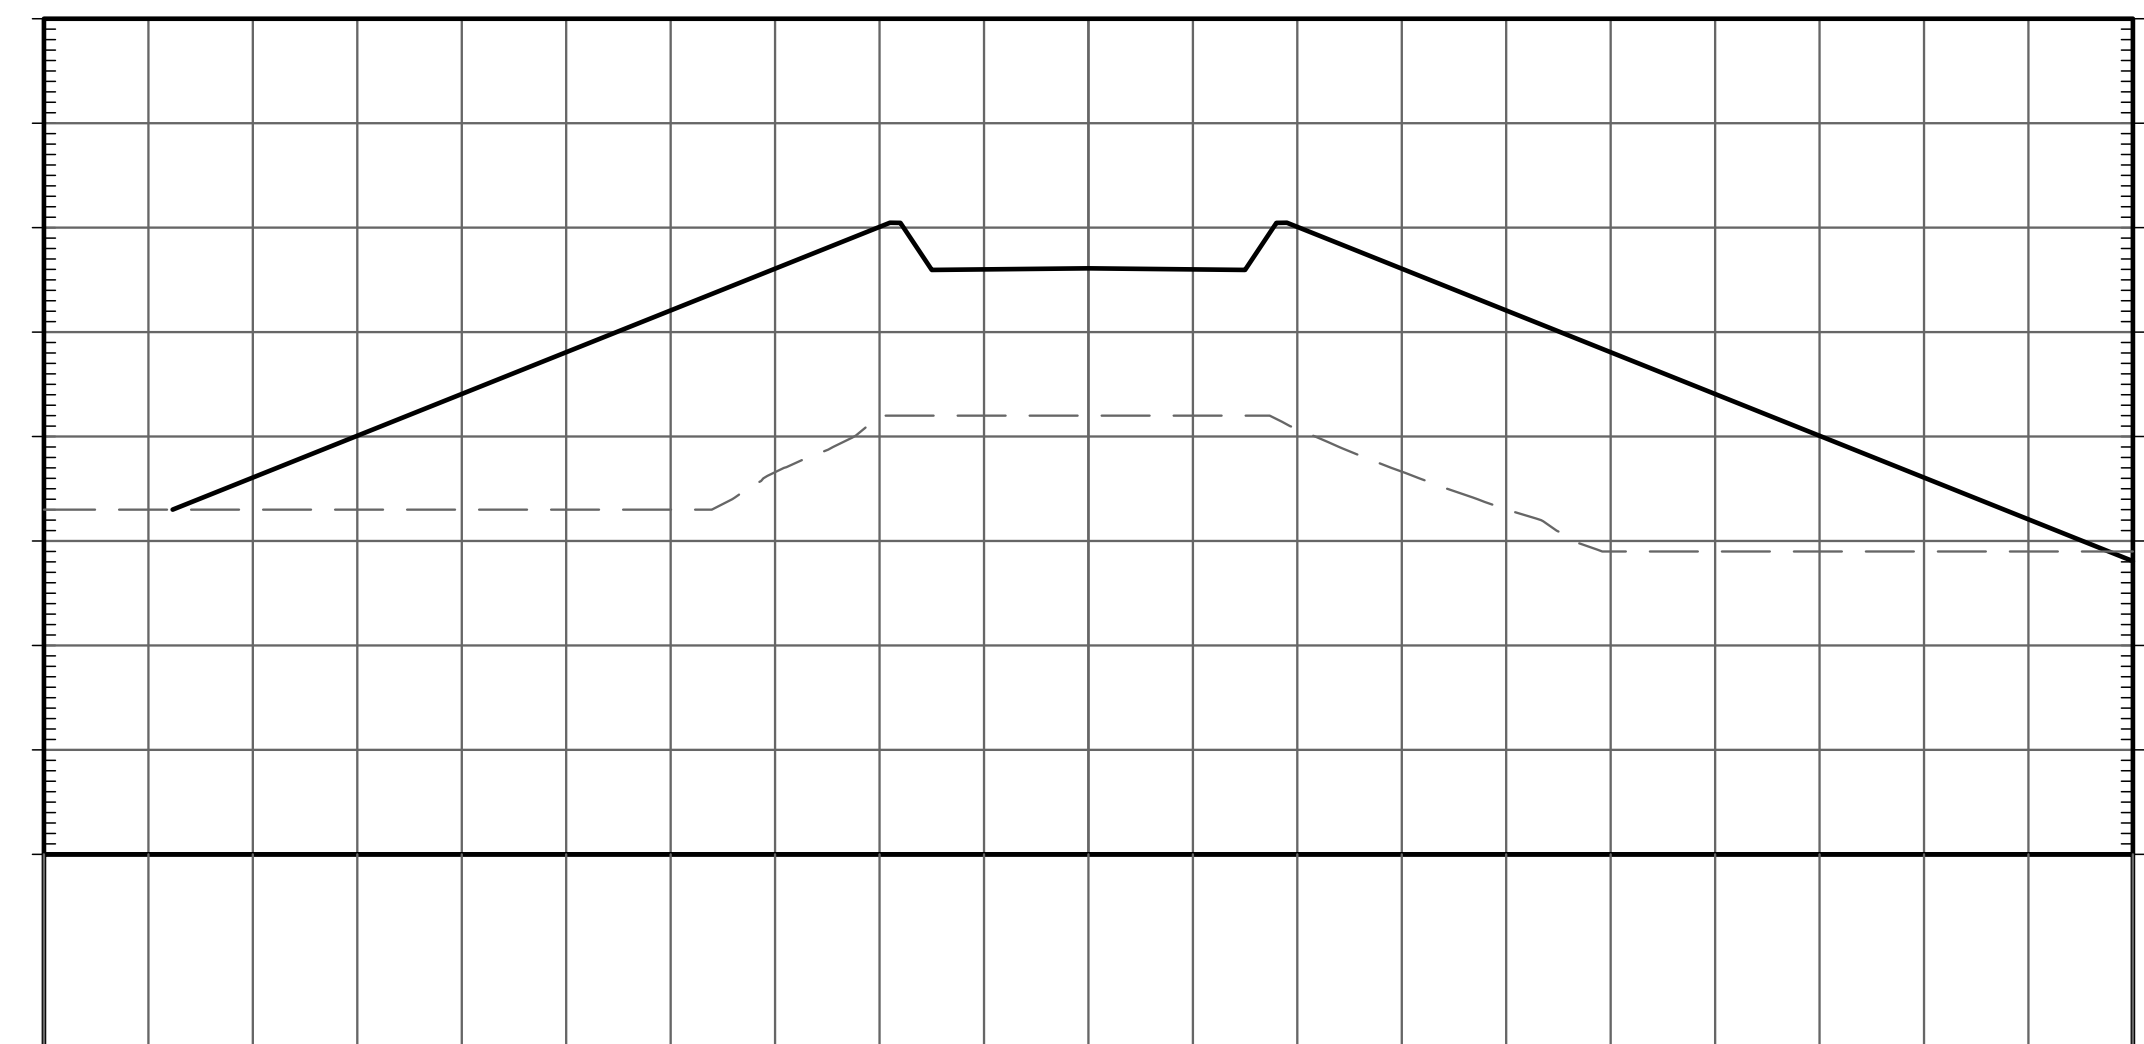
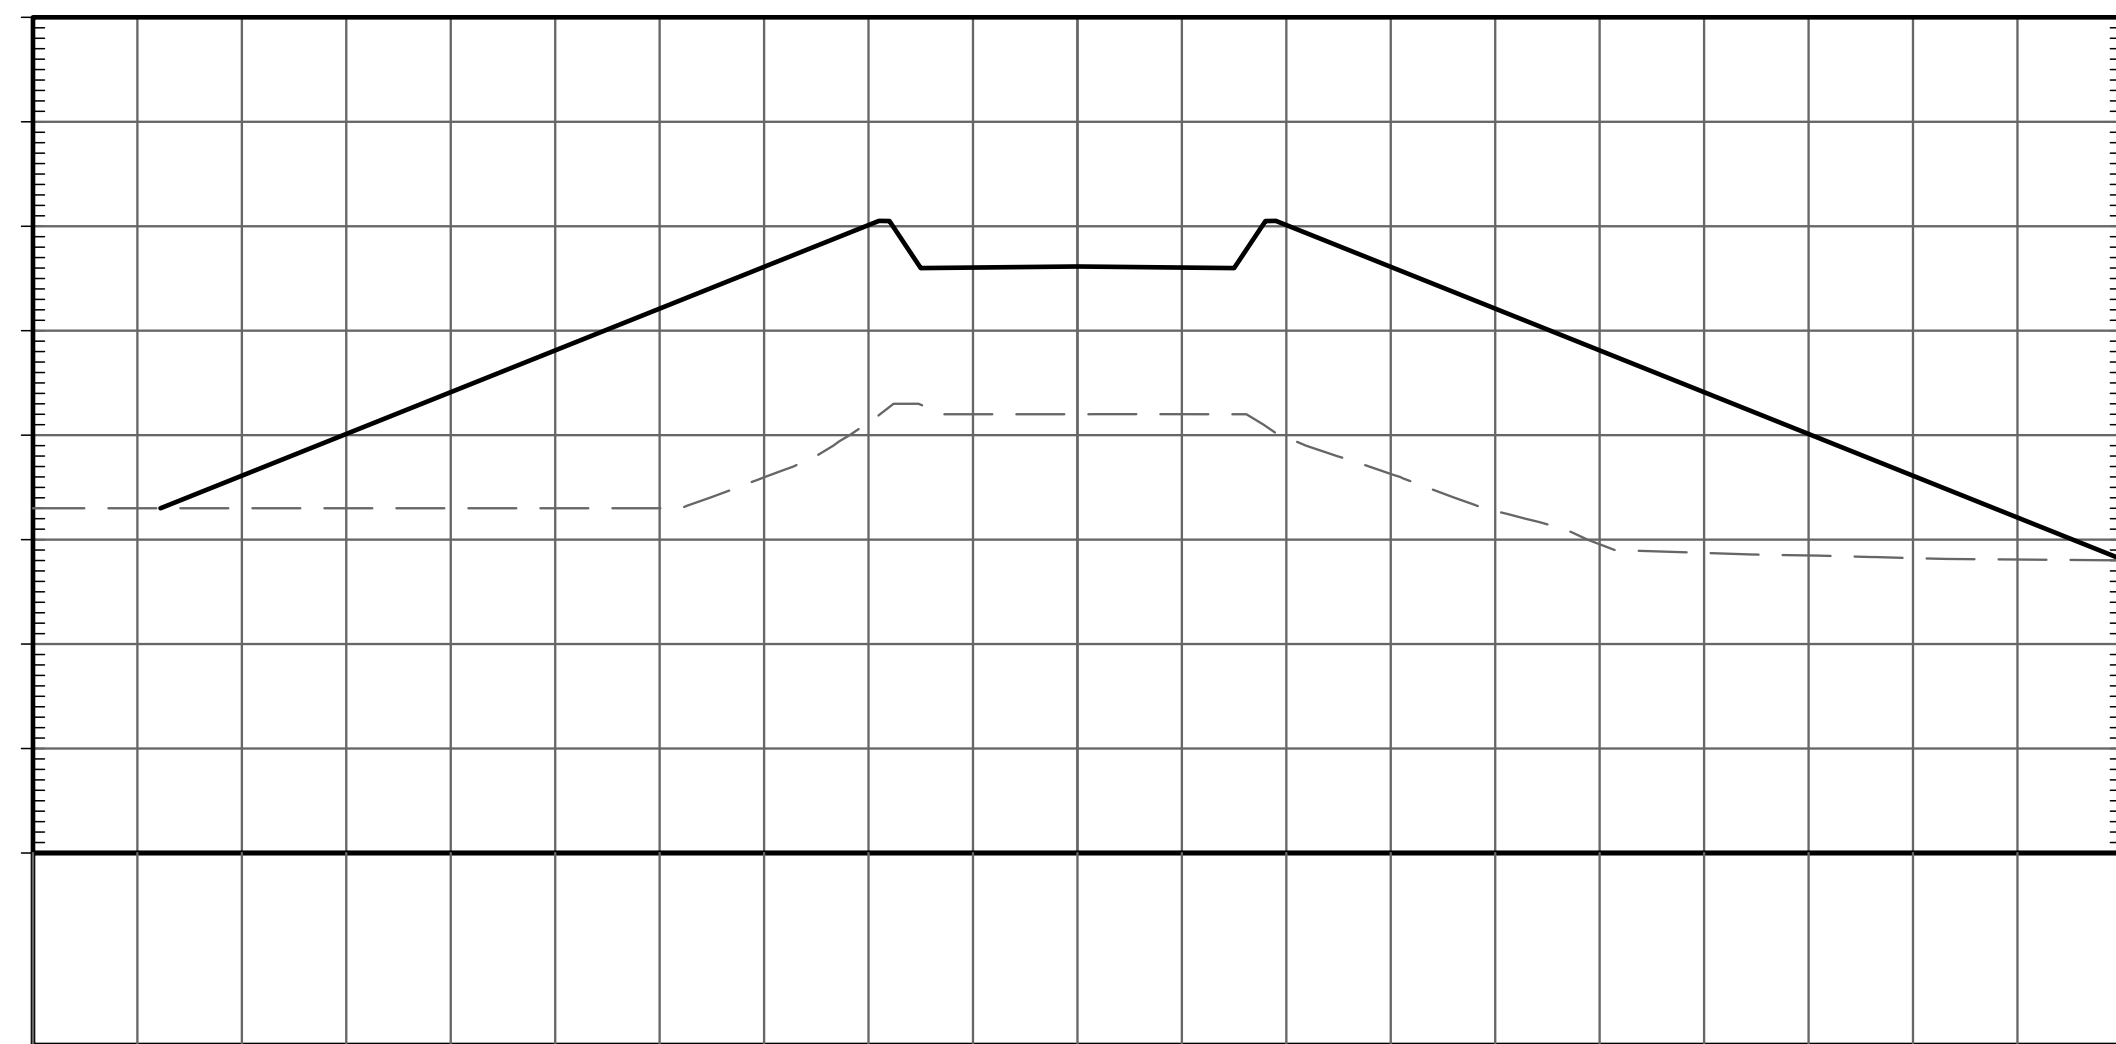


ELEVATIONS ARE REFERENCED TO NORTH AMERICAN VERTICAL DATUM 1988

AERIAL IMAGE FROM PRIOR TO CONSTRUCTION AND IS NOT REPRESENTATIVE OF FINAL PROFILES OR CONDITIONS

<p>Attention:</p> <p>If this scale bar does not measure 1" then drawing is not original scale.</p>	Designed: BJB
	Drawn: BJB
	Checked: JPB
	Approved: JPB
	P.E. No: 40594
GEI Project 2300038	



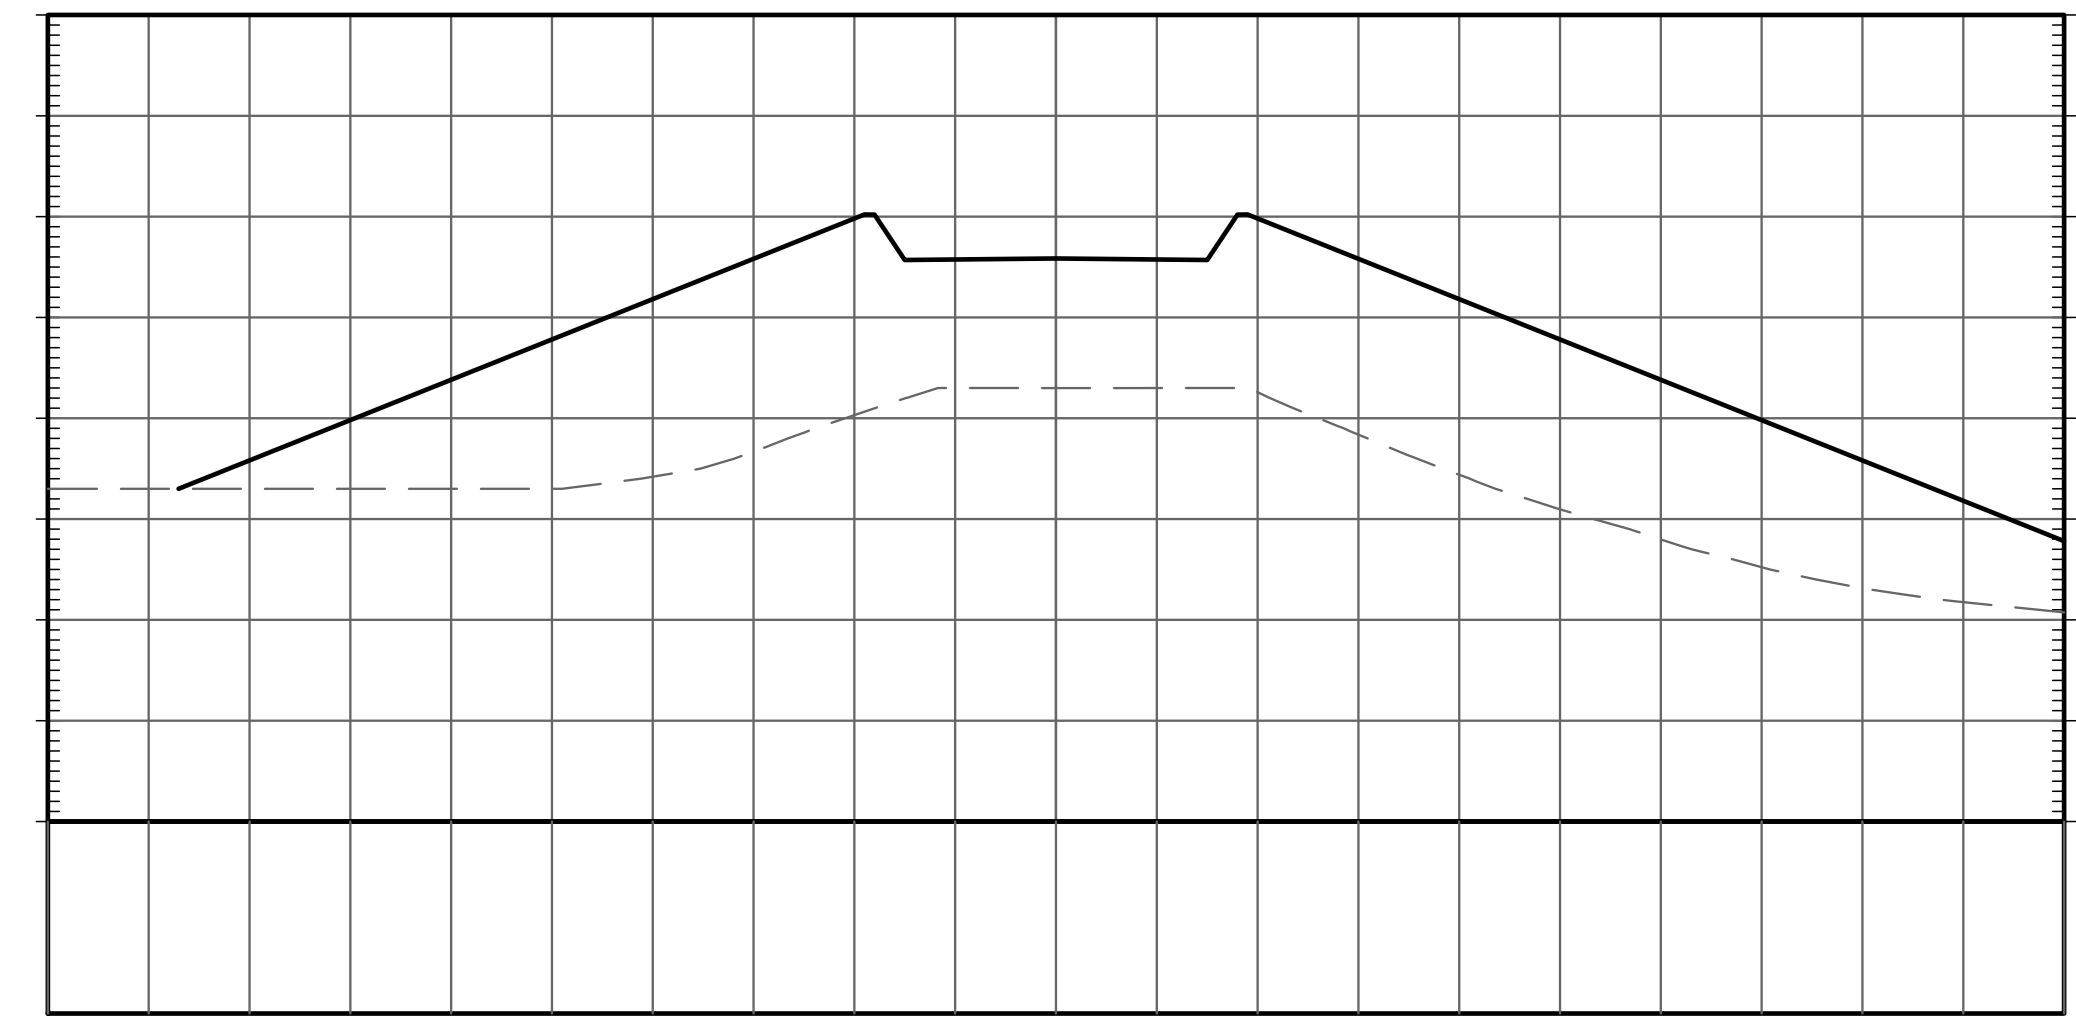
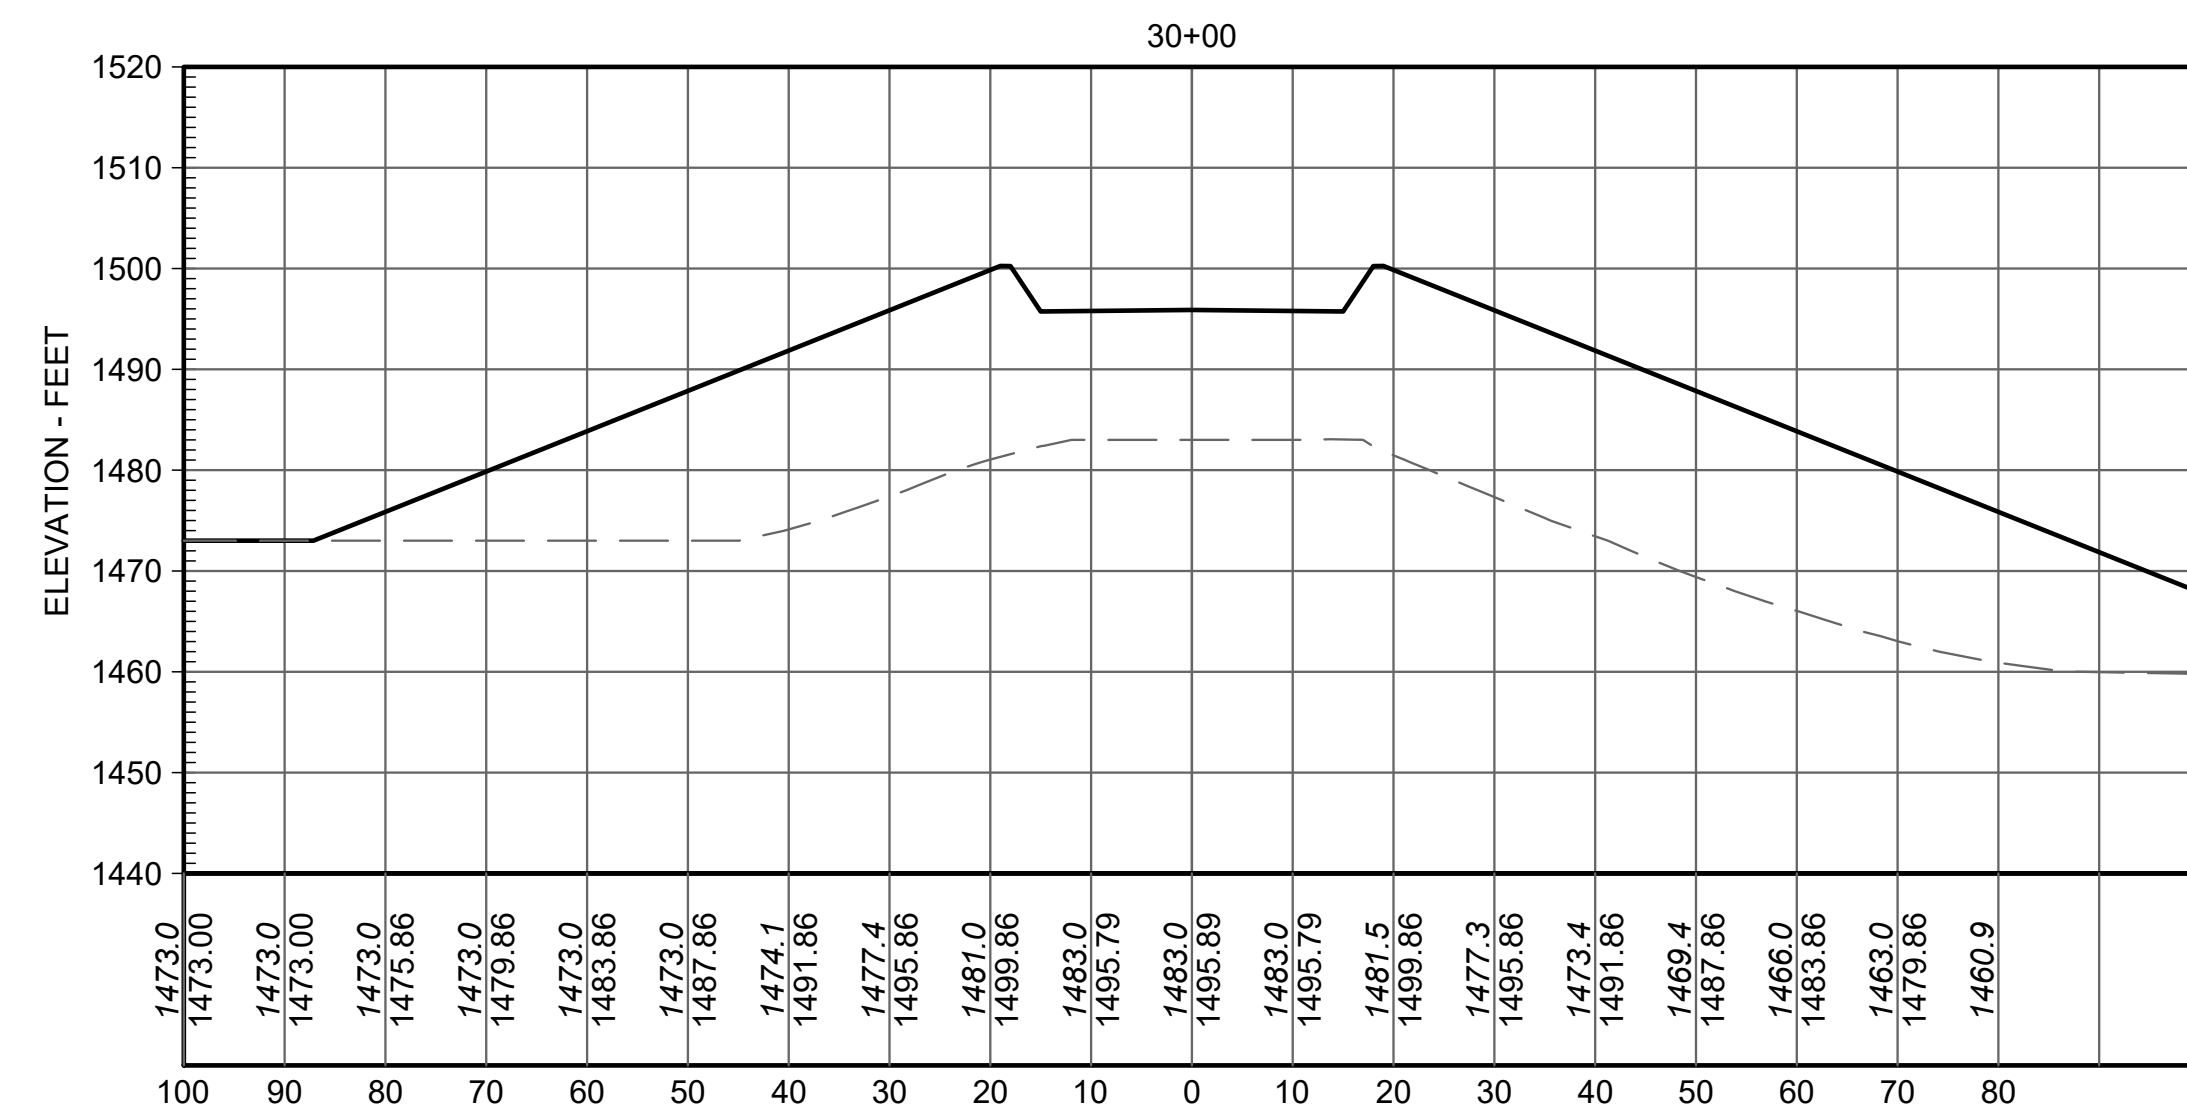
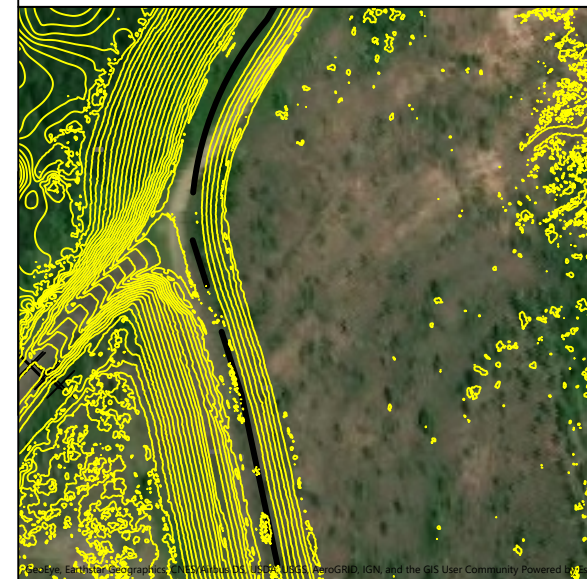
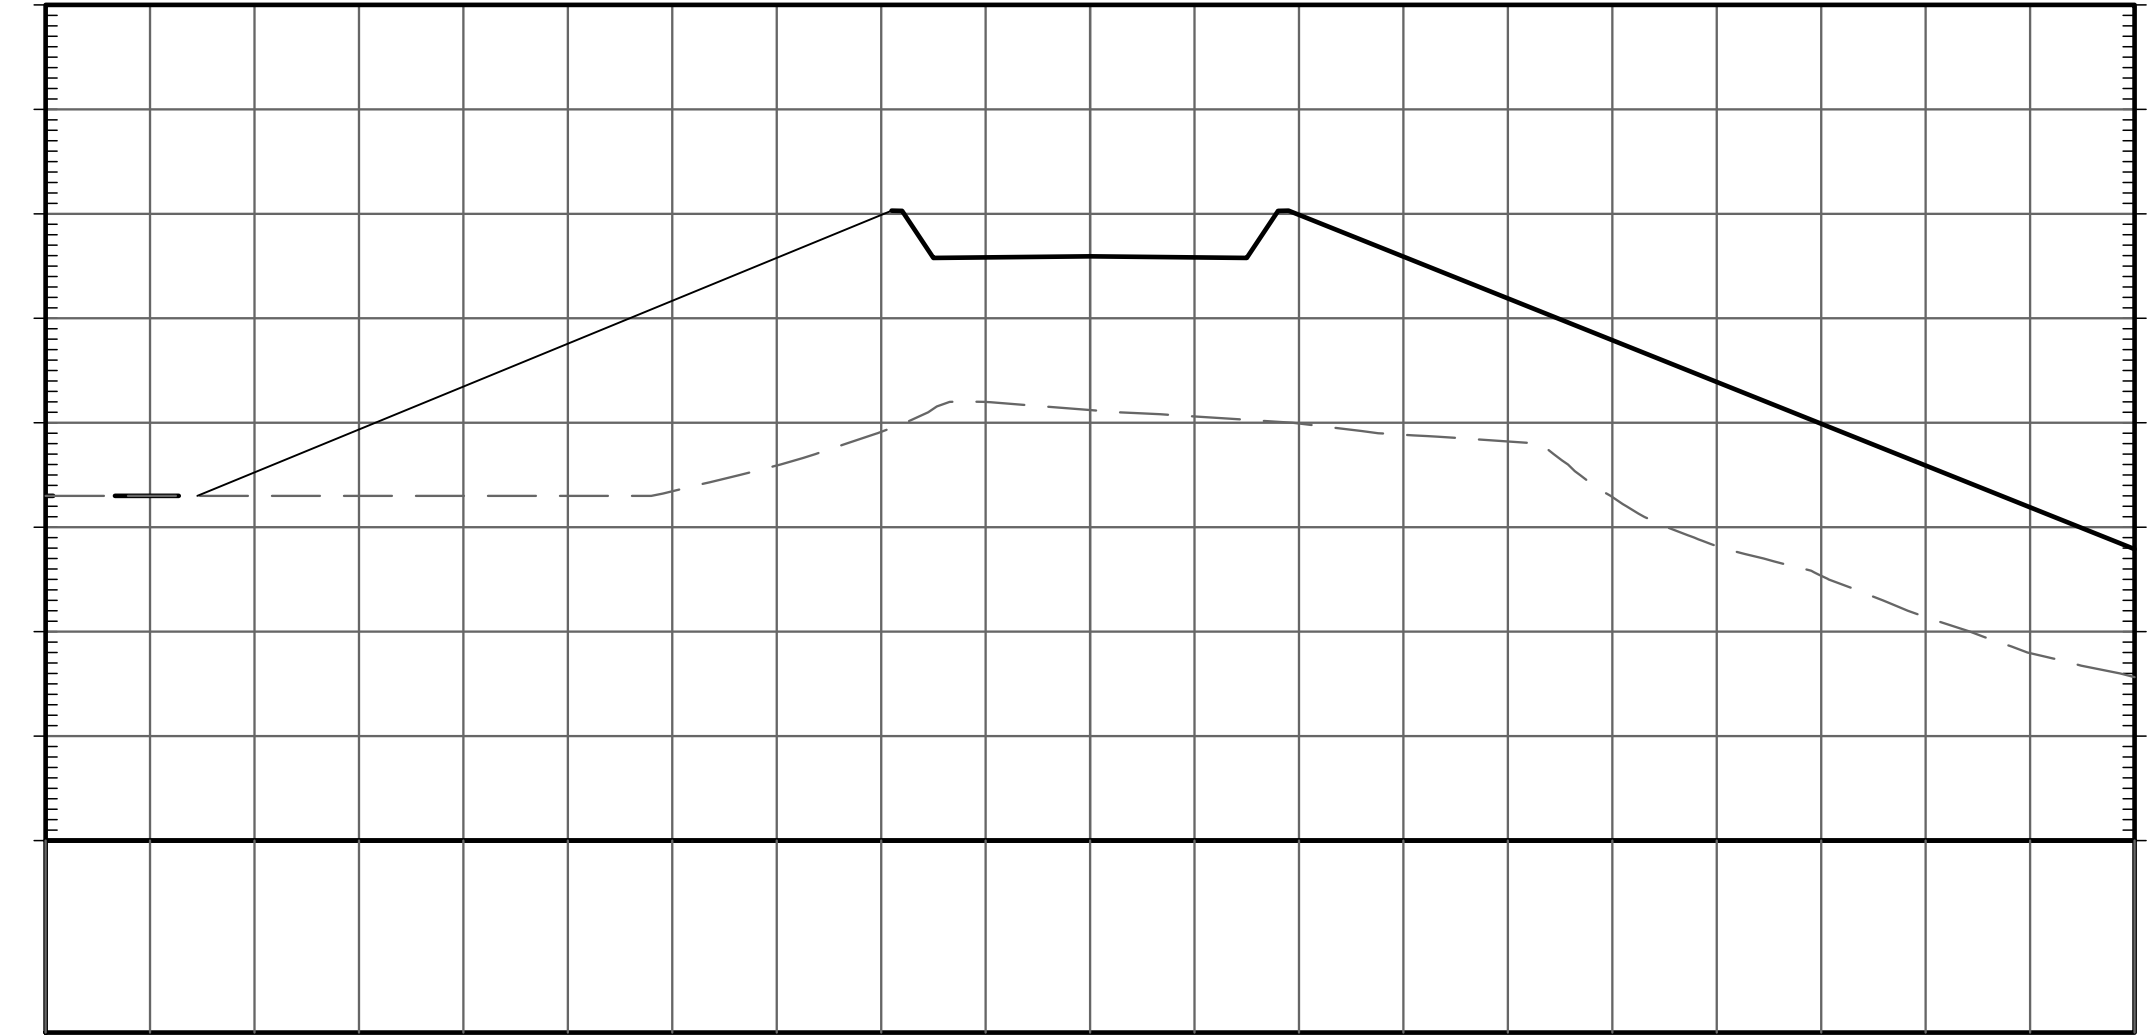
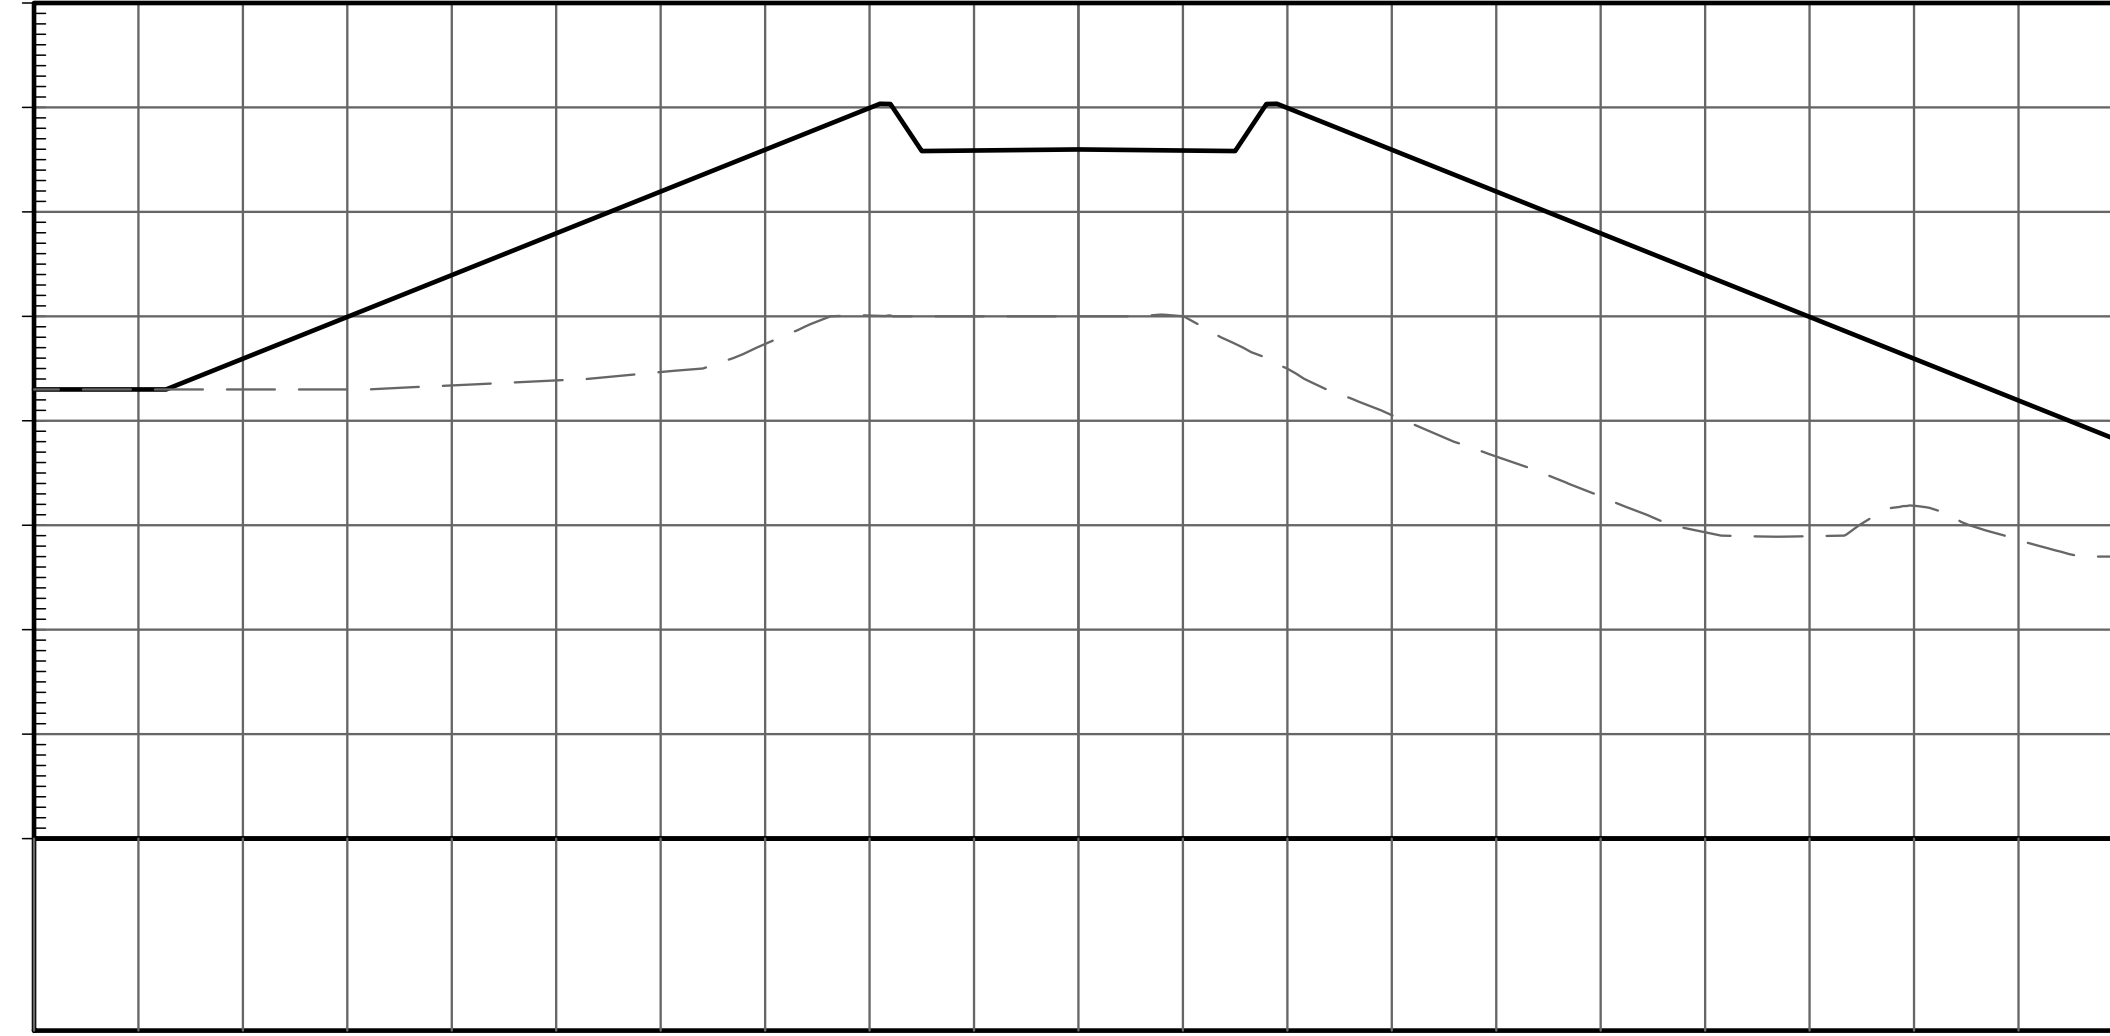


ELEVATIONS ARE REFERENCED TO NORTH AMERICAN VERTICAL DATUM 1988

AERIAL IMAGE FROM PRIOR TO CONSTRUCTION AND IS NOT REPRESENTATIVE OF FINAL PROFILES OR CONDITIONS

<p>Attention:</p> <p>If this scale bar does not measure 1" then drawing is not original scale.</p>	Designed: BJB
	Drawn: BJB
	Checked: JPB
	Approved: JPB
	P.E. No: 40594
GEI Project 2300038	



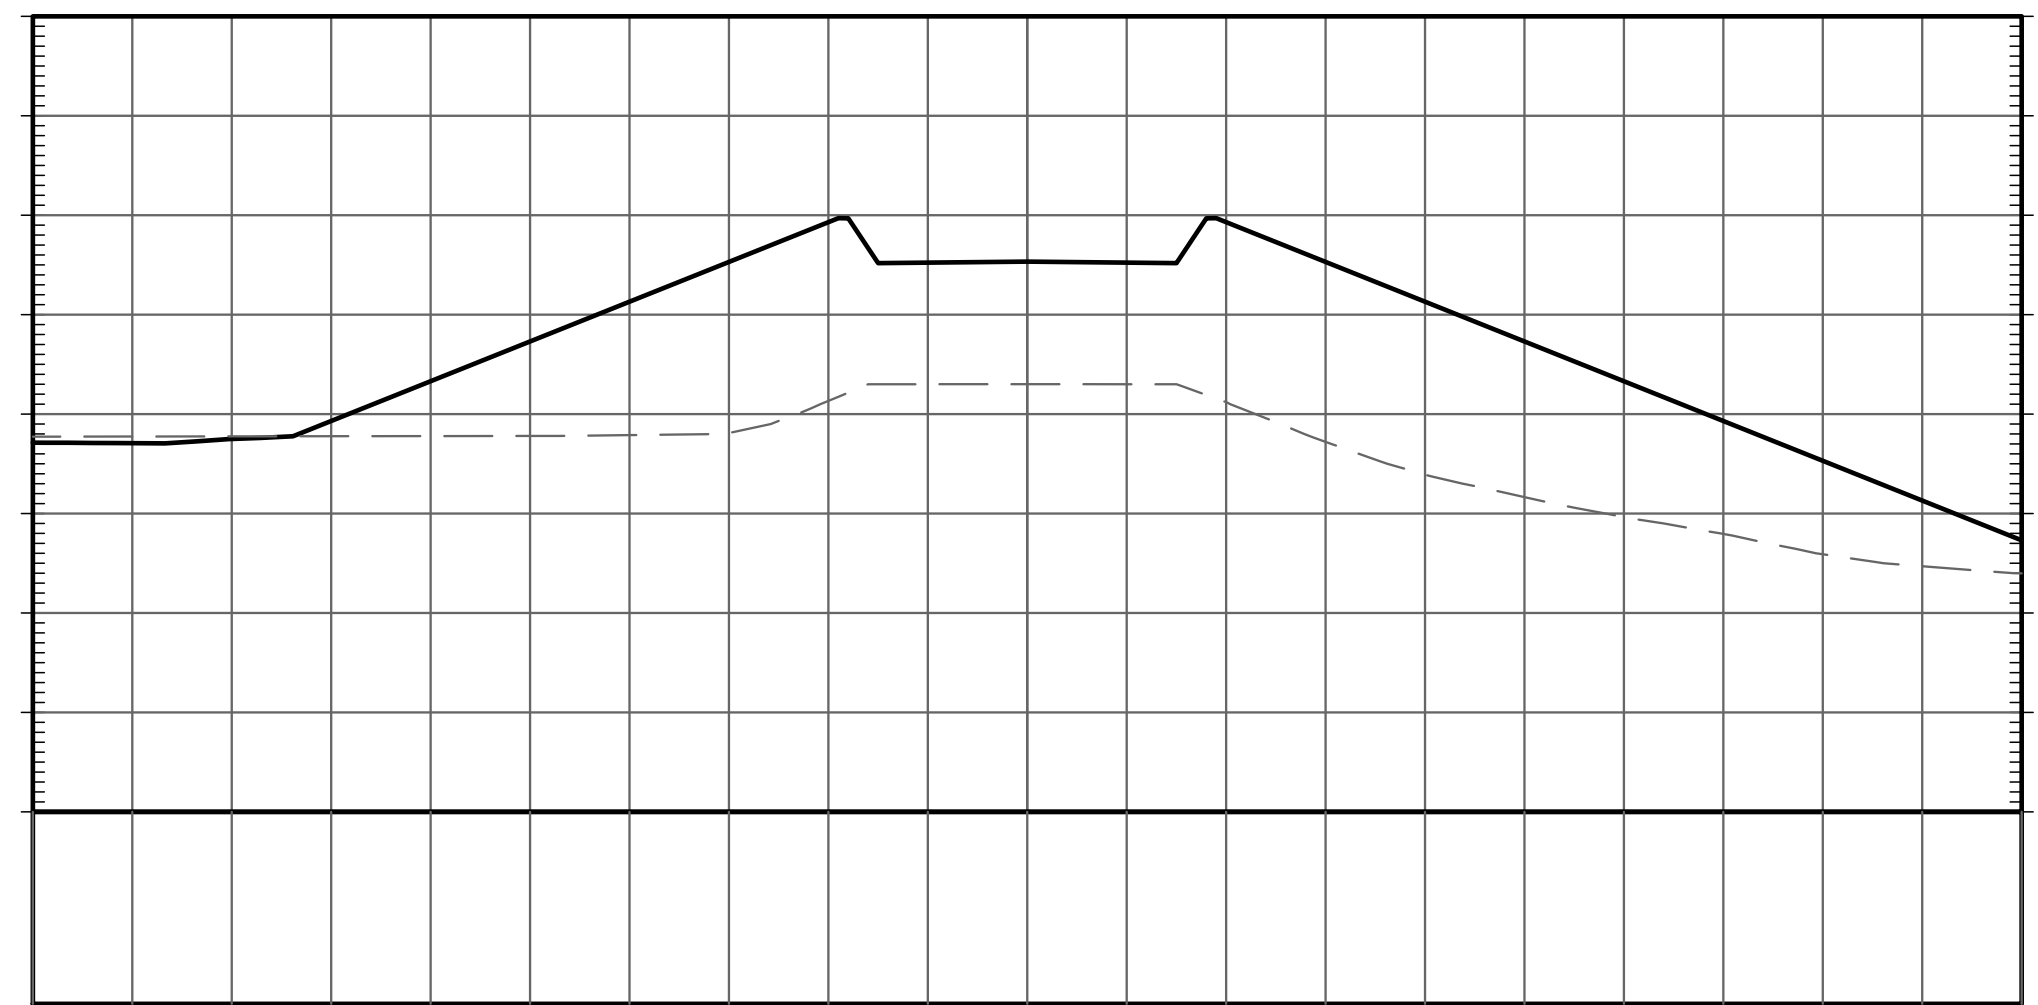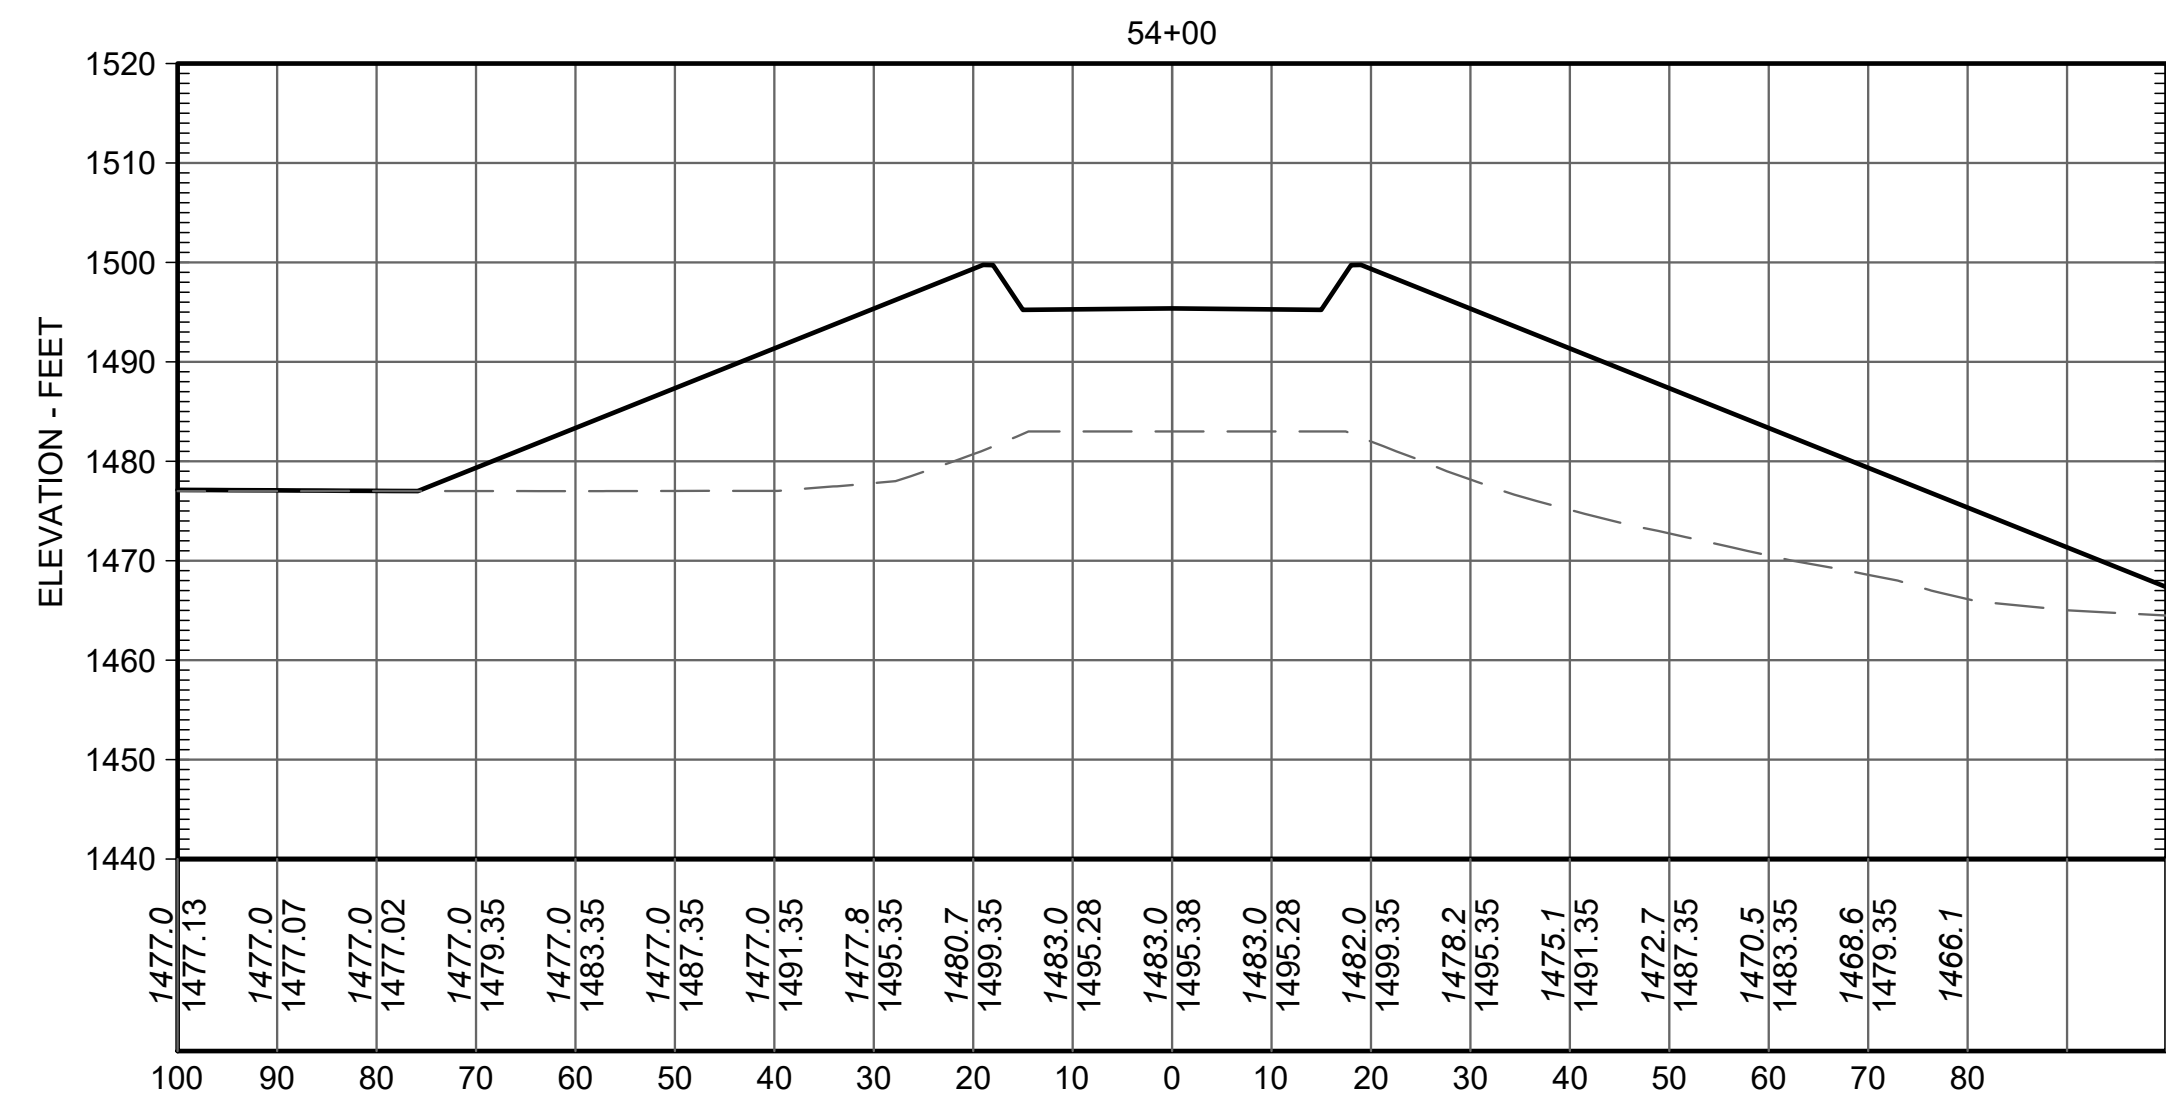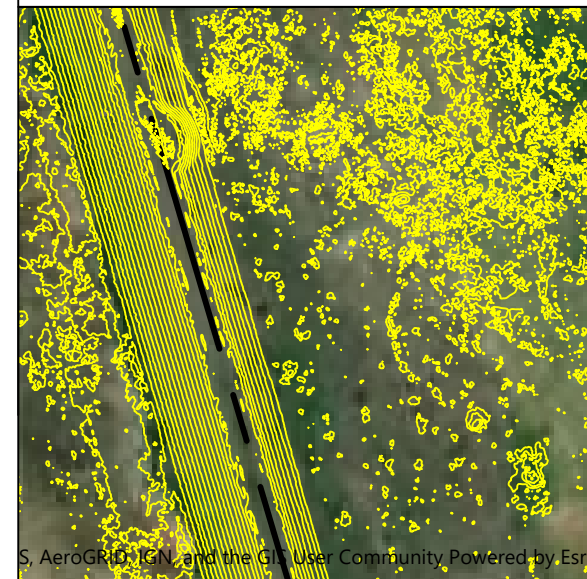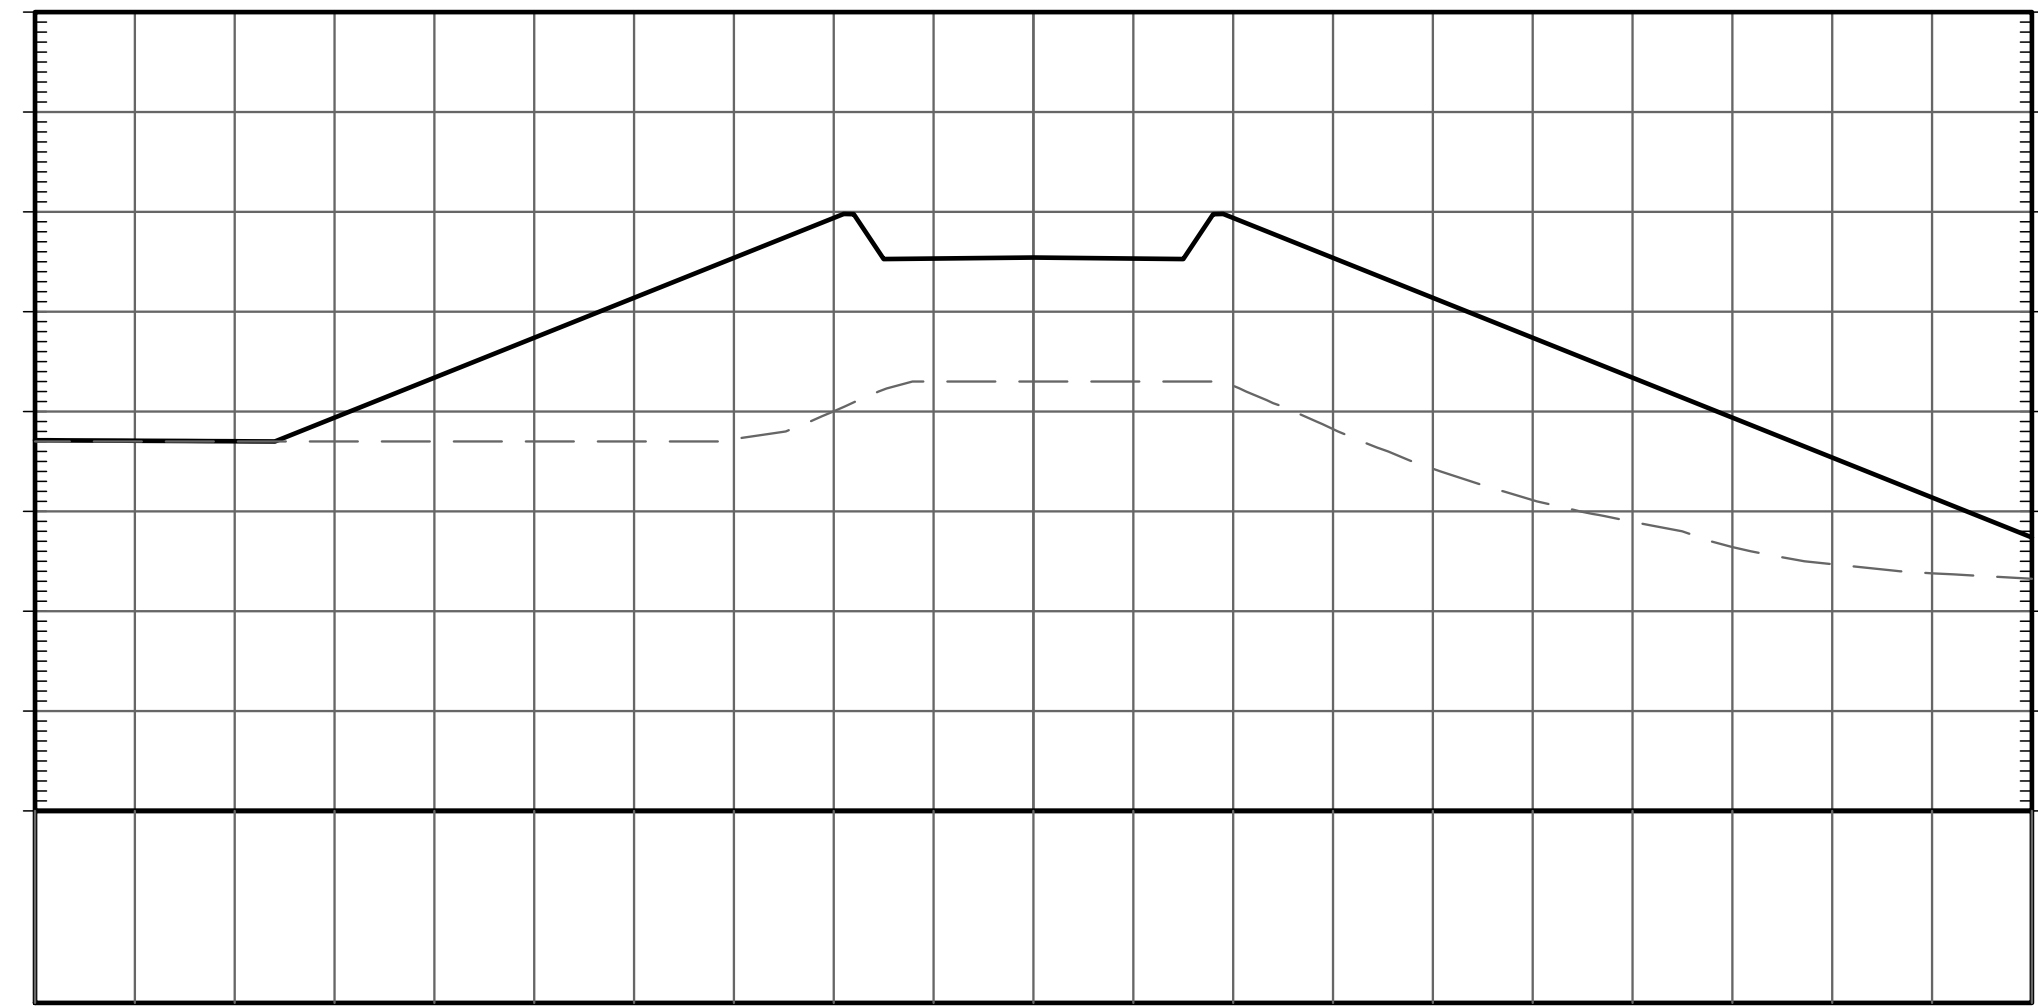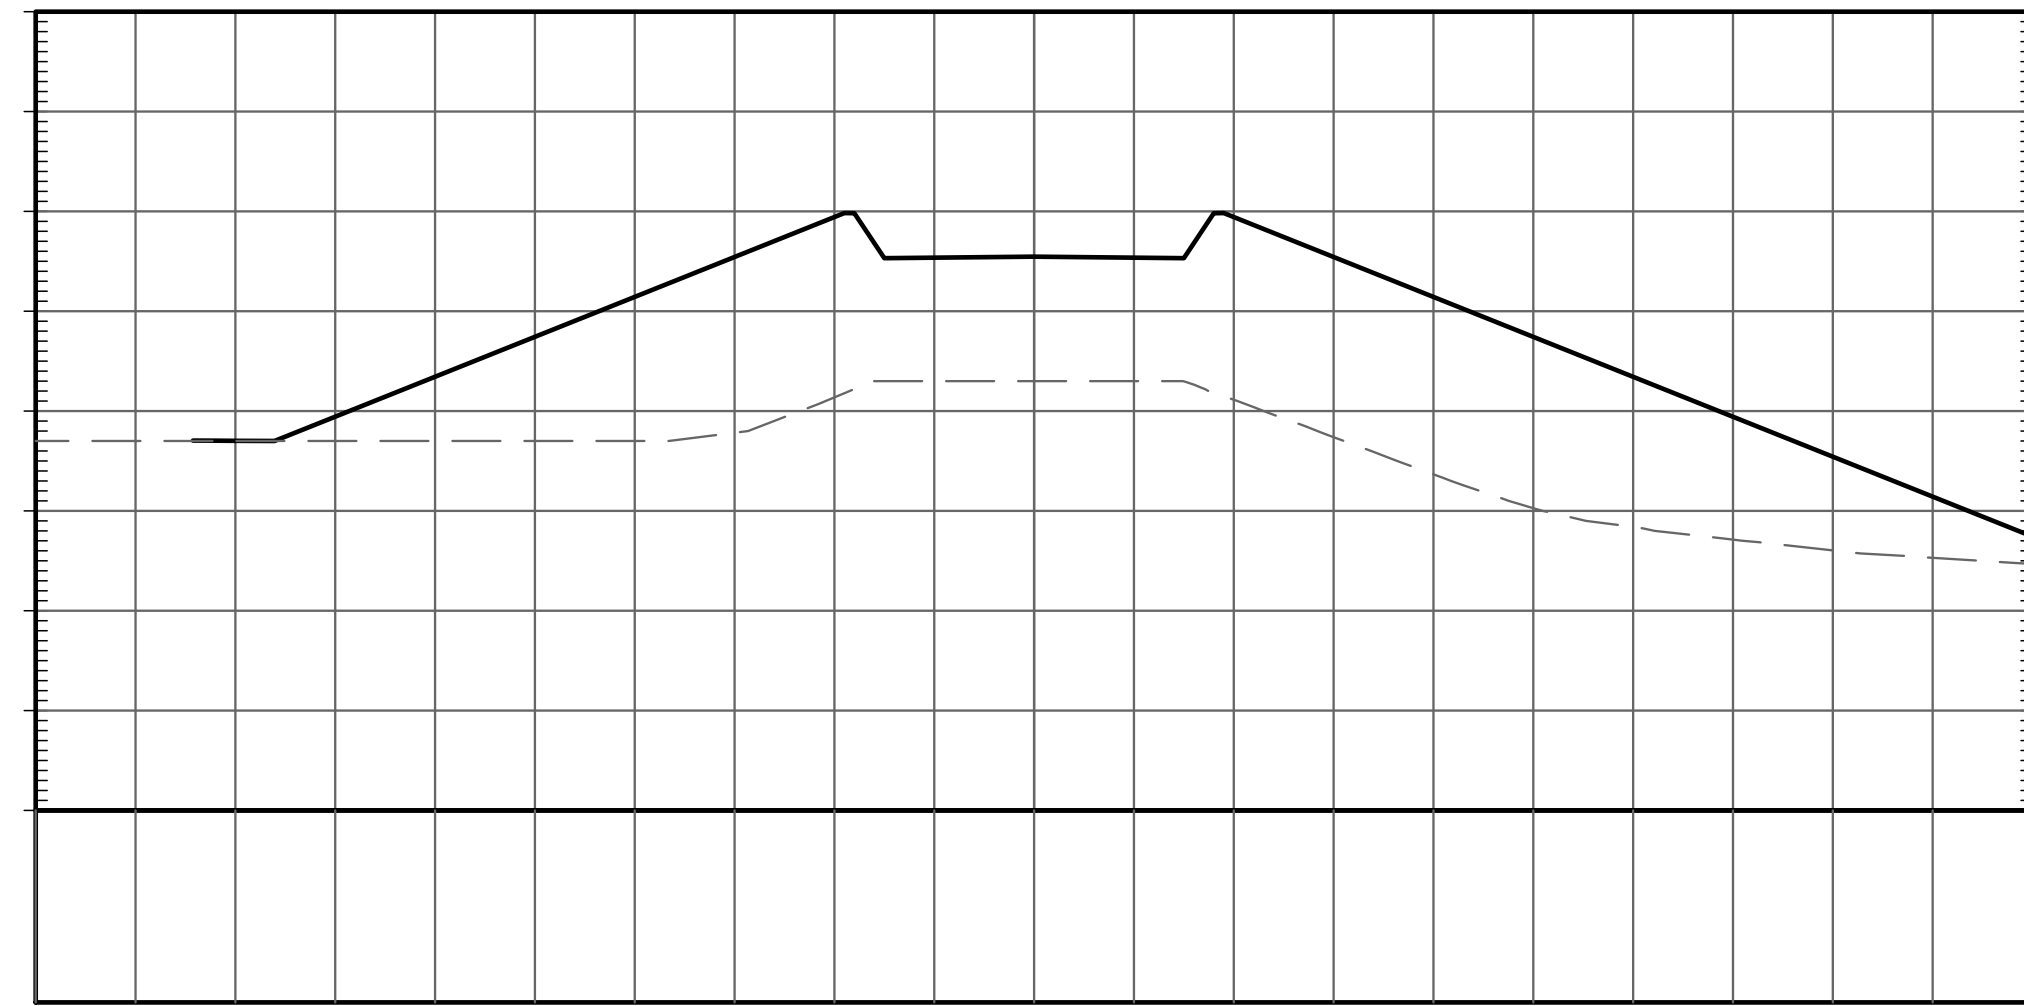

ELEVATIONS ARE REFERENCED TO NORTH AMERICAN VERTICAL DATUM 1988

AERIAL IMAGE FROM PRIOR TO CONSTRUCTION AND IS NOT REPRESENTATIVE OF FINAL PROFILES OR CONDITIONS

<p>Attention:</p> <p>If this scale bar does not measure 1" then drawing is not original scale.</p>	Designed: B J F
	Drawn: B J F
	Checked: J P B
	Approved: J P B
	P.E. No: 40594
GEI Project 2300038	



